


**SURVEYING & SUBDIVIDING  
DEHAVAN, WISCONSIN**



Scale - 1" = 20'  
o = Iron Pipe

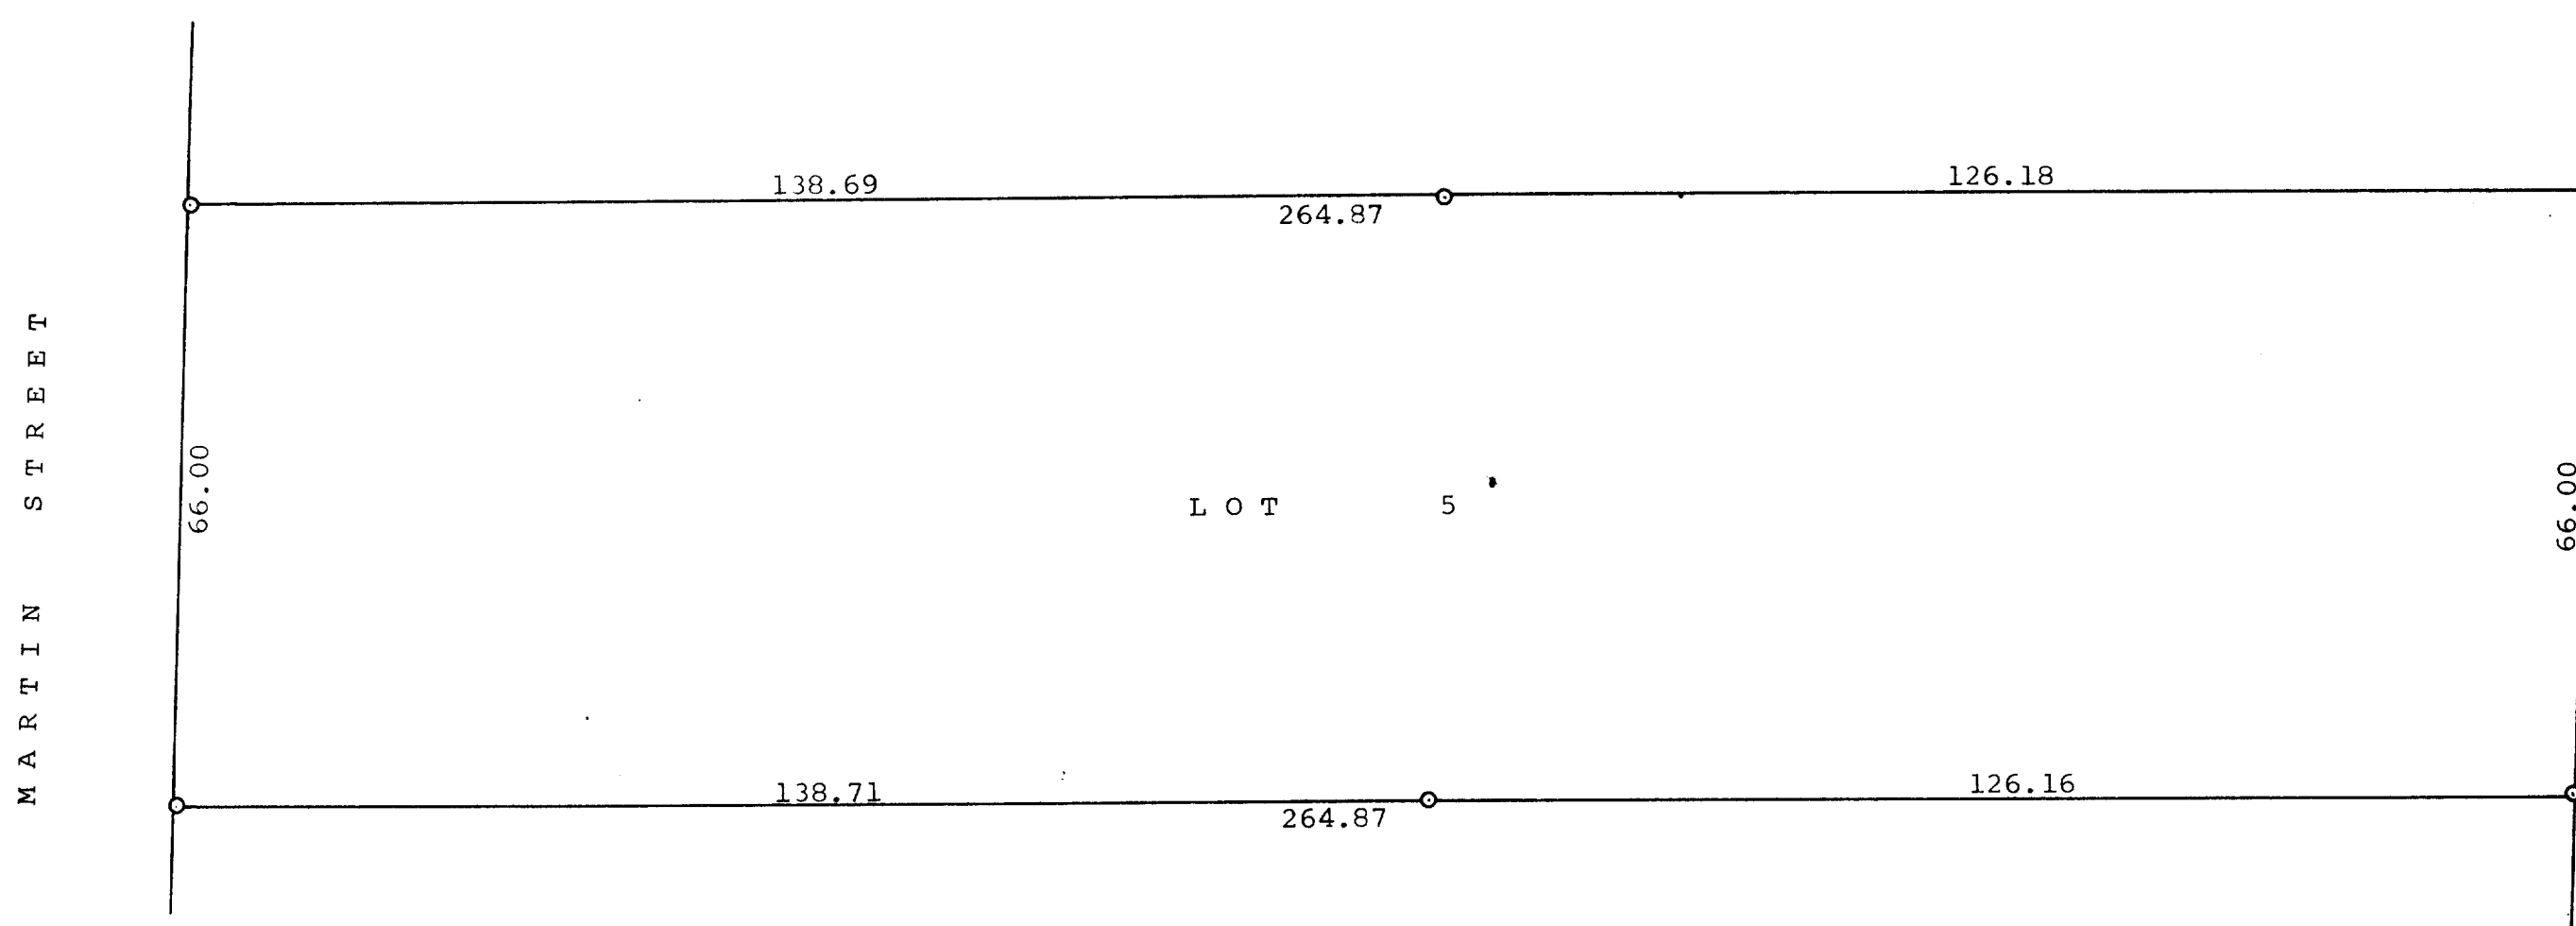

Plat of survey of Lot 5, Block 7 of Citizens Addition  
to the Village of Sharon, Walworth County, Wisconsin.  
September 5, 1967

*George D. Dunham*  
George D. Dunham, Surveyor

8-27

UCA-124