


HAROLD H. KOLB
REGISTERED PROFESSIONAL LAND SURVEYOR
LAKE GENEVA, WISCONSIN

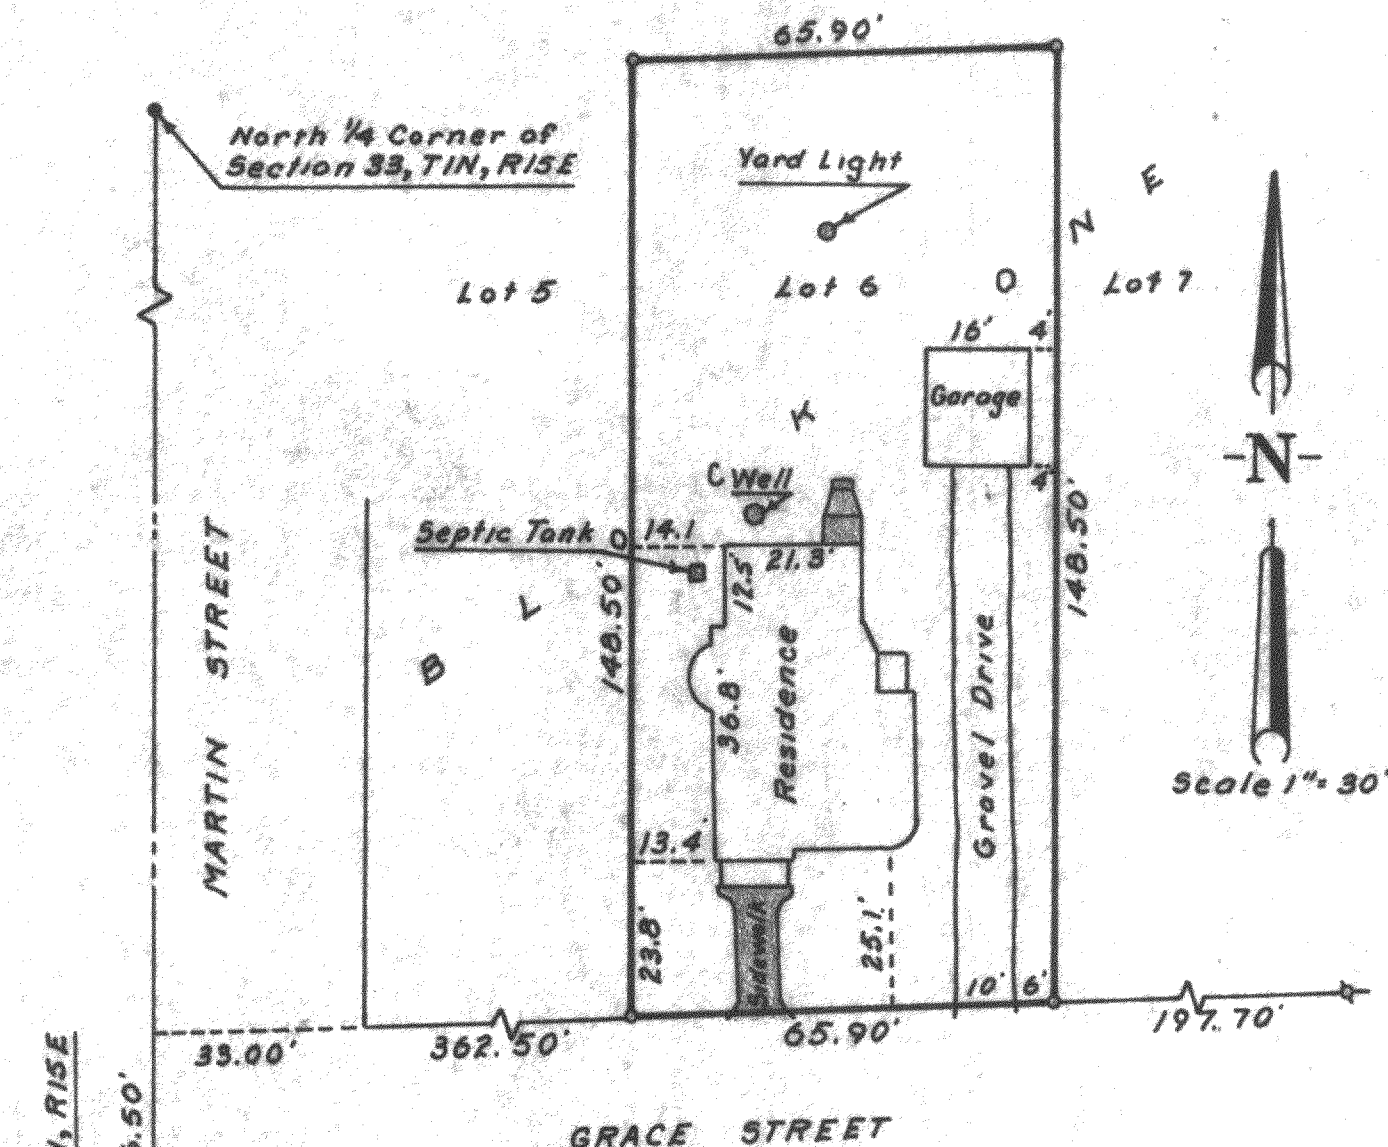

PLAT OF SURVEY OF
Lot 6, Block 1, Hoard's Addition to the Village of Sharon,
Walworth County, Wisconsin.

I certify that I have surveyed the above described property
and that the above plat is an accurate survey and true
representation thereof and correctly shows the exterior
boundary lines and location of buildings and other improve-
ments on said property and the correct measurements thereof.
Dated this 25th day of April 1963.

Harold H. Kolb

Harold H. Kolb, Wisconsin Surveyor, S-187

- - Conc. Monument Found
- - Iron Pipe Found
- - Iron Pipe Placed

8-28