


PLAT OF SURVEY

LOT 1 OF BLOCK 3 OF WISE AND NELSON'S ADDITION TO THE VILLAGE OF SHARON, LOCATED IN THE NORTHWEST 1/4 OF SECTION 33, TOWN 1 NORTH, RANGE 15 EAST, WALWORTH COUNTY, WISCONSIN. ALSO THE NORTH 32 FEET OF UNOPENED BLOSSOM STREET WHICH LIES SOUTH OF SAID LOT 1, BLOCK 3.

ORDERED BY: BEV LONG
CENTURY 21 AFFILIATED
50 W. GENEVA ST.
P.O. BOX 367
WILLIAMS BAY, WI. 53191

OWNER: MICHAEL SMILEY
P.O. BOX 626
SHARON, WI. 53585

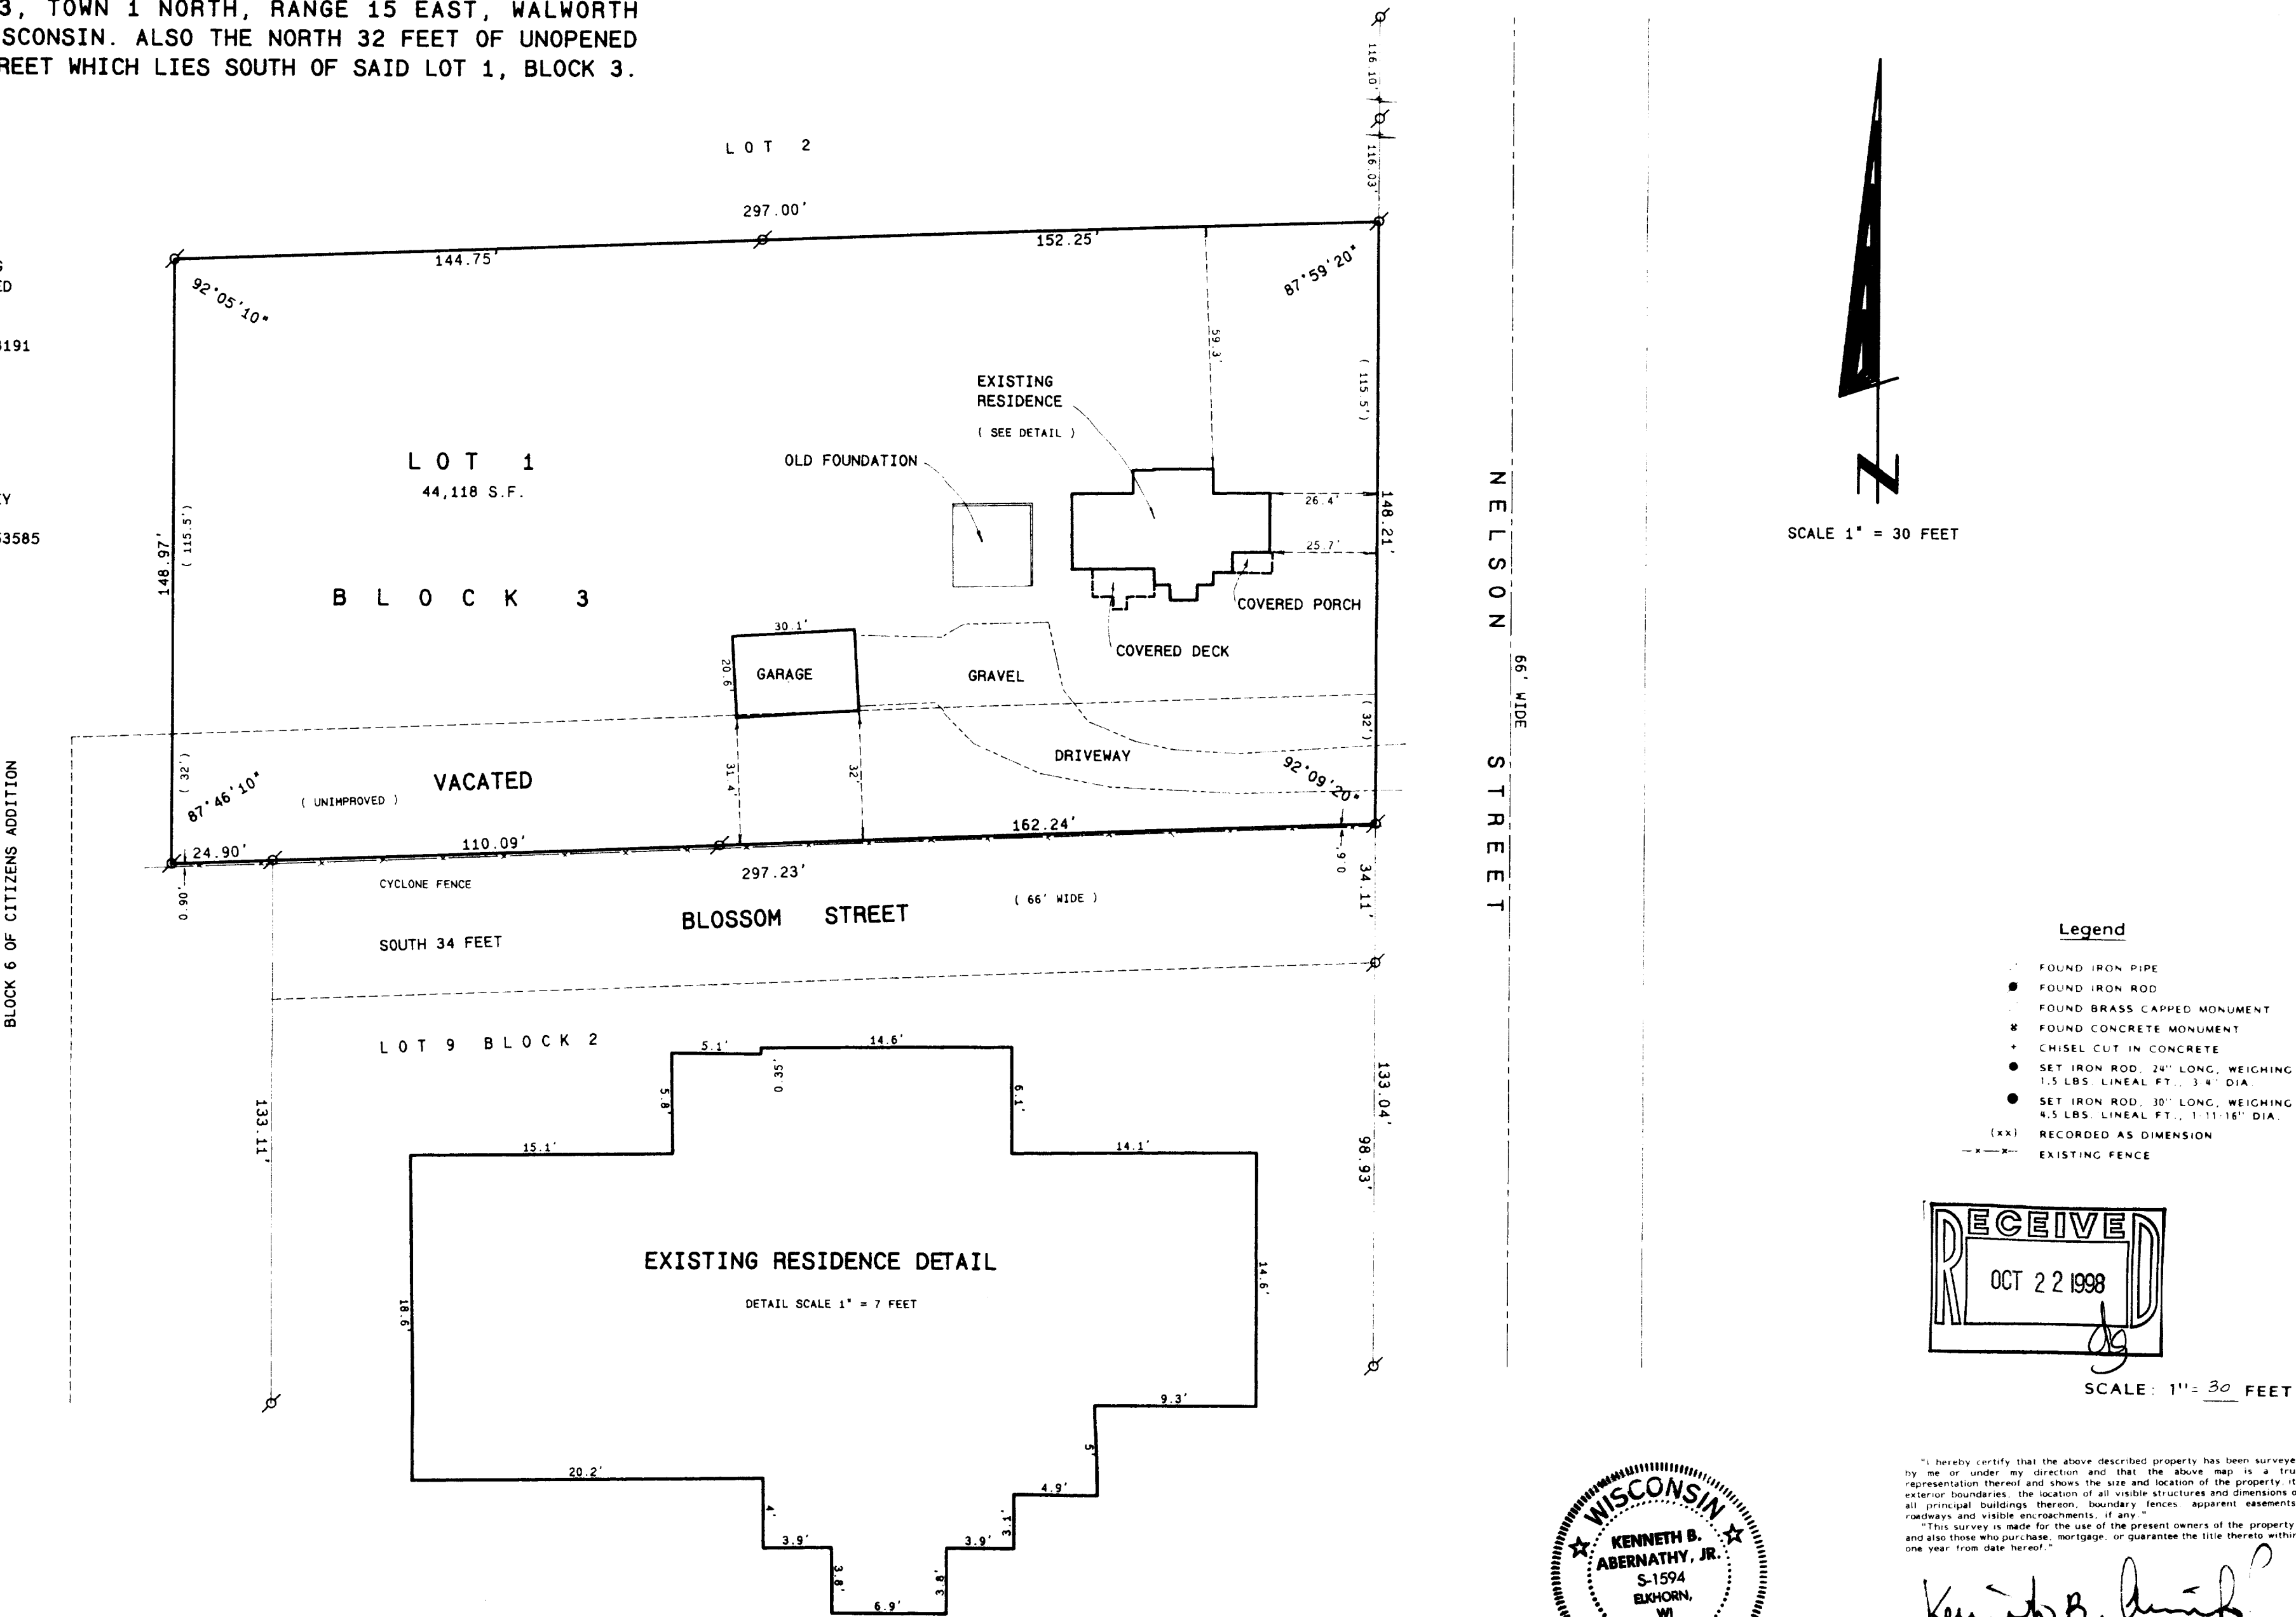

"I hereby certify that the above described property has been surveyed by me or under my direction and that the above map is a true representation thereof and shows the size and location of the property, its exterior boundaries, the location of all visible structures and dimensions of all principal buildings thereon, boundary fences, apparent easements, roadways and visible encroachments, if any."

"This survey is made for the use of the present owners of the property, and also those who purchase, mortgage, or guarantee the title thereto within one year from date hereof."

Kenneth B. Abernathy, Jr.

KENNETH B. ABERNATHY, JR.
WISCONSIN REGISTERED LAND SURVEYOR,
S-1594

Date: JUNE 14TH, 1998 Job No. 98.605