


ABELL
SURVEYING & MAPPING
DELAVAN, WISCONSIN 53115
262-728-6737

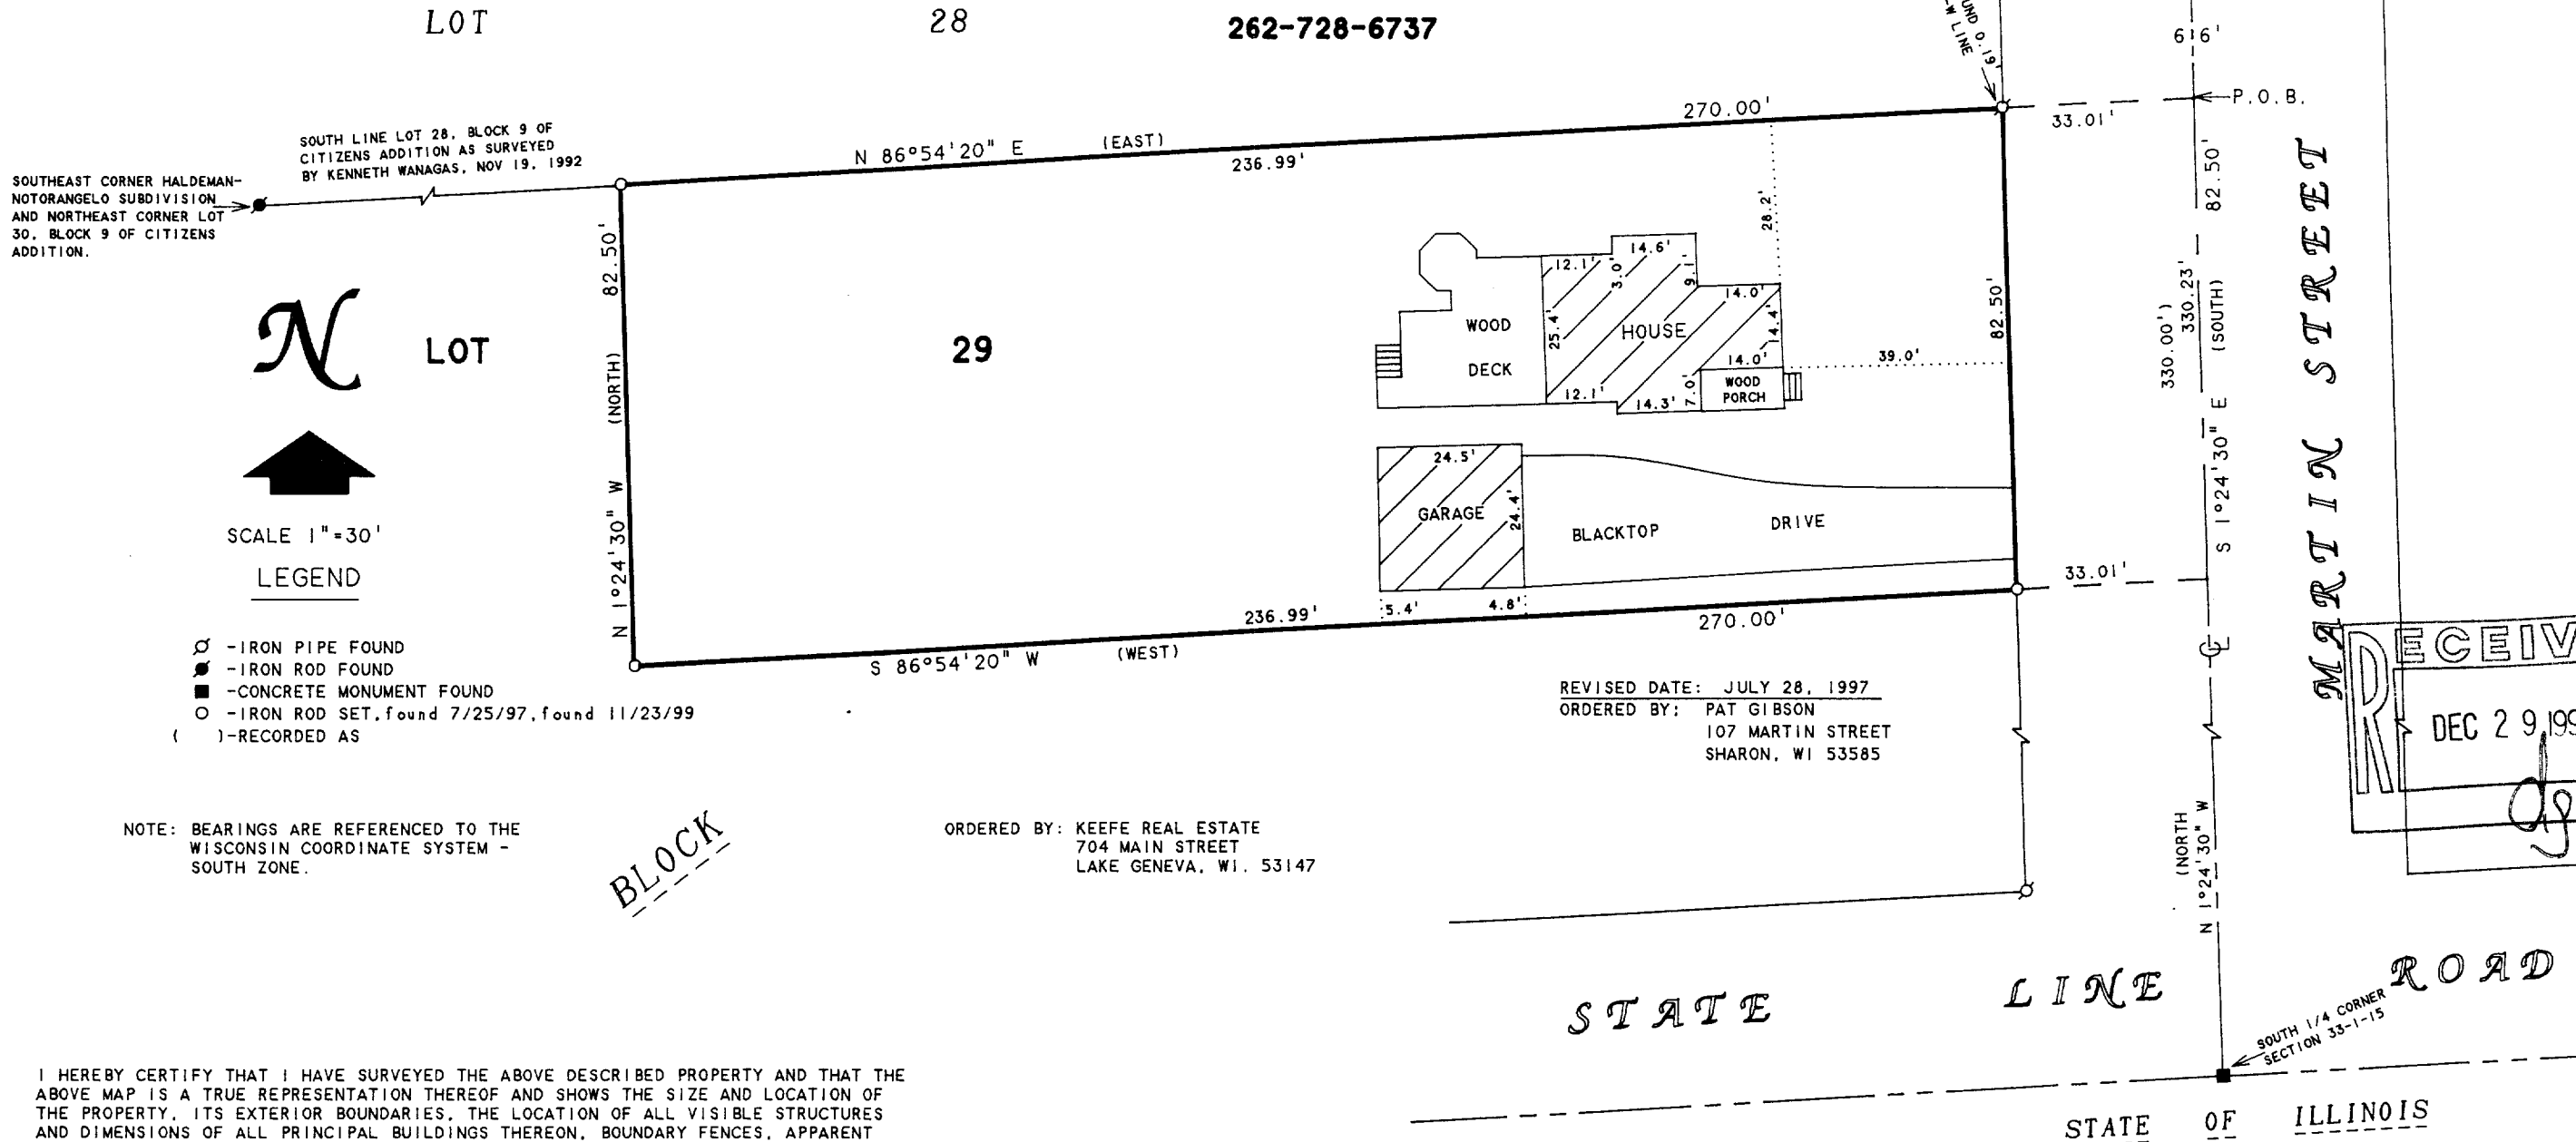

I HEREBY CERTIFY THAT I HAVE SURVEYED THE ABOVE DESCRIBED PROPERTY AND THAT THE ABOVE MAP IS A TRUE REPRESENTATION THEREOF AND SHOWS THE SIZE AND LOCATION OF THE PROPERTY, ITS EXTERIOR BOUNDARIES, THE LOCATION OF ALL VISIBLE STRUCTURES AND DIMENSIONS OF ALL PRINCIPAL BUILDINGS THEREON, BOUNDARY FENCES, APPARENT EASEMENTS, ROADWAYS AND VISIBLE ENCROACHMENTS, IF ANY, TO THE BEST OF MY KNOWLEDGE AND BELIEF.

THIS SURVEY IS MADE FOR THE USE OF THE PRESENT OWNERS OF THE PROPERTY, AND ALSO THOSE WHO PURCHASE, MORTGAGE, OR GUARANTEE THE TITLE THERETO WITHIN ONE (1) YEAR FROM DATE HEREON.

David F. Abell
DAVID F. ABELL
WISCONSIN REGISTERED LAND SURVEYOR, S-1596

October 5, 1993

DATE: October 5, 1993
JOB NUMBER - 93218
NOTE: THIS IS NOT A CERTIFIED COPY UNLESS SEALED.

RECEIVED: NOVEMBER 23, 1999
ORDERED BY: RE/MAX-GENEVA REALTY
101 BROAD STREET
LAKE GENEVA, WI 53147

ORDERED BY: KEEFE REAL ESTATE
704 MAIN STREET
LAKE GENEVA, WI. 53147

REVISED DATE: JULY 28, 1997
ORDERED BY: PAT GIBSON
107 MARTIN STREET
SHARON, WI 53585

PLAT OF SURVEY OF

Beginning at a point 20 rods N. of the SE corner of the SW 1/4 of Section 33, T. 1 N., R. 15 E., Village of Sharon, Walworth County, Wisconsin, and in the center of the highway running S. 5 rods (82.5 feet); thence W. 16 rods and 6 ft. (270 feet) thence N. 5 rods (82.5 feet); thence E. 16 rods and 6 ft. (270 feet) to the place of beginning, in the NE corner of Lot 29, Block 9, Citizens Addition to the Village of Sharon, Walworth County, Wisconsin.

Tax Key No. UCA 00170

008-333
UCA-170