

ABELL
SURVEYING & MAPPING

1140 SEQUOIA STREET • DELAVAN, WISCONSIN 53115
262-728-6737

GRACE STREET

MARTIN STREET

PROSPECT STREET

BLOCK

BLOCK

LOT 1



SCALE 1" = 30'
LEGEND

- - IRON PIPE FOUND
- - CONCRETE MONUMENT FOUND
- ⊠ - CUT CROSS IN CONCRETE SIDEWALK FOUND
- WP - WOOD PORCH
- () - RECORDED AS
- CS - CONCRETE STOOP


AS SURVEYED BY GEORGE T. DUNHAM
JUNE 2, 1986

NOTE: BEARINGS ARE REFERENCED TO
EXISTING SURVEY RECORDS.

ORDERED BY: RIEMER LAW OFFICE
P.O. BOX 425
DELAVAN, WI 53115

PLAT OF SURVEY OF

LOT 6, BLOCK 3, HOARDS ADDITION TO THE VILLAGE
OF SHARON, WALWORTH COUNTY, WISCONSIN.

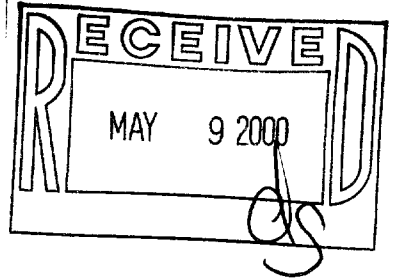

RAILROAD RIGHT-OF-WAY

I HEREBY CERTIFY THAT I HAVE SURVEYED THE ABOVE DESCRIBED PROPERTY AND THAT THE ABOVE MAP IS A TRUE REPRESENTATION THEREOF AND SHOWS THE SIZE AND LOCATION OF THE PROPERTY, ITS EXTERIOR BOUNDARIES, THE LOCATION OF ALL VISIBLE STRUCTURES AND DIMENSIONS OF ALL PRINCIPAL BUILDINGS THEREON, BOUNDARY FENCES, APPARENT EASEMENTS, ROADWAYS AND VISIBLE ENCROACHMENTS, IF ANY, TO THE BEST OF MY KNOWLEDGE AND BELIEF.

THIS SURVEY IS MADE FOR THE USE OF THE PRESENT OWNERS OF THE PROPERTY, AND ALSO THOSE WHO PURCHASE, MORTGAGE, OR GUARANTEE THE TITLE THERETO WITHIN ONE (1) YEAR FROM DATE HEREON.

David F. Abell

DAVID F. ABELL
WISCONSIN REGISTERED LAND SURVEYOR, S-1596

March 28, 2000

DATE: _____ JOB NUMBER - 00033
NOTE: THIS IS NOT A CERTIFIED COPY UNLESS SEALED.

UAA-14

008-339