

ABELL
SURVEYING & MAPPING

1140 SEQUOIA STREET • DELAVAN, WISCONSIN 53115
262-728-6737

LOT 2

PLAT OF SURVEY OF

LOT 4, BLOCK 4, CITIZENS ADDITION TO THE VILLAGE OF
SHARON, WALWORTH COUNTY, WISCONSIN.

ORDERED BY: ELAINE BAIN
234 WALWORTH STREET
SHARON, WI 53585

215.34' (216')

LOT 3

212.46' (212.50')

GRAVEL

DRIVE

GARAGE

HOUSE

WP

WP

LOT 4

LOT 33

LOT 5

WALWORTH STREET

SET CUTCROSS IN CONCRETE SIDEWALK
AT CORNER, SET 1" DIA. IRON PIPE
1.00' EAST OF CUTCROSS ON LINE.



SCALE 1"=30'

LEGEND

- ⊙ - IRON PIPE FOUND
- - IRON PIPE SET
- WP - WOOD PORCH
- - STORM SEWER GRATE
- () - RECORDED AS


I, DAVID F. ABELL, DO HEREBY CERTIFY THAT I HAVE SURVEYED THE PROPERTY HEREON
DESCRIBED ACCORDING TO THE OFFICIAL RECORDS AND THAT THE PLAT HEREON IS A
CORRECT REPRESENTATION OF THE PROPERTY LINES TO THE BEST OF MY KNOWLEDGE AND
BELIEF.

David F. Abell

DAVID F. ABELL
WISCONSIN REGISTERED LAND SURVEYOR, S-1596

April 14, 2000

DATE: _____ JOB NUMBER - 00037
NOTE: THIS IS NOT A CERTIFIED COPY UNLESS SEALED.

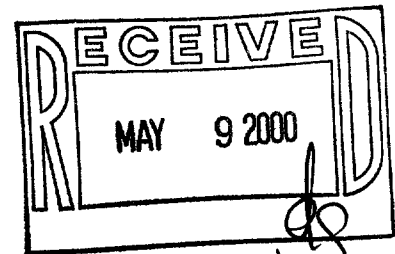

UCA-47

008-340