


DUNHAM SURVEYING, S. C.
SURVEYING & SUBDIVIDING
DELAVER, WISCONSIN 53115

N

Scale - 1" = 20'

- = Iron Rod Found
- ⊘ = 3/4" Iron Pipe Found
- ⊘ = 1" Iron Pipe Set
- ⊘ = 3/4" Iron Pipe Set

Survey ordered by:
Century 21 Affiliated
50 West Geneva Street
Williams Bay, WI 53191

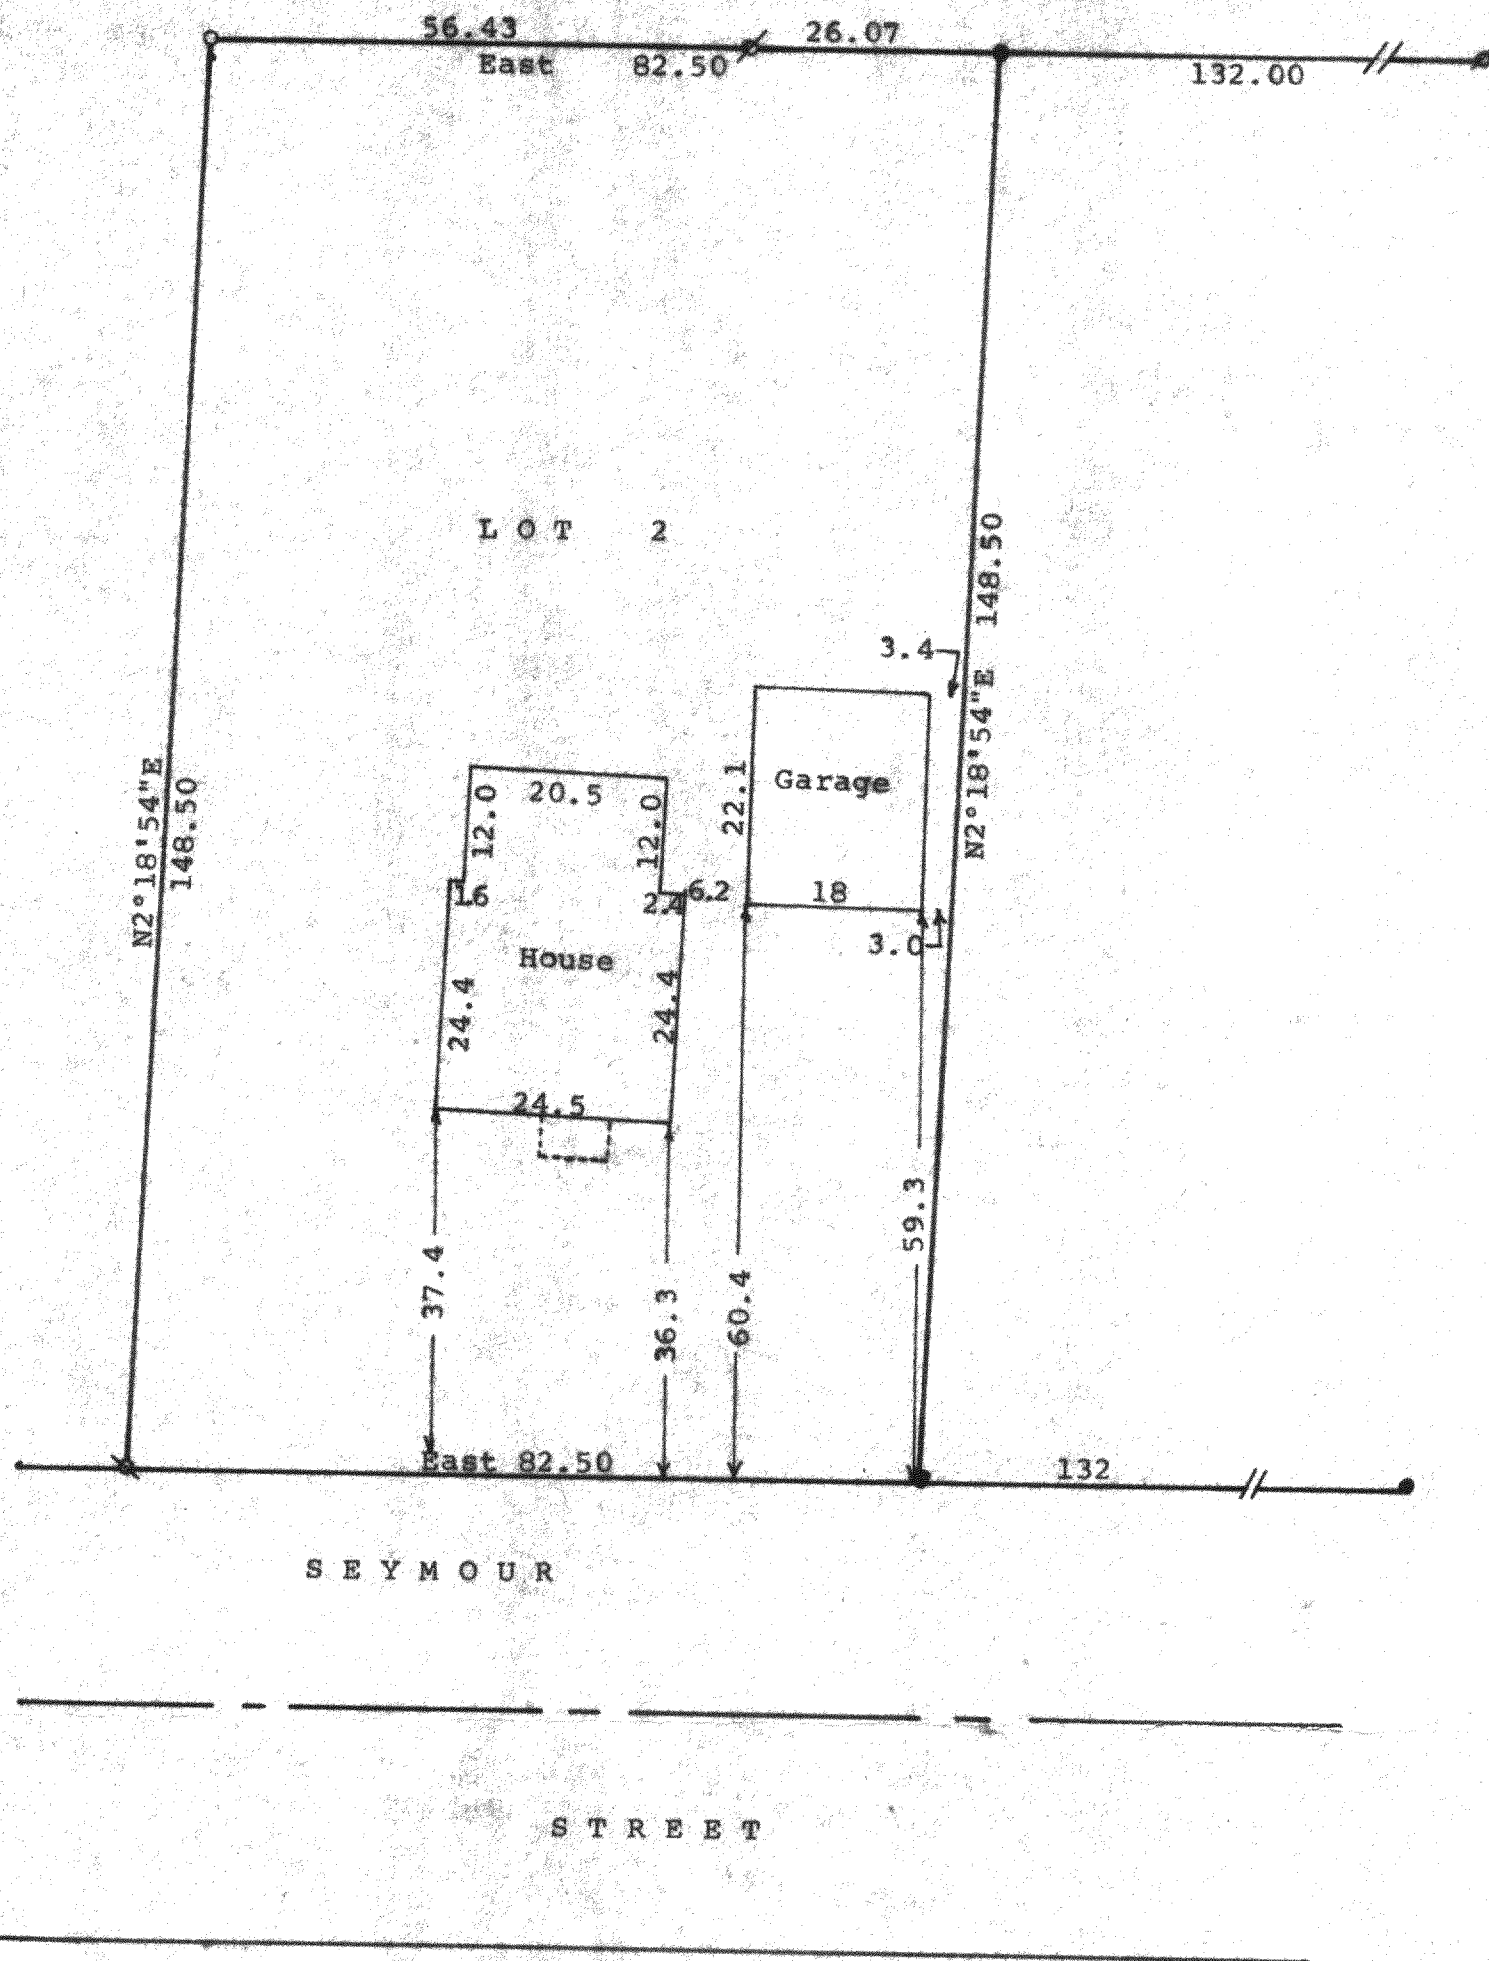

STATE OF WISCONSIN)
COUNTY OF WALWORTH) SS

I, George T. Dunham, Surveyor, certify that I have surveyed the property described as follows:

Lot 2 in Block 1 of Wise and Nelson's Addition to the Village of Sharon, Walworth County, Wisconsin.

and that the map shown above is a correct representation thereof and shows the size and location of the property, its exterior boundaries, the location of all visible structures and dimensions of all principal buildings thereon, boundary fences, apparent easements, roadways and visible encroachments, if any, and that I have surveyed the property hereon described according to the official records, to the best of my knowledge and belief.

July 24, 2000

George T. Dunham
George T. Dunham, Surveyor

