


ABELL SURVEYING & MAPPING

1140 SEQUOIA STREET • DELAVAN, WISCONSIN 53115
262-728-6737

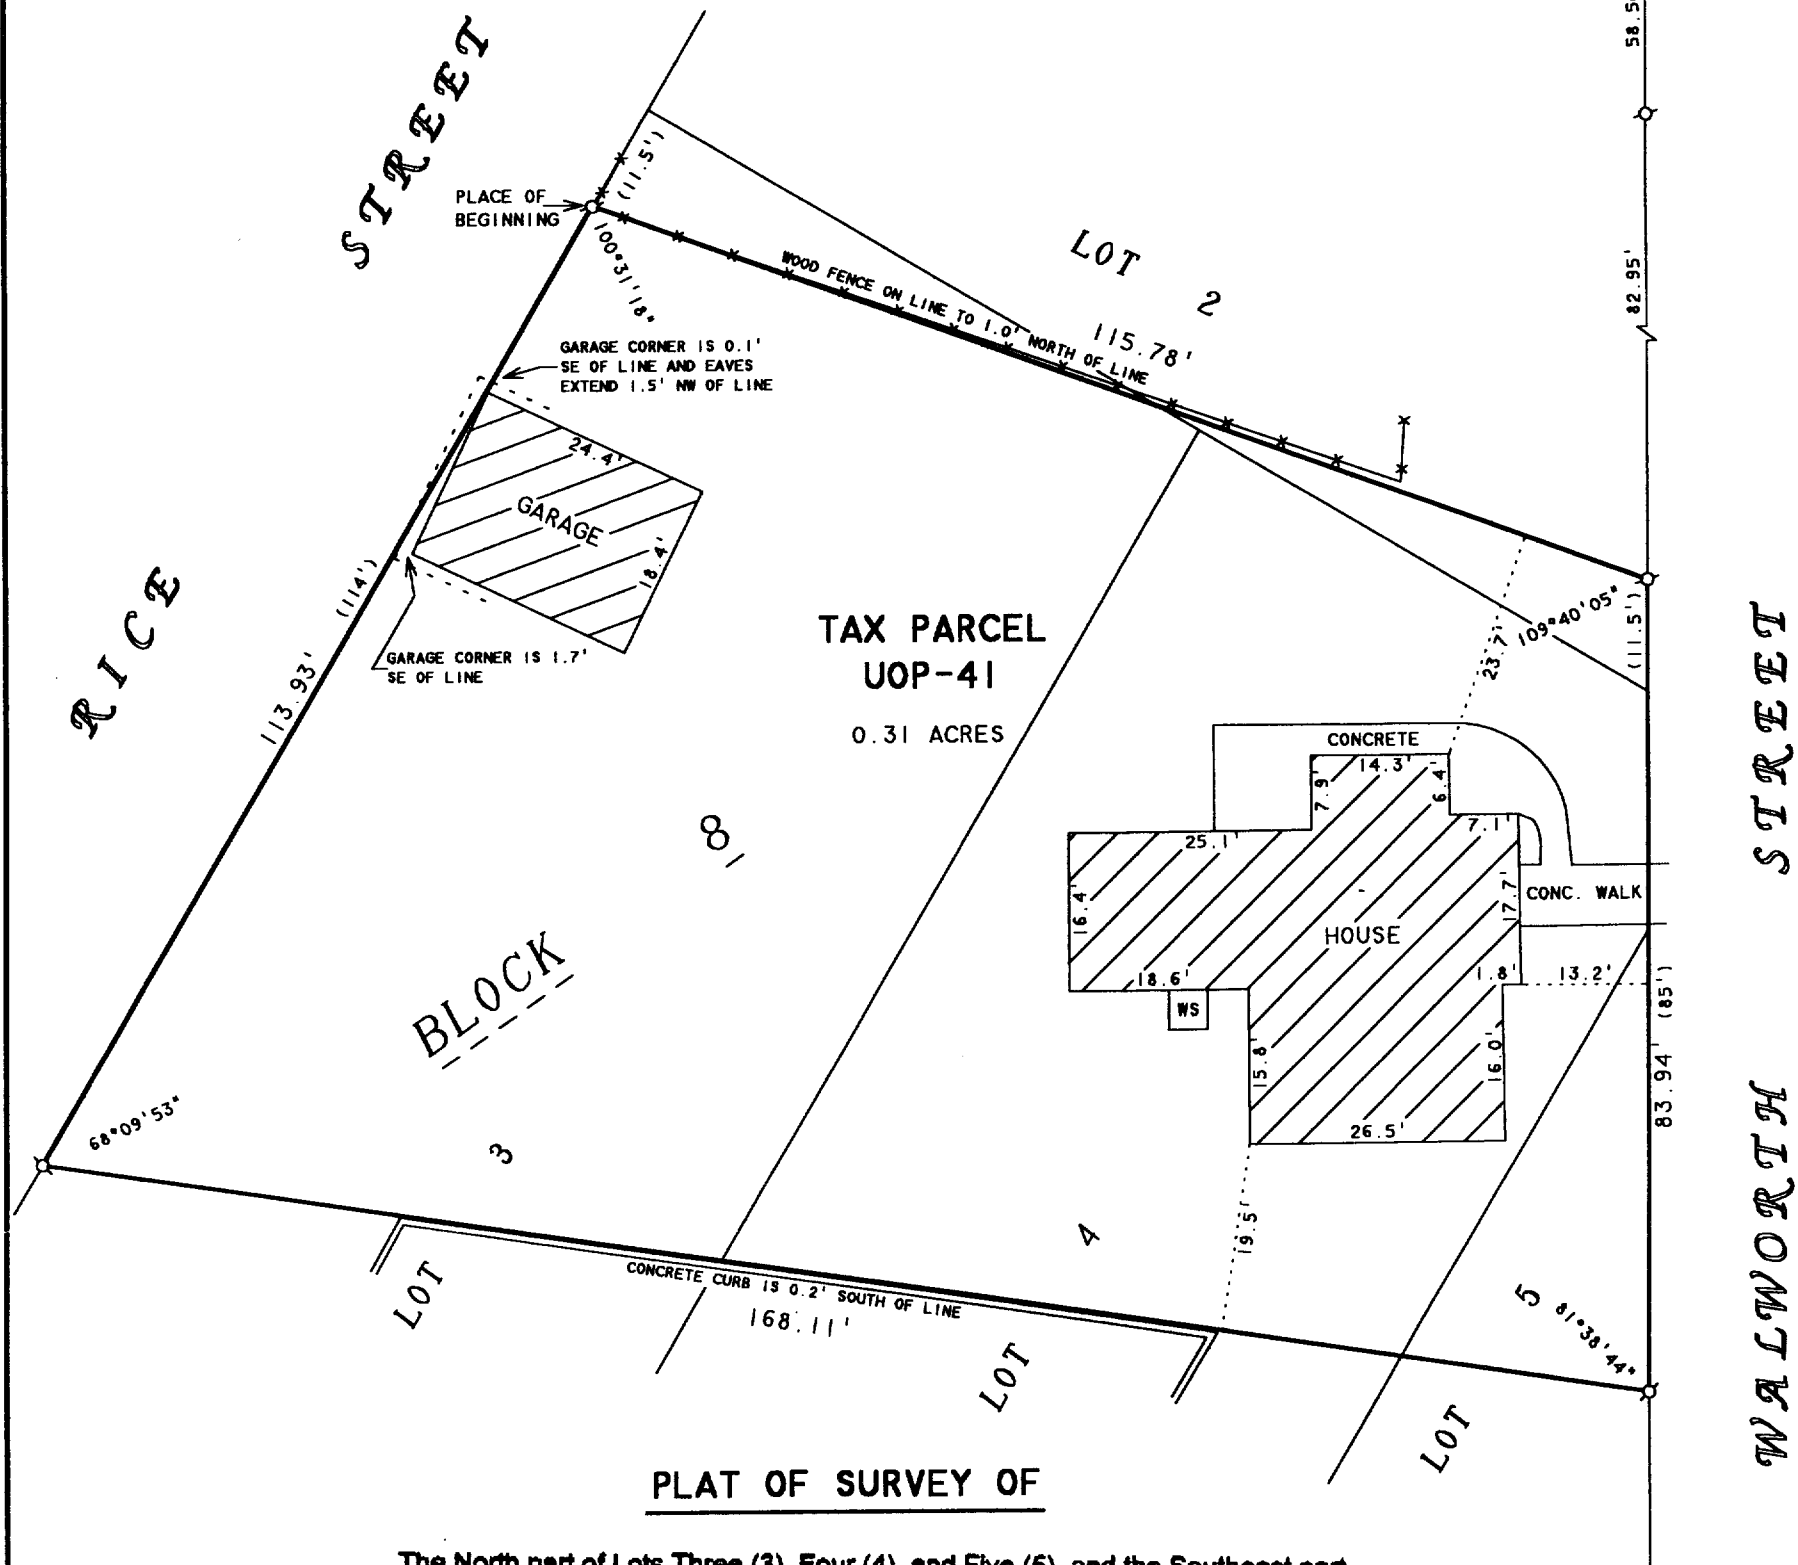

The North part of Lots Three (3), Four (4), and Five (5), and the Southeast part of Lot Two (2) in Block Eight (8) of the Village of Sharon, as per plat thereof recorded in the office of the Register of Deeds in and for the County of Walworth and State of Wisconsin, and more particularly described as follows, to-wit: Beginning at a point on the West line of said Lot Number Three (3), Eleven and one-half (11 1/2) feet Southerly from the Northwest corner thereof, thence Easterly, across Lots Number Three (3) and Two (2), to a point on the East line of said Lot Number Two (2), Eleven and one-half (11 1/2) feet from the Southeast corner of said Lot Number Two (2); thence South, along the East line of said Lots Two (2), Four (4), and Five (5), Eighty-five (85) feet; thence Westerly, across said Lots Three (3), Four (4), and Five (5) to a point on the West line of said Lot Number Three (3), One Hundred and Fourteen (114) feet Southerly from place of beginning; thence Northerly, along said West line, One Hundred Fourteen (114) feet to place of beginning.

ORDERED BY: KEEFE REAL ESTATE
1155 E. GENEVA STREET
DELAVAN, WI 53115

N



SCALE 1"=20'

LEGEND

- ✕ - IRON PIPE FOUND
- ✕ - WOOD FENCE
- WS - WOOD STOOP
- () - RECORDED AS

I HEREBY CERTIFY THAT I HAVE SURVEYED THE ABOVE DESCRIBED PROPERTY AND THAT THE ABOVE MAP IS A TRUE REPRESENTATION THEREOF AND SHOWS THE SIZE AND LOCATION OF THE PROPERTY, ITS EXTERIOR BOUNDARIES, THE LOCATION OF ALL VISIBLE STRUCTURES AND DIMENSIONS OF ALL PRINCIPAL BUILDINGS THEREON, BOUNDARY FENCES, APPARENT EASEMENTS, ROADWAYS AND VISIBLE ENCROACHMENTS, IF ANY, TO THE BEST OF MY KNOWLEDGE AND BELIEF.

THIS SURVEY IS MADE FOR THE USE OF THE PRESENT OWNERS OF THE PROPERTY, AND ALSO THOSE WHO PURCHASE, MORTGAGE, OR GUARANTEE THE TITLE THERETO WITHIN ONE (1) YEAR FROM DATE HEREON.

David F. Abell

DAVID F. ABELL
WISCONSIN REGISTERED LAND SURVEYOR, S-1596

January 6, 2005

DATE: January 6, 2005 JOB NUMBER - 05001
NOTE: THIS IS NOT A CERTIFIED COPY UNLESS SEALED.

MAR 23 2005

UOP 00041

008-405