



GEORGE T. DUNHAM
SURVEYING & SUBDIVIDING
DELAVER, WISCONSIN

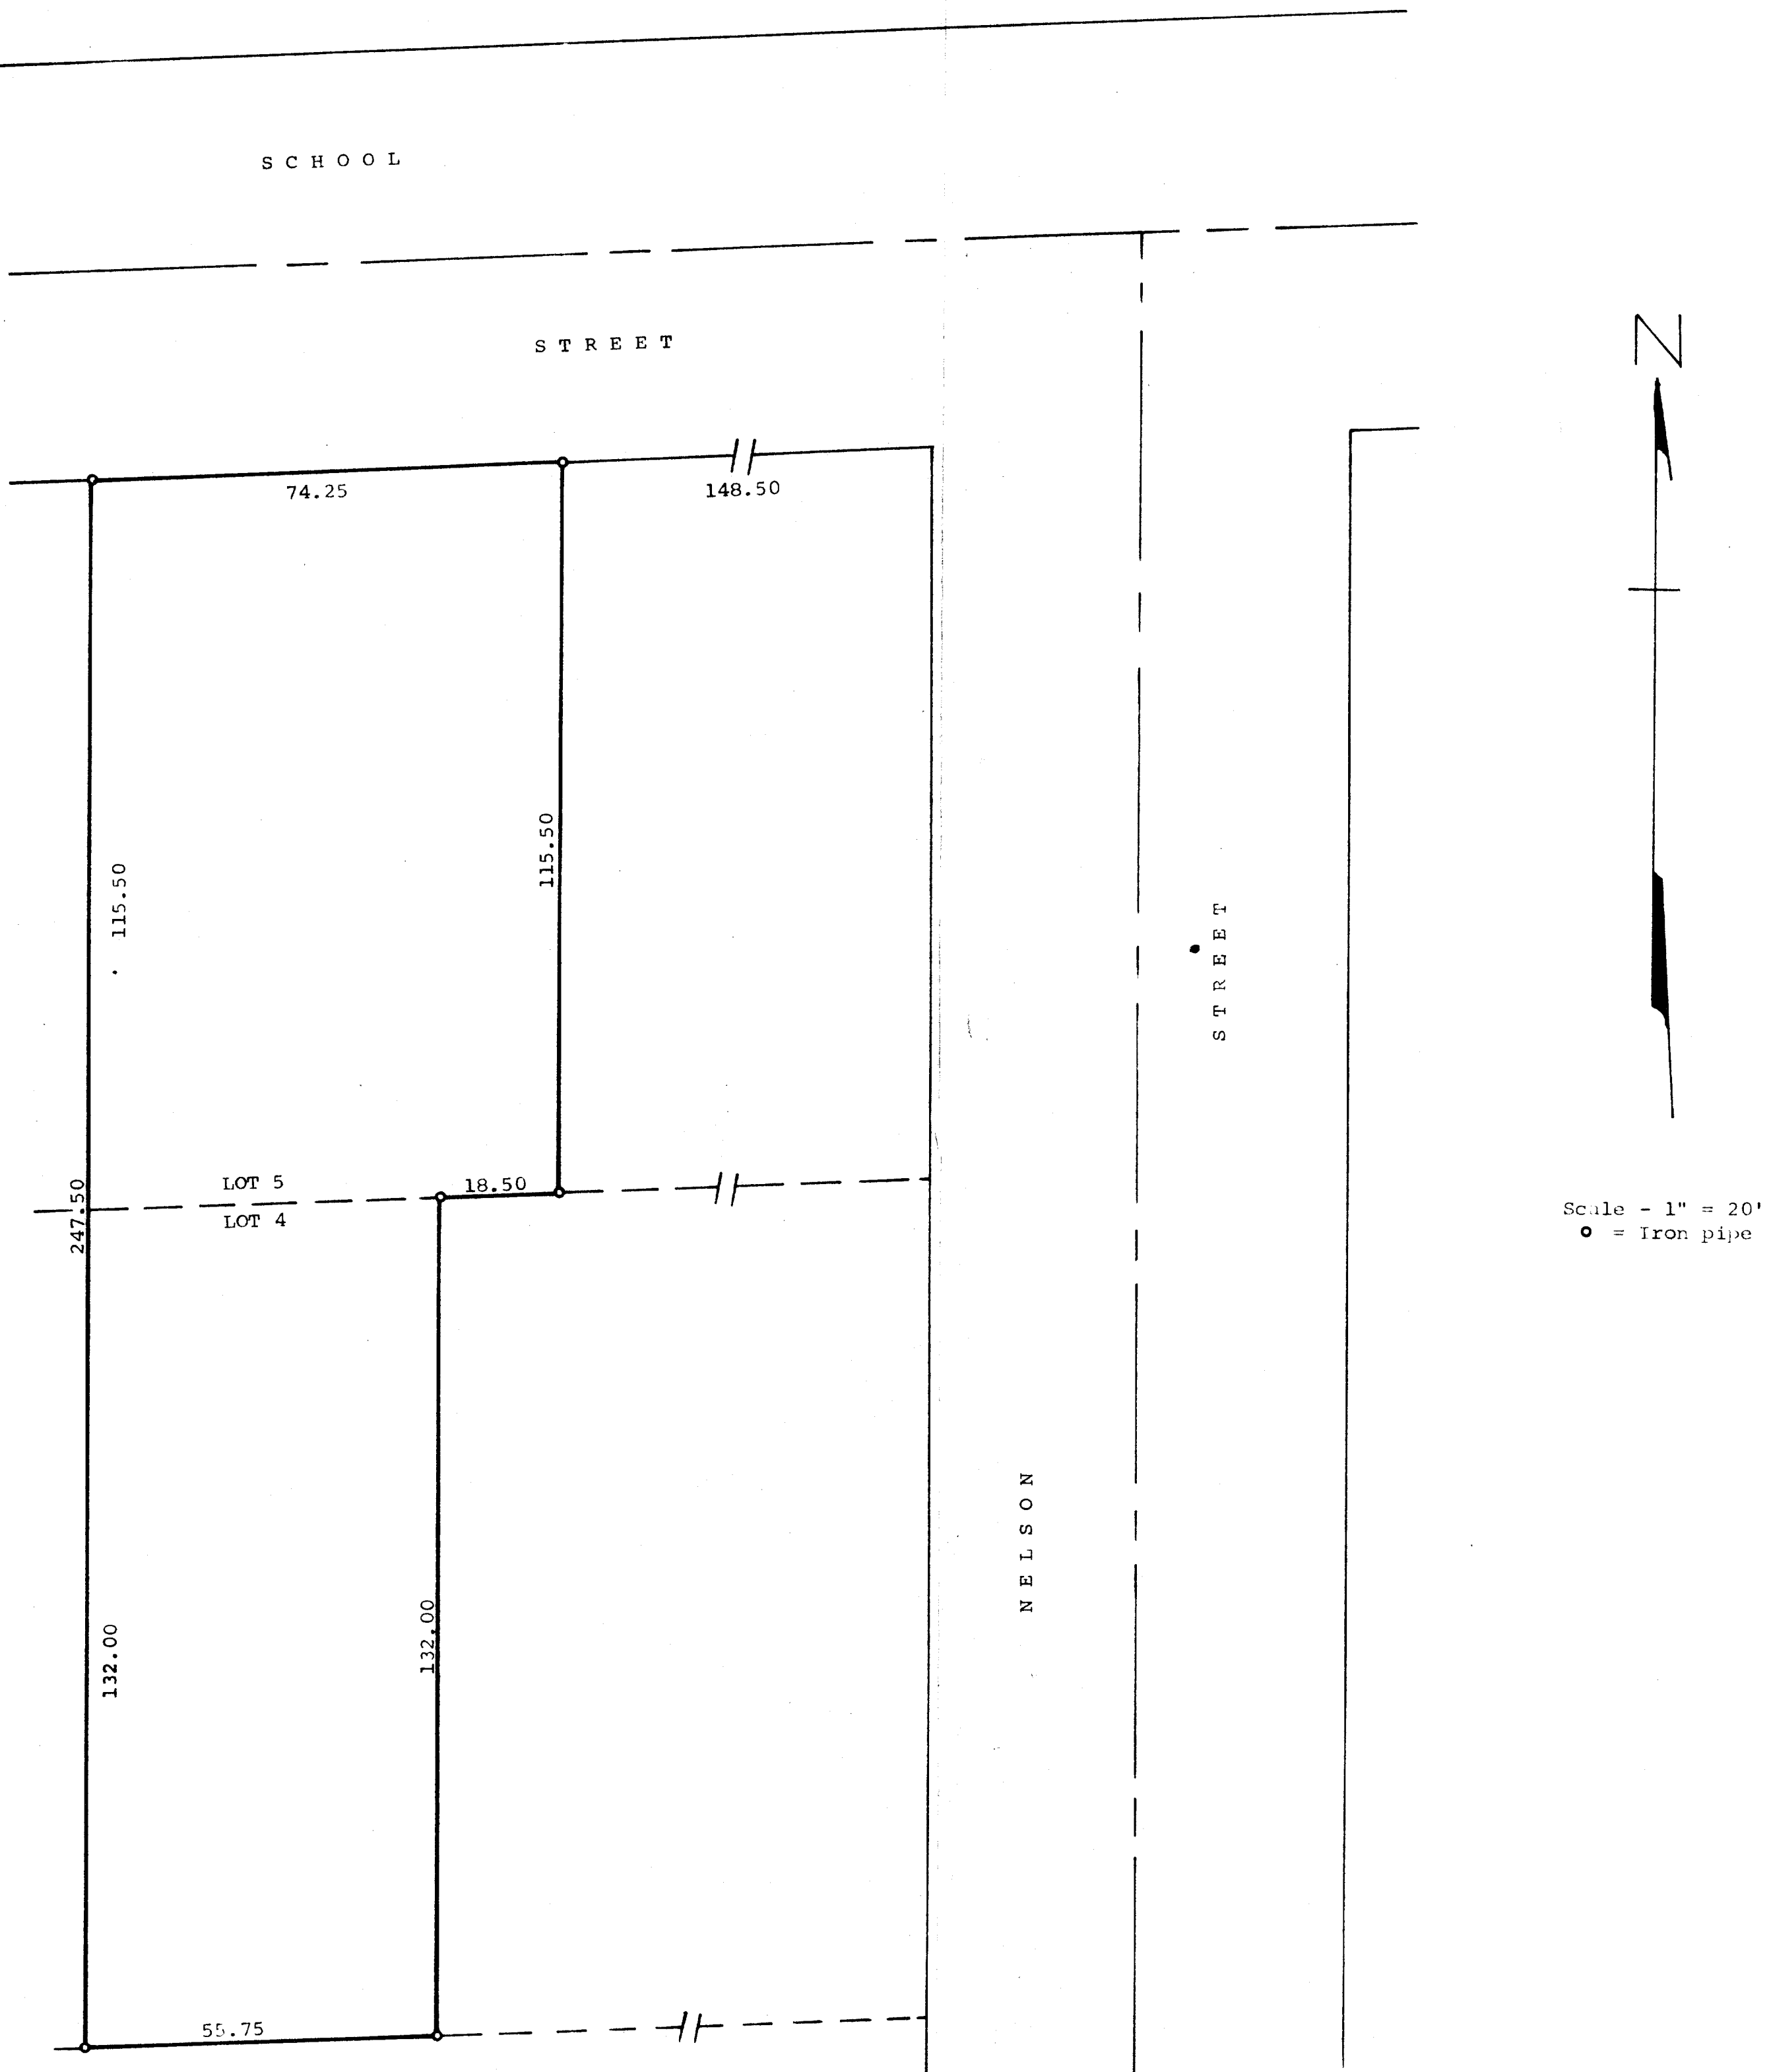

Plat of survey of parts of Lot 4 and Lot 5, Block 3
of Wise and Nelson's Addition to the Village of
Sharon, Walworth County, Wisconsin.
July 11, 1972

George T. Dunham
George T. Dunham, Surveyor

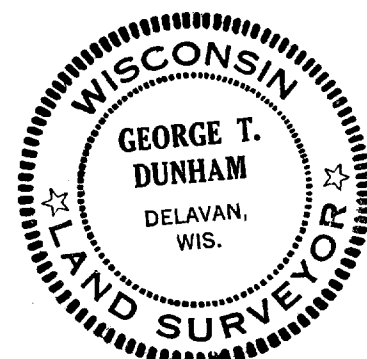

WWDA-28

8-49