


GEORGE T. DUNHAM
SURVEYING & SUBDIVIDING
DELAVER, WISCONSIN

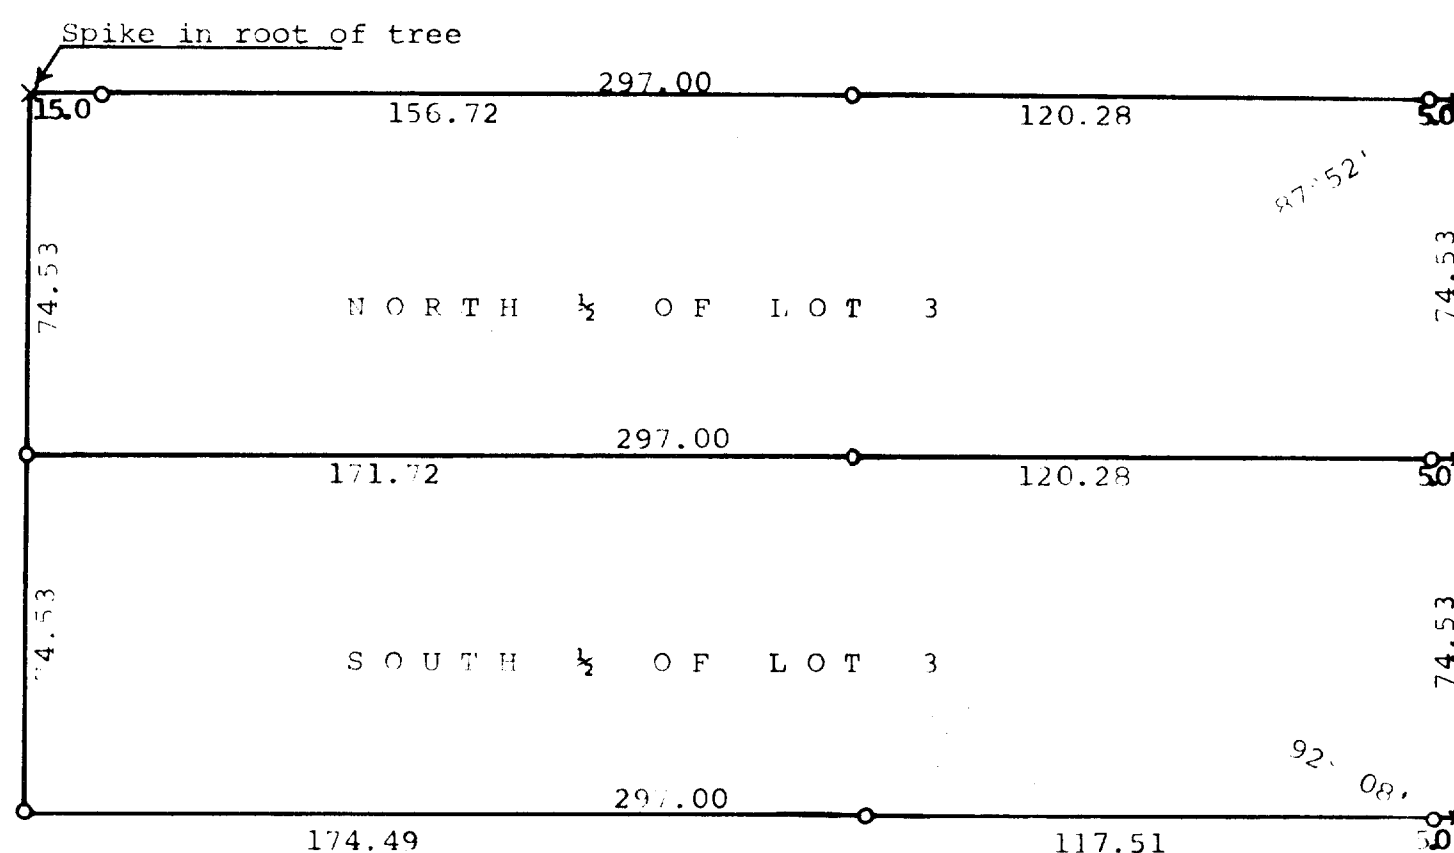

Scale - 1" = 40'
o = Iron Pipe
X = Cross in Concrete

Plat of survey of Lot 3, Block 10 of Citizen's
Addition, a subdivision located in the Village
of Sharon, Walworth County, Wisconsin.
April 25, 1973

George T. Dunham, Surveyor

