


GEORGE T. DUNHAM
SURVEYING & SUBDIVIDING
DELAVER, WISCONSIN

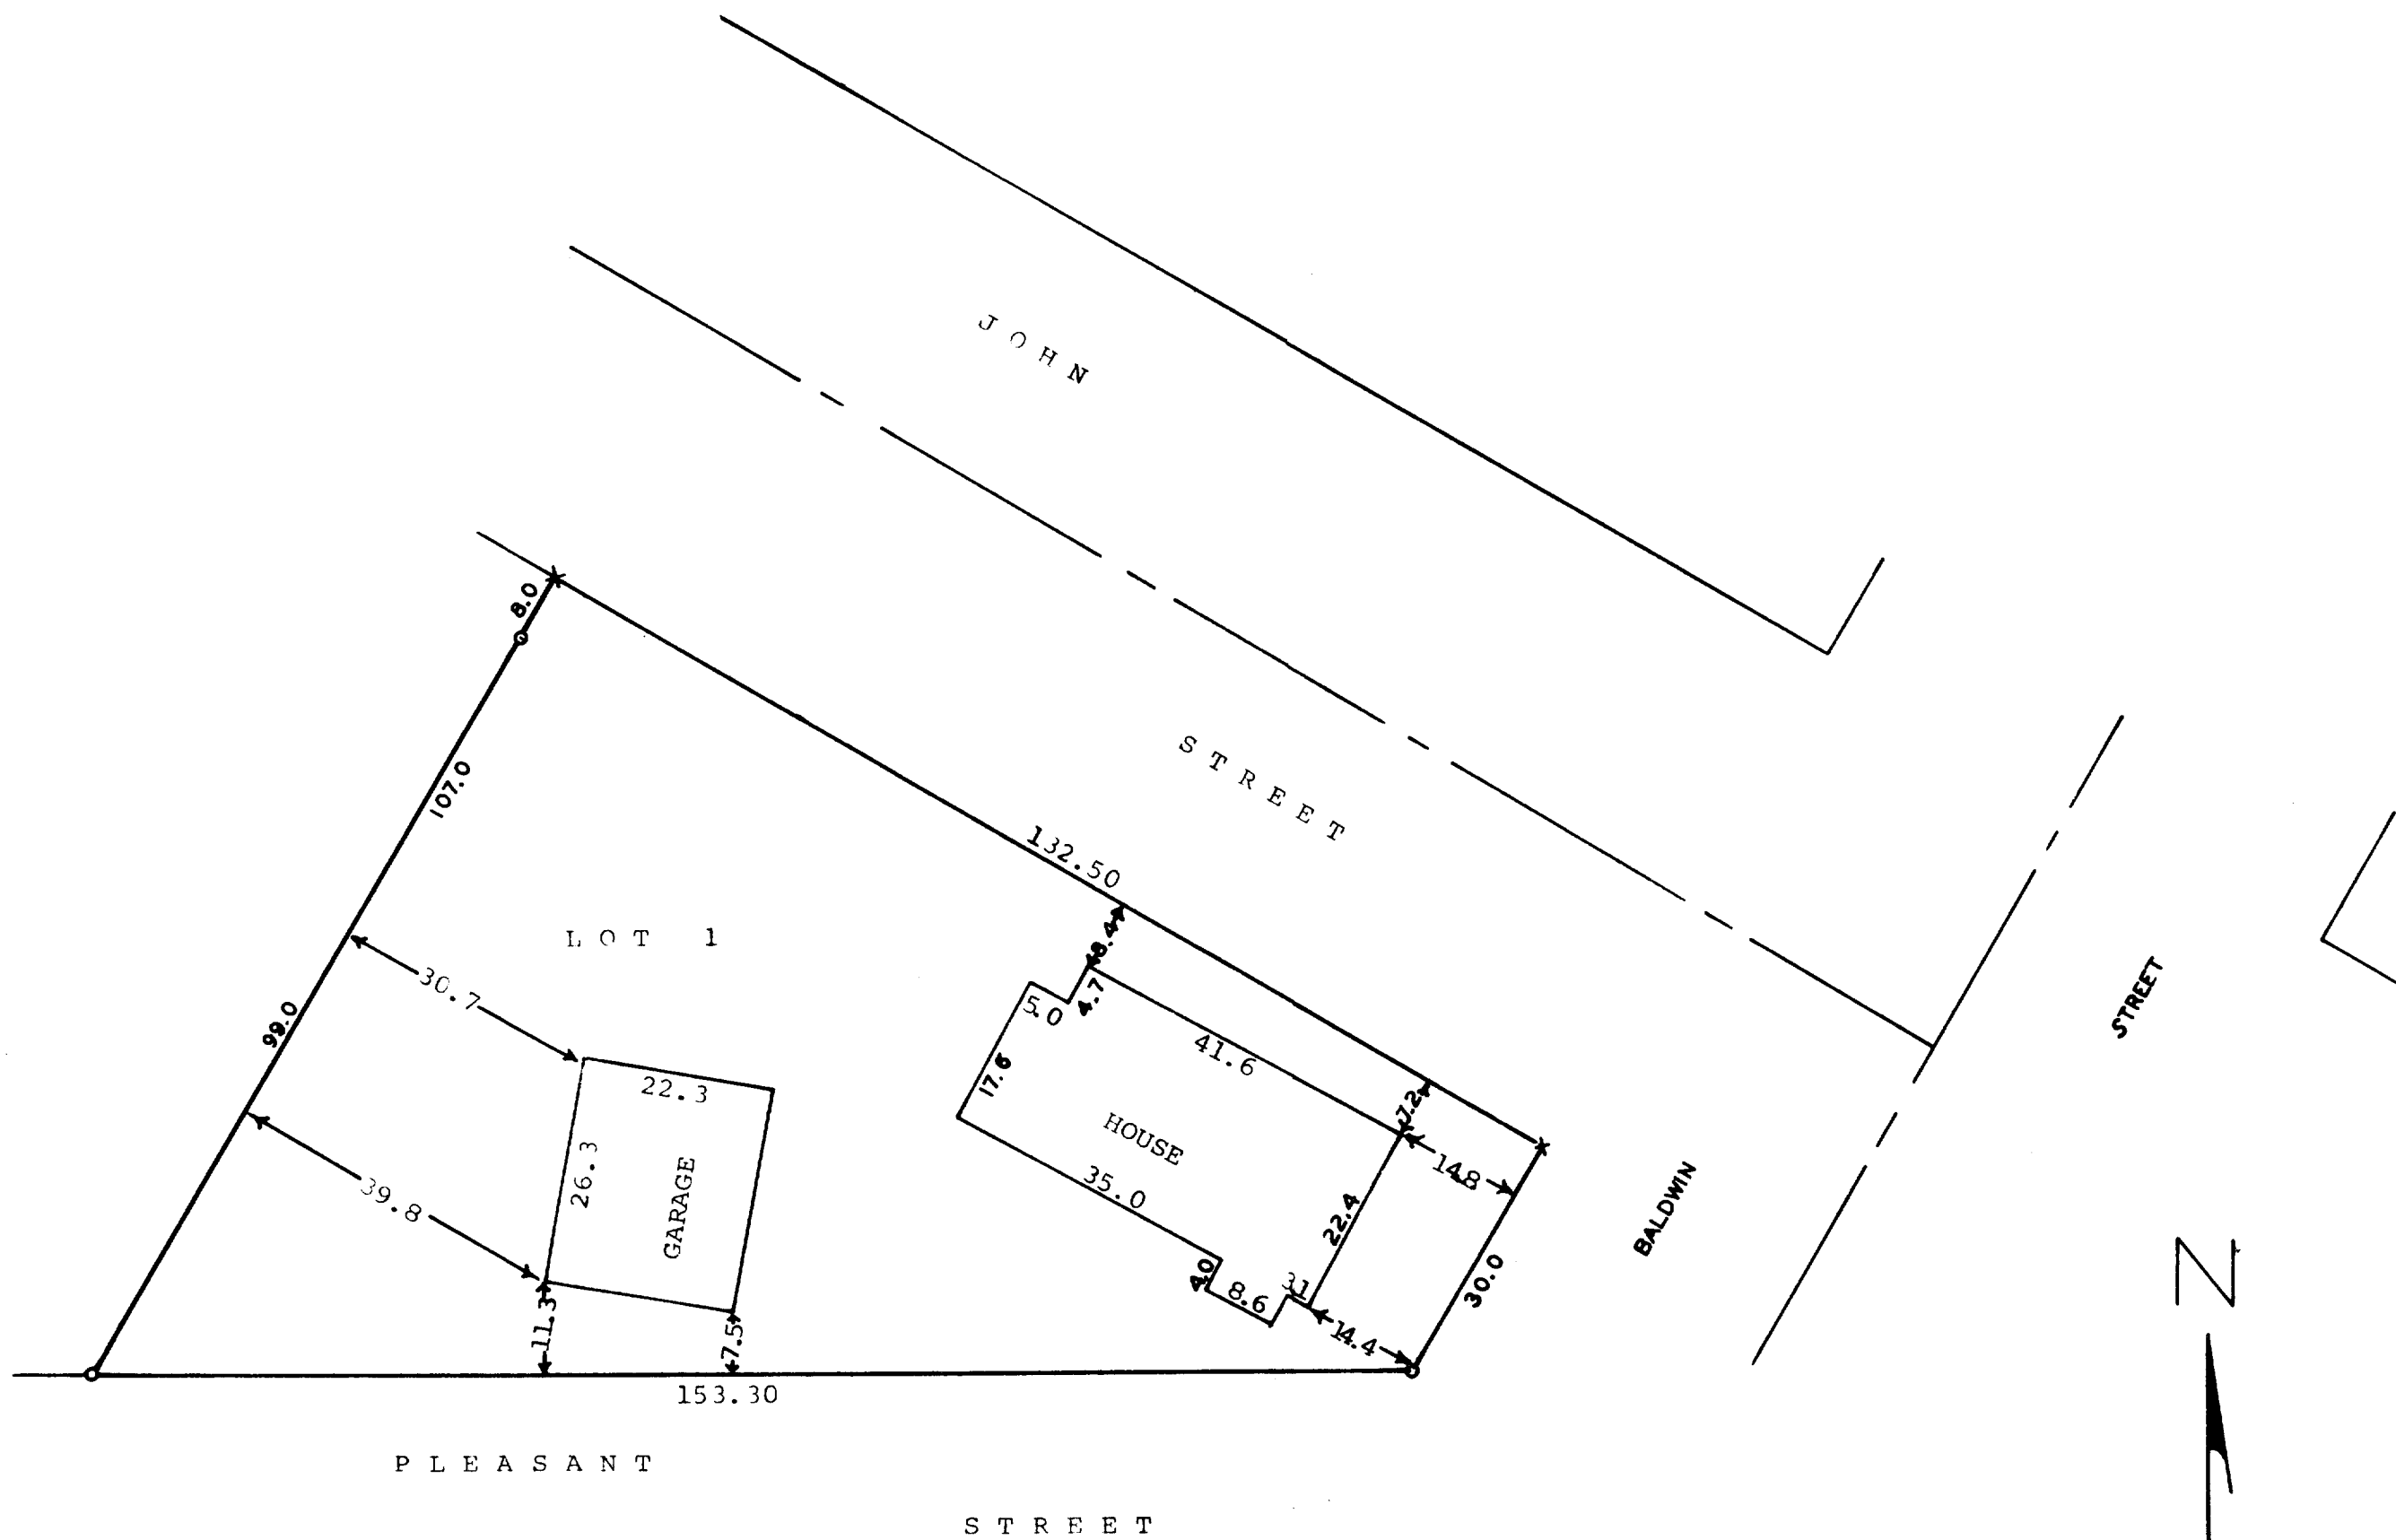

STATE OF WISCONSIN)
COUNTY OF WALWORTH) SS

I, George T. Dunham, Surveyor, certify that I have surveyed the property described as follows,
Lot 1, Block 17 of the Original Plat of the Village of Sharon, Walworth County, Wisconsin,
and that the above plat is an accurate survey and a true representation thereof and correctly shows the exterior boundary lines and locations of buildings on said property and the correct measurements thereof.
May 17, 1973

George T. Dunham
George T. Dunham, Surveyor

Scale - 1" = 20'
● = Iron Pipe
x = Cross in concrete sidewalk

