


GEORGE T. DUNHAM
SURVEYING & SUBDIVIDING
DELAVAN, WISCONSIN



Center of Section 33,
T 1 N, R 15 E

STREET

MARTIN

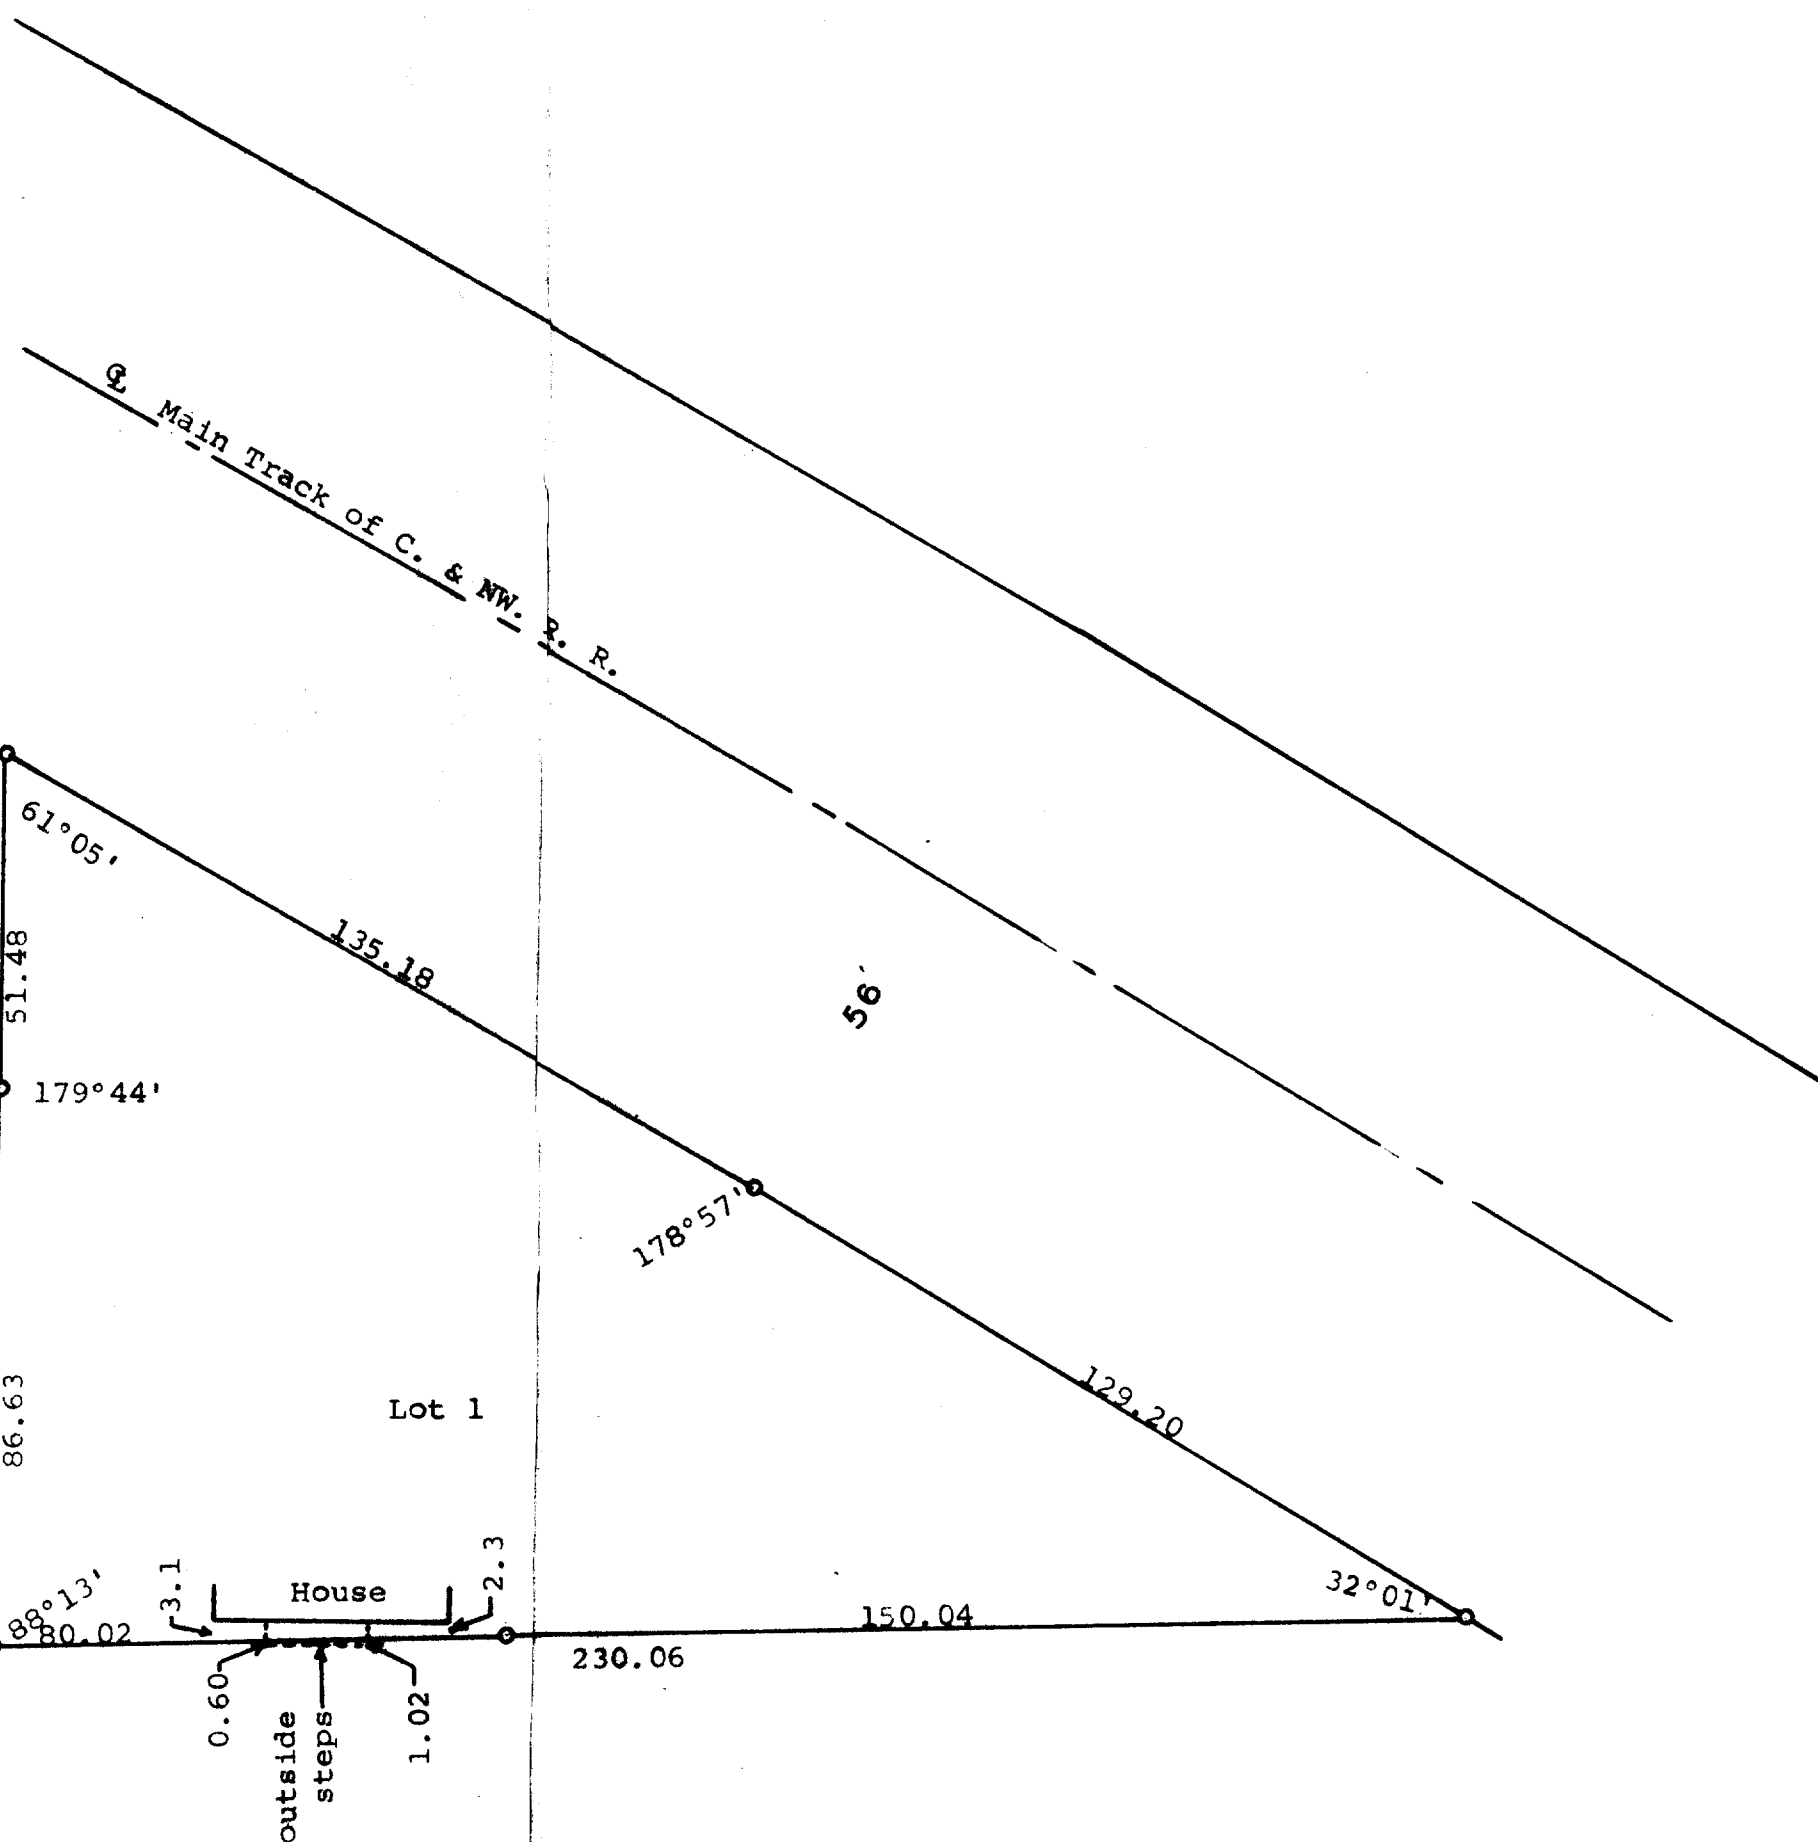

Scale - 1" = 30'

○ = Iron Pipe

● = Concrete Monument

Plat of survey of Lot 1 in Block 8 of Citizens Addition
to the Village of Sharon, Valworth County, Wisconsin.
April 25, 1974

George T. Dunham
George T. Dunham, Surveyor

