


HAROLD H. KOLB
REGISTERED PROFESSIONAL LAND SURVEYOR
TRUST BUILDING
LAKE GENEVA, WIS. 53147

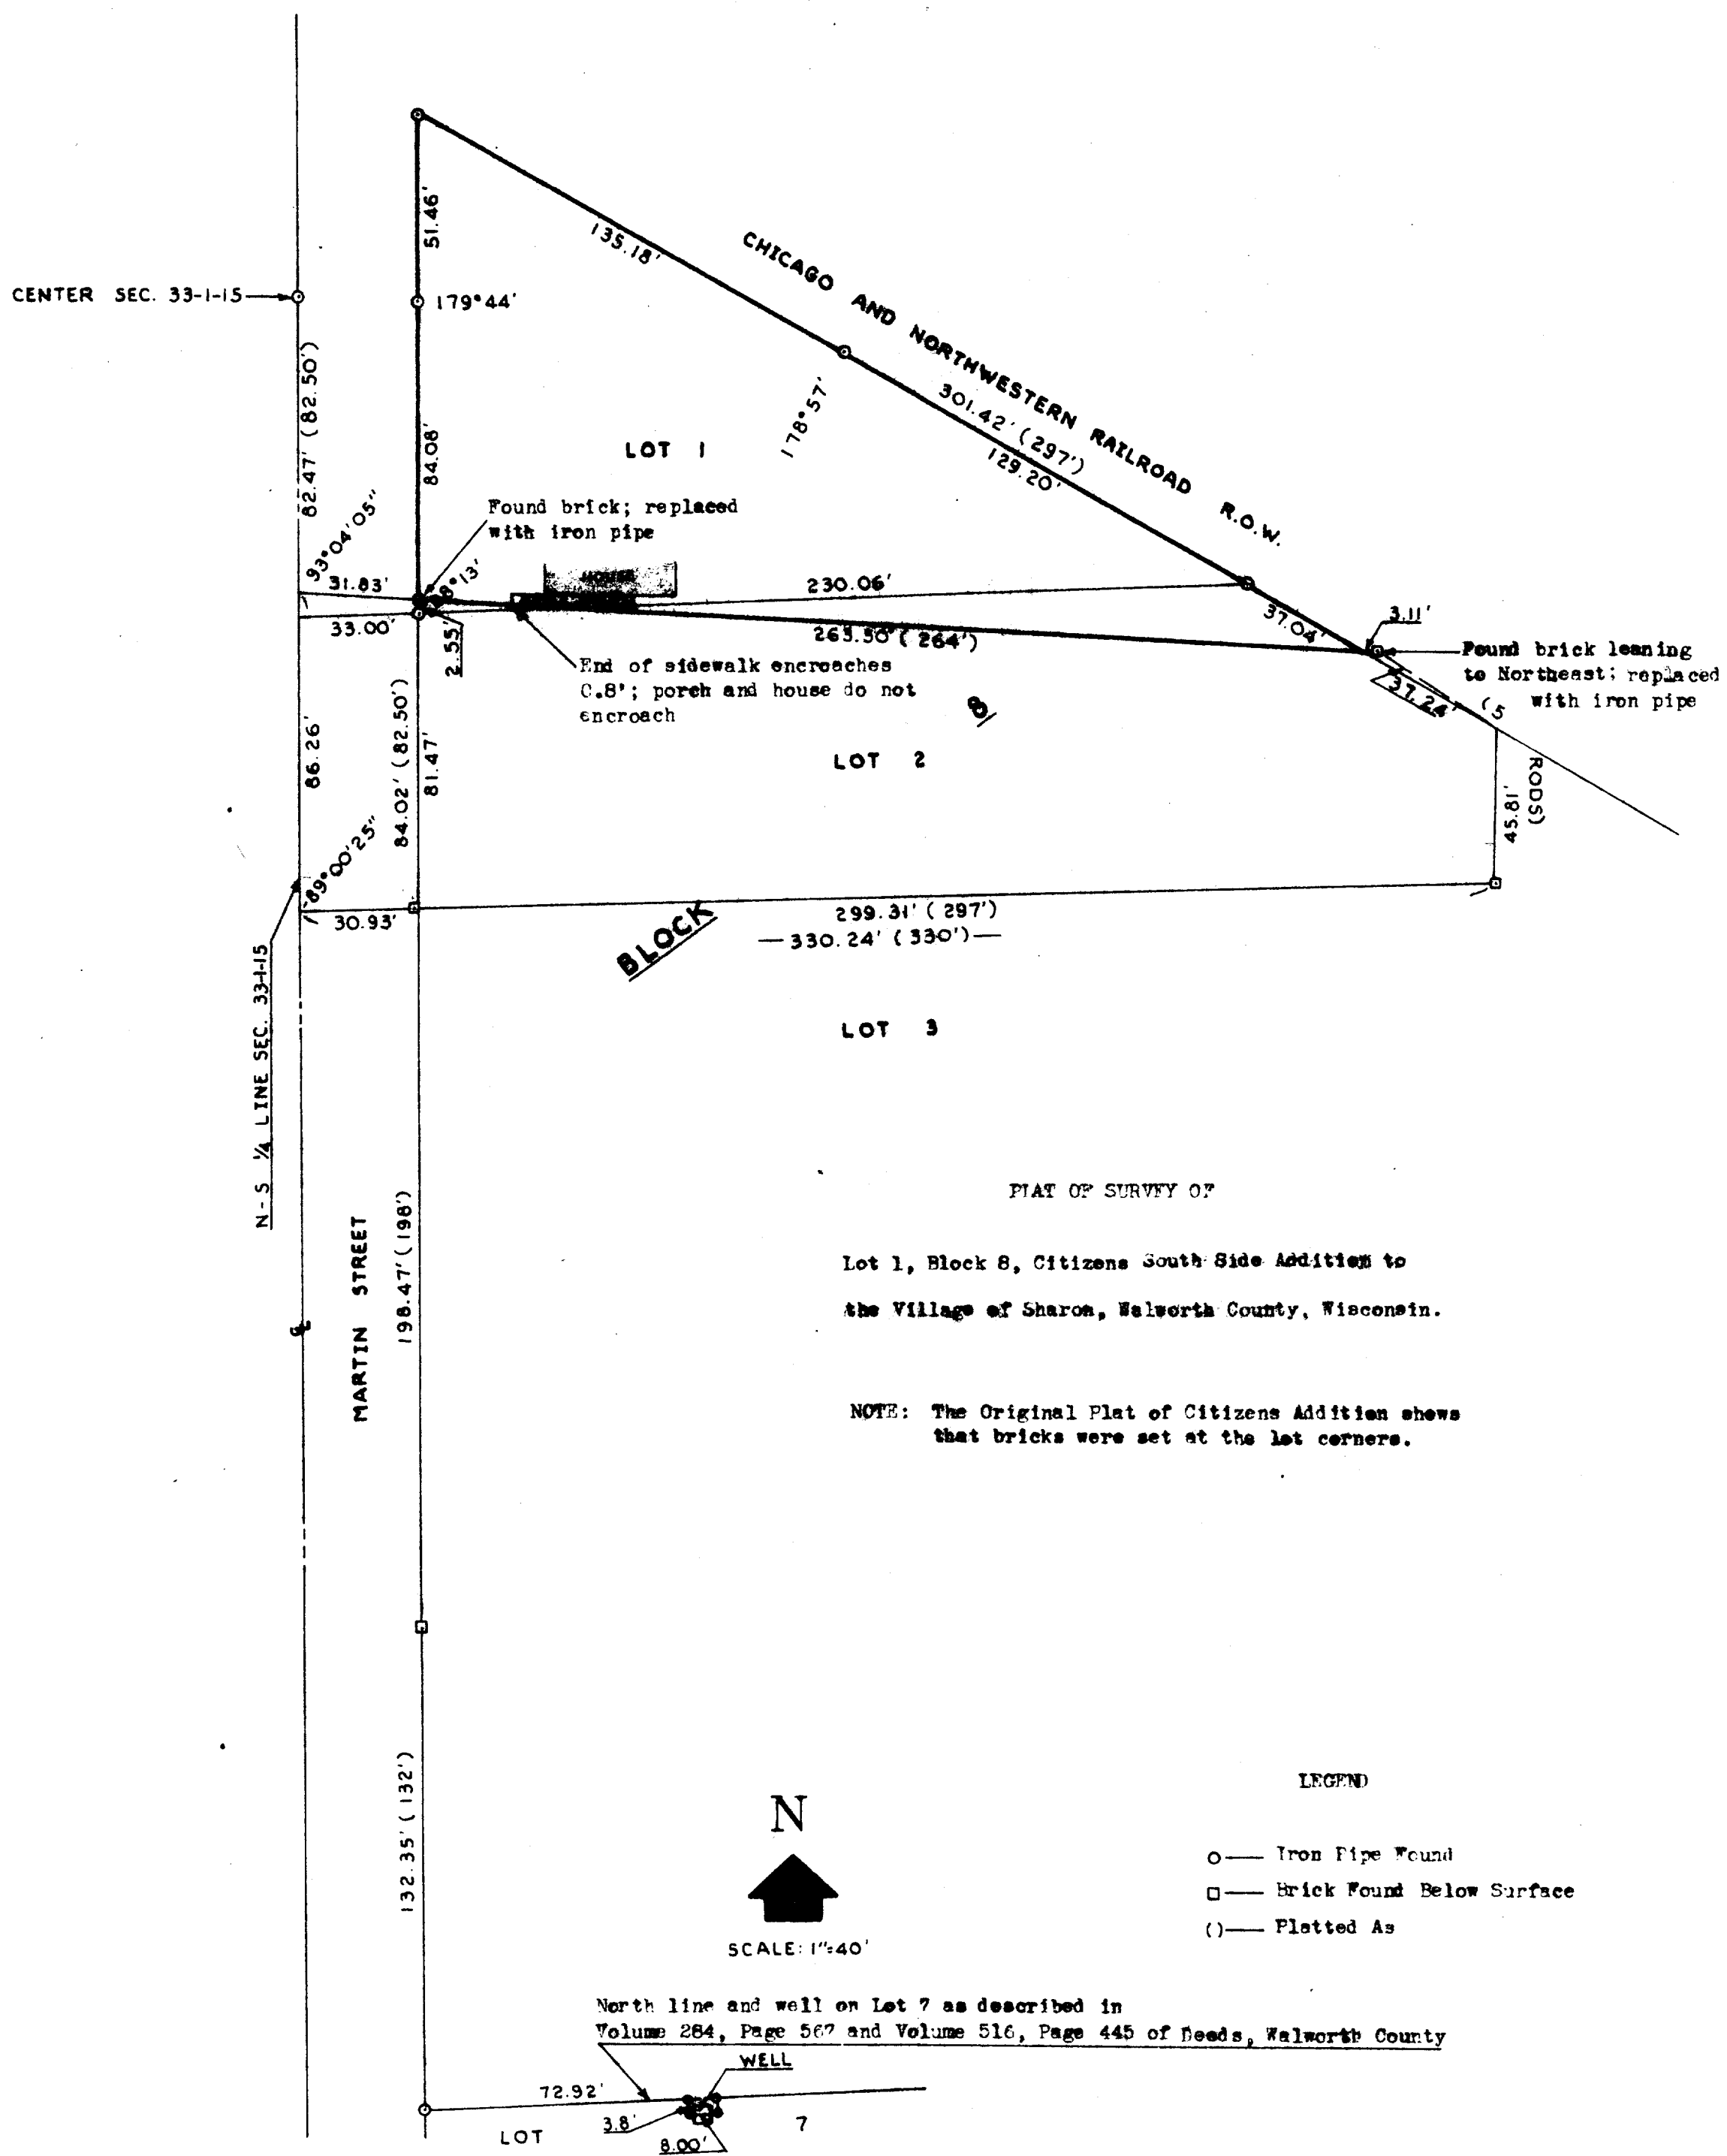

Harold H. Kolb
Harold H. Kolb
Wisconsin Registered Land Surveyor, S-187

May 31, 1974
Date
Revised: June 13, 1974