


HAROLD H. KOLB

REGISTERED PROFESSIONAL LAND SURVEYOR
LAKE GENEVA, WISCONSIN

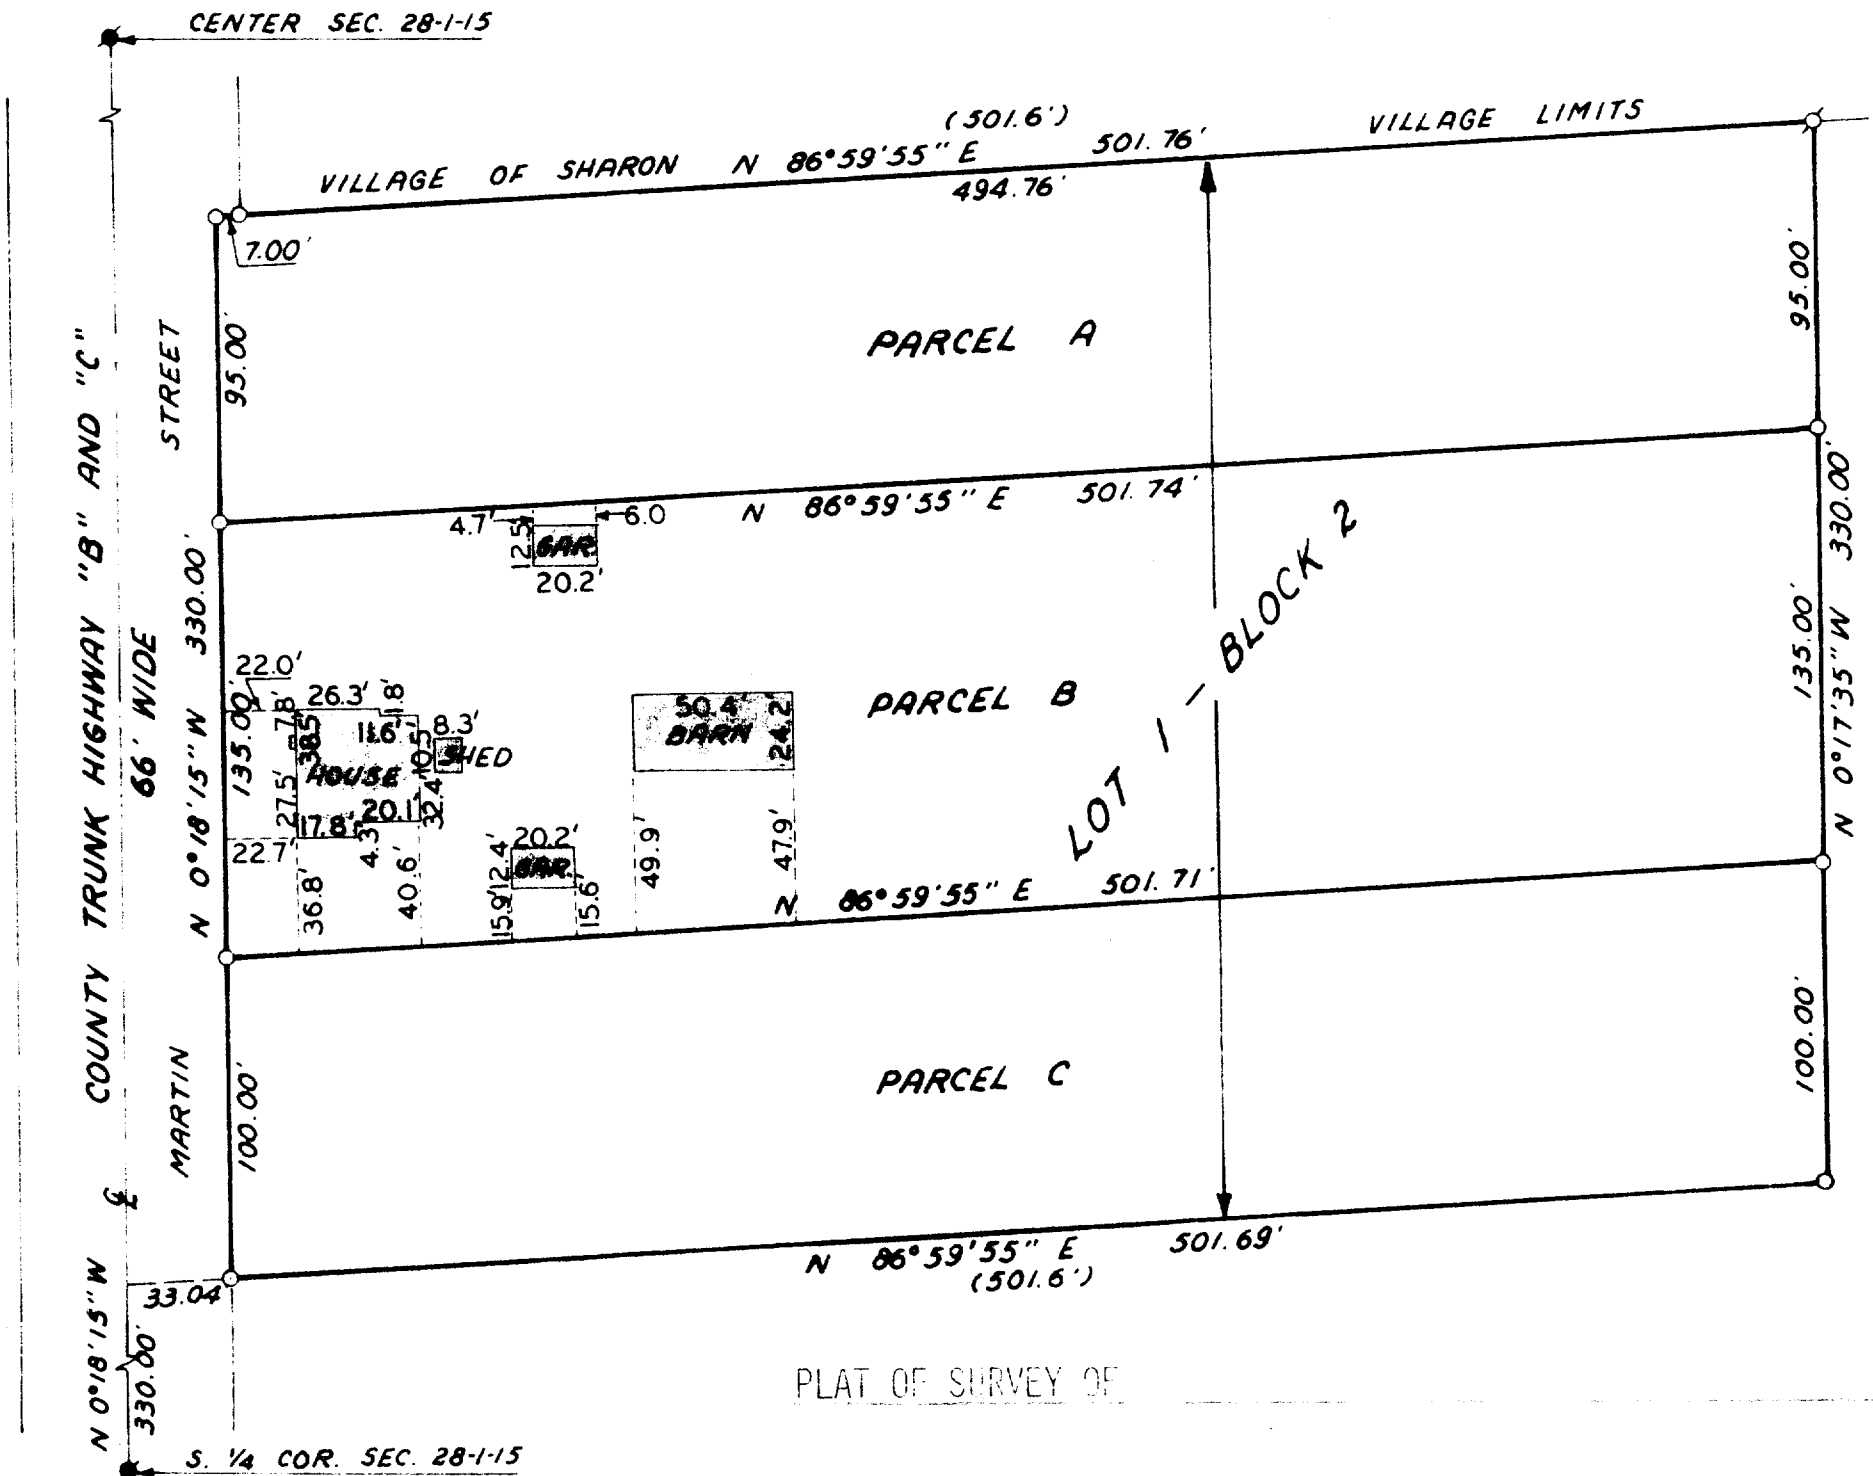

LOT 1, BLOCK 2, CITIZENS NORTH SIDE ADDITION, VILLAGE OF SHARON, WALWORTH COUNTY, WISCONSIN.

PARCEL A: COMMENCING AT THE SOUTH 1/4 CORNER OF SECTION 28, T1N, R15E; THENCE N 0°18'15" W 330.00 FEET ALONG THE WEST LINE OF THE SOUTHEAST 1/4 OF SAID SECTION 28; THENCE N 86°59'55" E 33.04 FEET; THENCE N 0°18'15" W 235.00 FEET ALONG THE EASTERLY RIGHT-OF-WAY LINE OF COUNTY TRUNK HIGHWAY "B" AND "C" TO THE PLACE OF BEGINNING; THENCE CONTINUE N 0°18'15" W 93.00 FEET ALONG SAID RIGHT-OF-WAY LINE; THENCE N 86°59'55" E 501.76 FEET; THENCE S 0°17'35" E 95.00 FEET; THENCE S 86°59'55" W 501.74 FEET TO THE PLACE OF BEGINNING. CONTAINING 1.09 ACRES.

PARCEL B: COMMENCING AT THE SOUTH 1/4 CORNER OF SECTION 28, T1N, R15E; THENCE N 0°18'15" W 330.00 FEET ALONG THE WEST LINE OF THE SOUTHEAST 1/4 OF SAID SECTION 28; THENCE N 86°59'55" E 33.04 FEET; THENCE N 0°18'15" W 100.00 FEET ALONG THE EASTERLY RIGHT-OF-WAY LINE OF COUNTY TRUNK HIGHWAY "B" AND "C" TO THE PLACE OF BEGINNING; THENCE CONTINUE N 0°18'15" W 175.00 FEET ALONG SAID RIGHT-OF-WAY LINE; THENCE N 86°59'55" E 501.74 FEET; THENCE S 0°17'35" E 135.00 FEET; THENCE S 86°59'55" W 501.71 FEET TO THE PLACE OF BEGINNING. CONTAINING 1.55 ACRES.

PARCEL C: COMMENCING AT THE SOUTH 1/4 CORNER OF SECTION 28, T1N, R15E; THENCE N 0°18'15" W 330.00 FEET ALONG THE WEST LINE OF THE SOUTHEAST 1/4 OF SAID SECTION 28; THENCE N 86°59'55" E 33.04 FEET TO THE PLACE OF BEGINNING; THENCE N 0°18'15" W 100.00 FEET ALONG THE EASTERLY RIGHT-OF-WAY LINE OF COUNTY TRUNK HIGHWAY "B" AND "C"; THENCE N 86°59'55" E 501.71 FEET; THENCE S 0°17'35" E 100.00 FEET; THENCE S 86°59'55" W 501.69 FEET TO THE PLACE OF BEGINNING. CONTAINING 1.15 ACRES.


ACCURACY: DISTANCE $\pm 0.01'$

ANGLES $\pm 05''$

ERROR OF CLOSURE LESS THAN 1/3000

NOTE: BEARINGS DETERMINED BY SOLAR OBSERVATION.

ORDERED BY: ED SLOPER AND ASSOCIATES

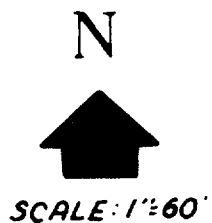

LEGEND

- φ - IRON PIPE FOUND
- - IRON PIPE PLACED
- - CONCRETE MONUMENT FOUND
- x - SPIKE
- () - PLATTED AS

I, HAROLD H. KOLB, DO HEREBY CERTIFY THAT I HAVE SURVEYED THE PROPERTY HEREON DESCRIBED ACCORDING TO THE OFFICIAL RECORDS AND THAT THE PLAT HEREON IS A CORRECT REPRESENTATION OF THE LOT LINES

HAROLD H. KOLB
WISCONSIN REGISTERED LAND SURVEYOR, §-187
DATE 2-20-1972

8-72

UCA-14, 14A, 14B