

FARRIS, HANSEN & COOPER, INC.

ENGINEERING, SURVEYING AND LAND PLANNING
715 W. WALWORTH ST. - P.O. BOX 487 - ELKHORN, WI 53121

ORDERED BY:


UNIVERSAL
MORTGAGE

LOT 1

LOT 2

LOT 3

BLOCK 1

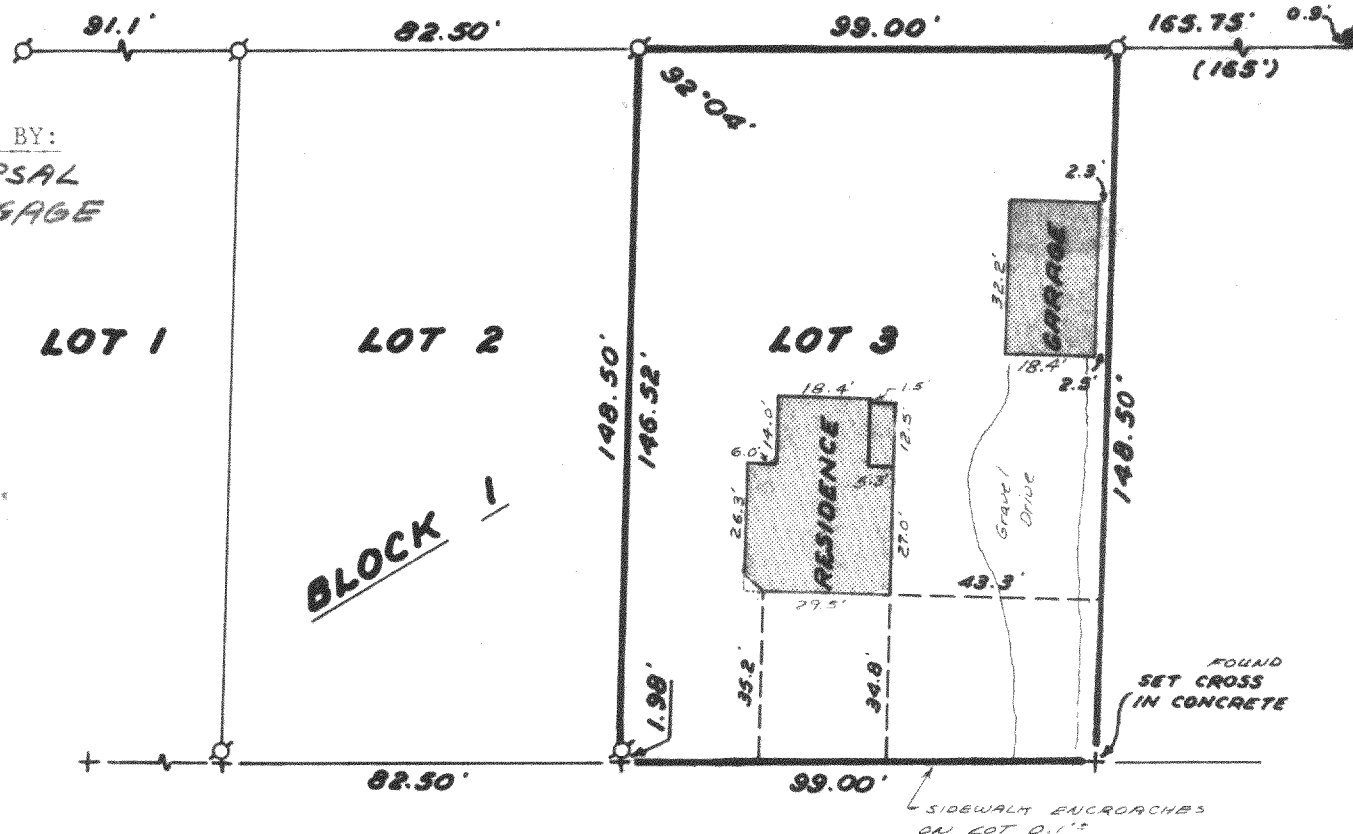

PLAT OF SURVEY OF


LOT 3, BLOCK 1, SHARON LAND AND IMPROVEMENT COMPANY ADDITION,
SECTION 33, TOWN 1 NORTH, RANGE 15 EAST, VILLAGE OF SHARON,
WALWORTH COUNTY, WISCONSIN.

0 10 20 40

SCALE IN FEET
1"=40'

LEGEND

- - Iron Pipe Found
- - Iron Pipe Set - 1" x 24"
- + - Cut cross in concrete found
- () - Record Dimension
- - Iron Rod Found

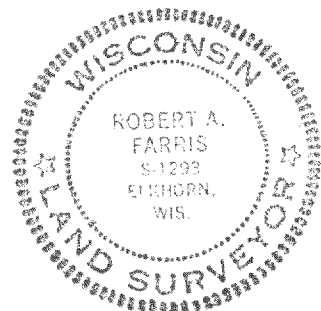

I hereby certify that I have surveyed the above described property and that the above map is a true representation thereof and shows the size and location of the property, its exterior boundaries, the location of all visible structures and dimensions of all principal buildings thereon, boundary fences, apparent easements, roadways and visible encroachments, if any.

This survey is made for the use of the present owners of the property, and also those who purchase, mortgage, or guarantee the title thereto within one (1) year from date hereof.

Robert A. Farris

17 NOV. 1982 PROJECT NO. 2029

4541-3

8-75-F