


DELETED WORKS 53115



James M. Dunham
James M. Dunham, Surveyor

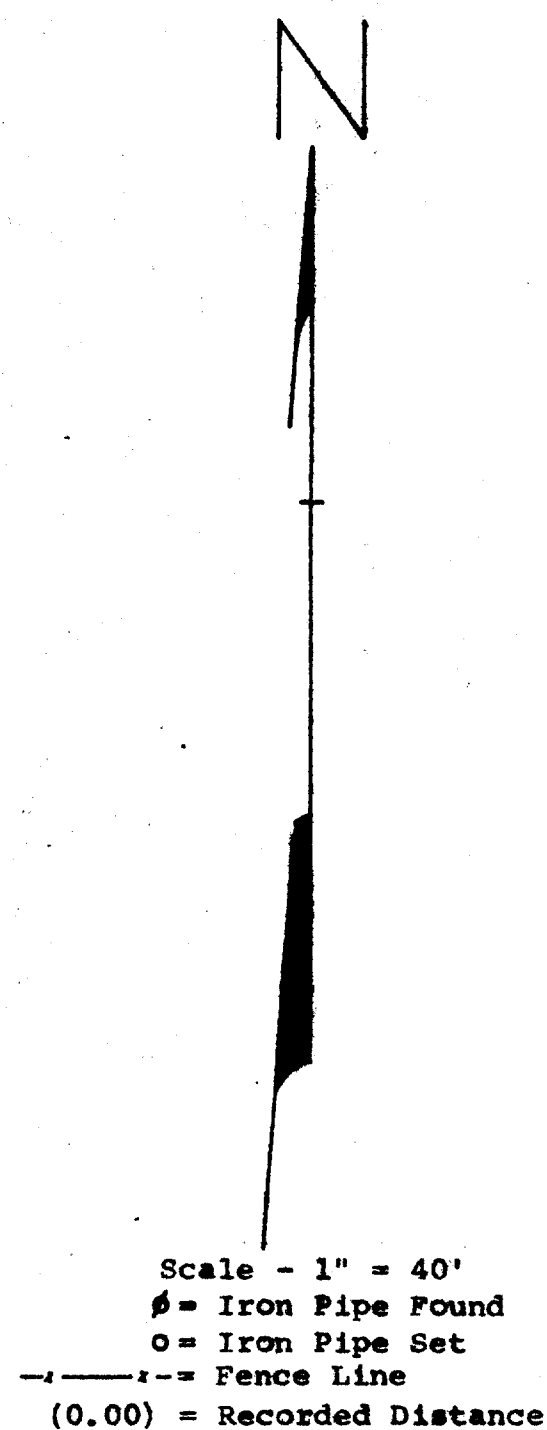