109 SOUTH SPRING STREET BURLINGTON, WISCONSIN 53105 PHONE: 414-763-2652 414-763-7834

ROBERS & BOYD, INC.

CONSULTING ENGINEERS LAND SURVEYORS

BRANCH OFFICE 809 - 43RD STREET KENOSHA, WISCONSIN 83140 PHONE: 414-658-4488

MORTGAGE INSPECTION

for

Universal Mortgage Corp.

of


The East of Lot 5 Block 3 of WISE & NELSON'S North Side Addition to the Village of Sharon, Walworth County, Wisconsin.

BUYERS: Gail M. & James R Swaney

247 Nelson Street

Sharon, WI

Note: This Mortgage Inspection was prepared for identification purposes for a real estate sale transaction, No corners were established by request of Universal Mortgage Corp. Do not use this map for establishing fence lines or construction.

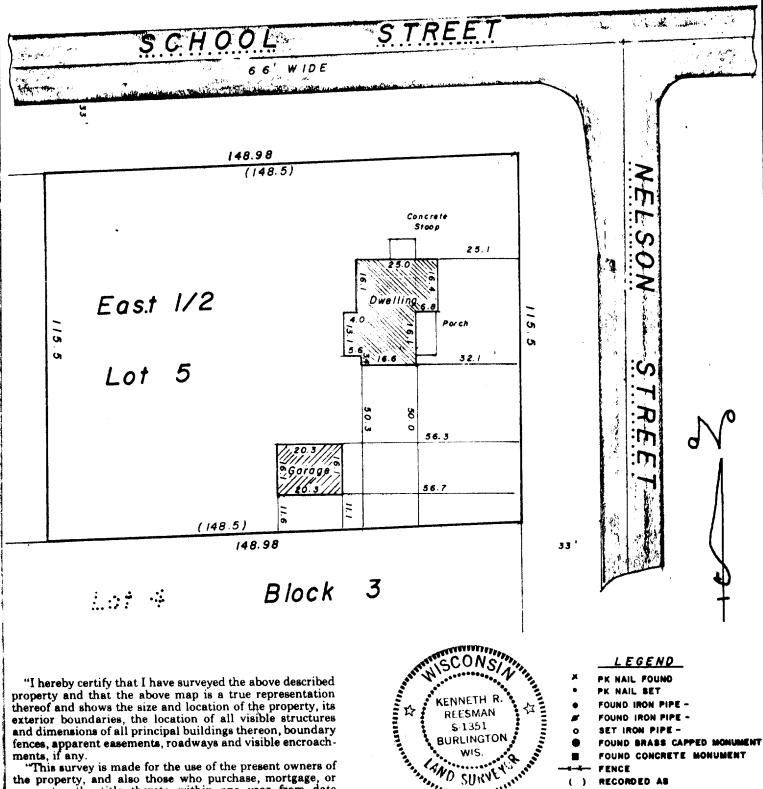

UWNA-27

ments, if any.

"This survey is made for the use of the present owners of the property, and also those who purchase, mortgage, or guarantee the title thereto within one year from date hereof."

YES MONUMENTATION HAS BEEN WAIVED IN ACCORDANCE WITH A-E 5.01(b) OF THE WISCONSIN ADMINISTRATIVE CODE.

WISCONSIN REGISTERED LAND SURVEYOR

eencu

9-28-82

DATE

FIELD WORK BY KET GJA

DRAWN BY KTT

FENCE RECORDED AS

()

82172 JOB NUMBER

EXISTING GROUND ELEVATION

SCALE-1" = 30"