


ABELL
SURVEYING & MAPPING

1140 SEQUOIA STREET • DELAVAN, WISCONSIN 53115
262-728-6737

GRACE STREET

66 FEET WIDE

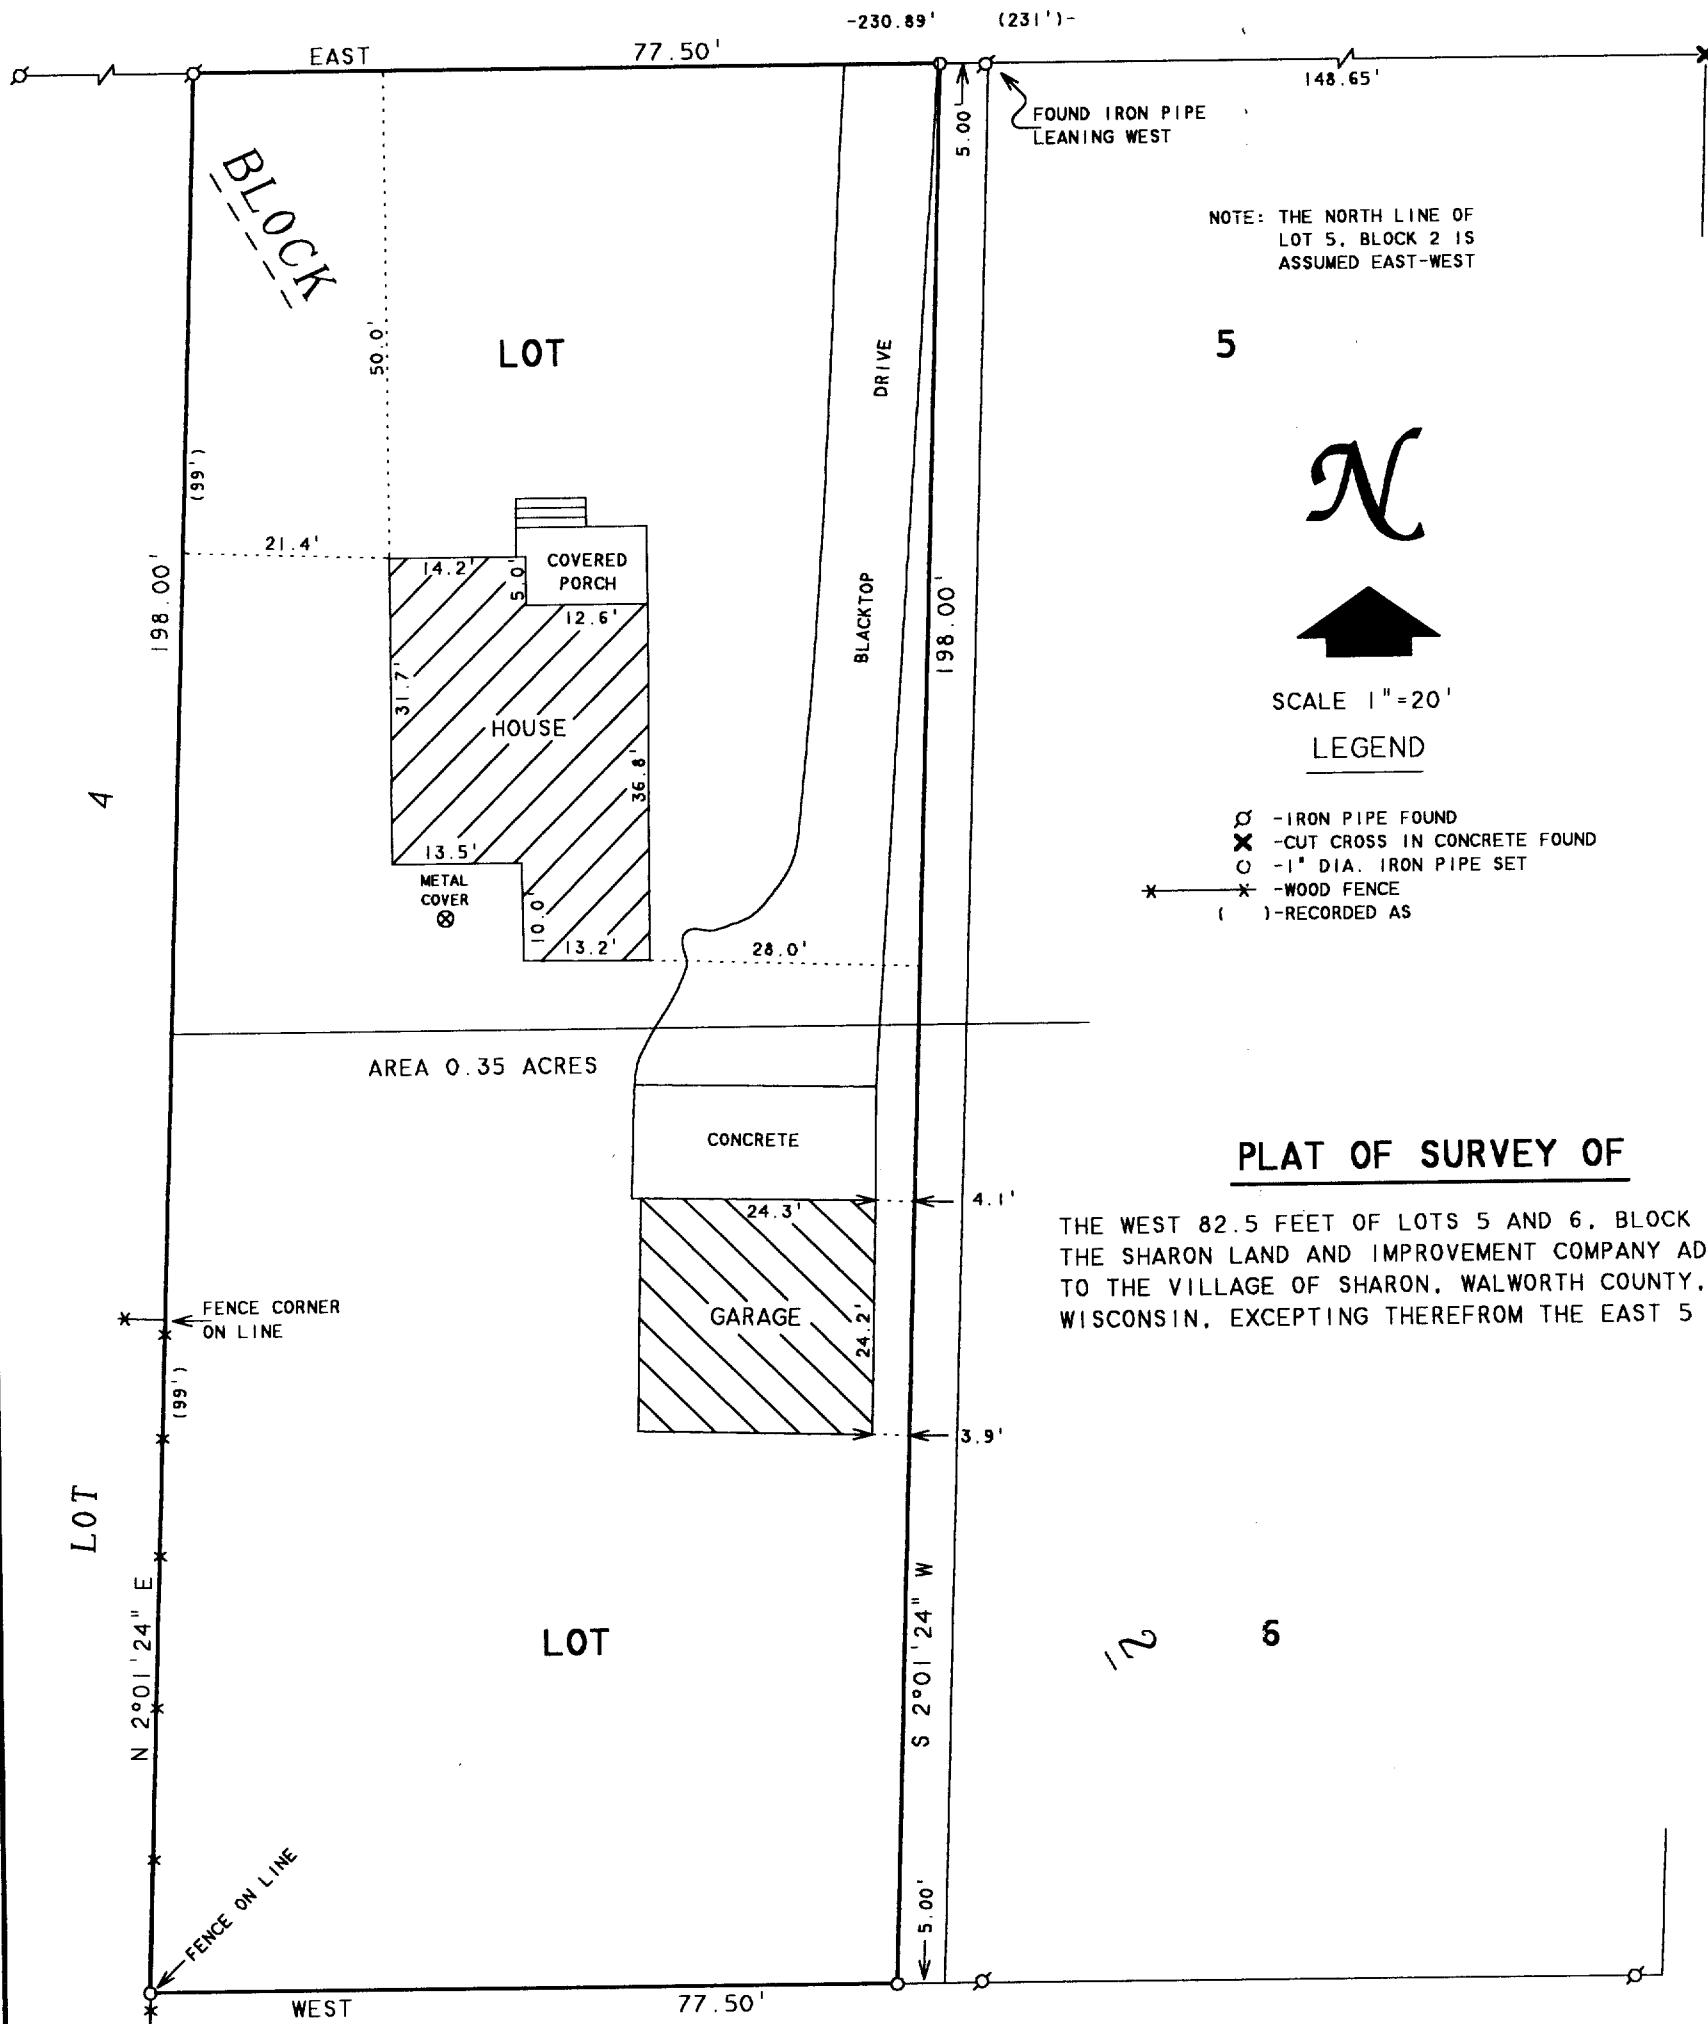

NOTE: THE NORTH LINE OF LOT 5, BLOCK 2 IS ASSUMED EAST-WEST



SCALE 1" = 20'

LEGEND

- ⊙ - IRON PIPE FOUND
- ✕ - CUT CROSS IN CONCRETE FOUND
- - 1" DIA. IRON PIPE SET
- * - WOOD FENCE
- () - RECORDED AS

PLAT OF SURVEY OF

THE WEST 82.5 FEET OF LOTS 5 AND 6, BLOCK 2 OF THE SHARON LAND AND IMPROVEMENT COMPANY ADDITION TO THE VILLAGE OF SHARON, WALWORTH COUNTY, WISCONSIN, EXCEPTING THEREFROM THE EAST 5 FEET.

I HEREBY CERTIFY THAT I HAVE SURVEYED THE ABOVE DESCRIBED PROPERTY AND THAT THE ABOVE MAP IS A TRUE REPRESENTATION THEREOF AND SHOWS THE SIZE AND LOCATION OF THE PROPERTY, ITS EXTERIOR BOUNDARIES, THE LOCATION OF ALL VISIBLE STRUCTURES AND DIMENSIONS OF ALL PRINCIPAL BUILDINGS THEREON, BOUNDARY FENCES, APPARENT EASEMENTS, ROADWAYS AND VISIBLE ENCROACHMENTS, IF ANY, TO THE BEST OF MY KNOWLEDGE AND BELIEF.

THIS SURVEY IS MADE FOR THE USE OF THE PRESENT OWNERS OF THE PROPERTY, AND ALSO THOSE WHO PURCHASE, MORTGAGE, OR GUARANTEE THE TITLE THERETO WITHIN ONE (1) YEAR FROM DATE HEREON.

David F. Abell
DAVID F. ABELL
WISCONSIN REGISTERED LAND SURVEYOR, #1596

ORDERED BY: RE/MAX GENEVA REALTY, LTD.
101 BROAD STREET
LAKE GENEVA, WI 53147

June 26, 2002

DATE: June 26, 2002 JOB NUMBER - 02083
NOTE: THIS IS NOT A CERTIFIED COPY UNLESS SEALED.

RECEIVED
NOV 12 2002

USCI-13

008-369