




PREPARED FOR  
RODGER WESTBURG

# PLAT OF SURVEY

- OF -

LOT 10, HALDEMAN-NOTORANGELO SUBDIVISION, LOCATED  
IN THE SW 1/4 OF SECTION 33, TOWN 1 NORTH, RANGE 15  
EAST, VILLAGE OF SHARON, COUNTY OF WALWORTH AND  
STATE OF WISCONSIN.

PATHFINDER SURVEYING INC.  
(formerly)  
J.K. SURVEYING INC.  
P.O BOX 322  
LAKE GENEVA, WI. 53147  
WWW.PATHFINDERSURVEYING.NET  
262-248-8303

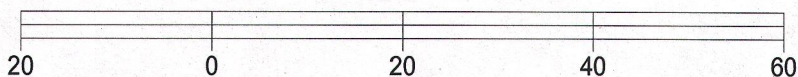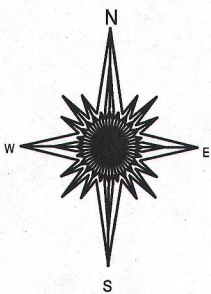
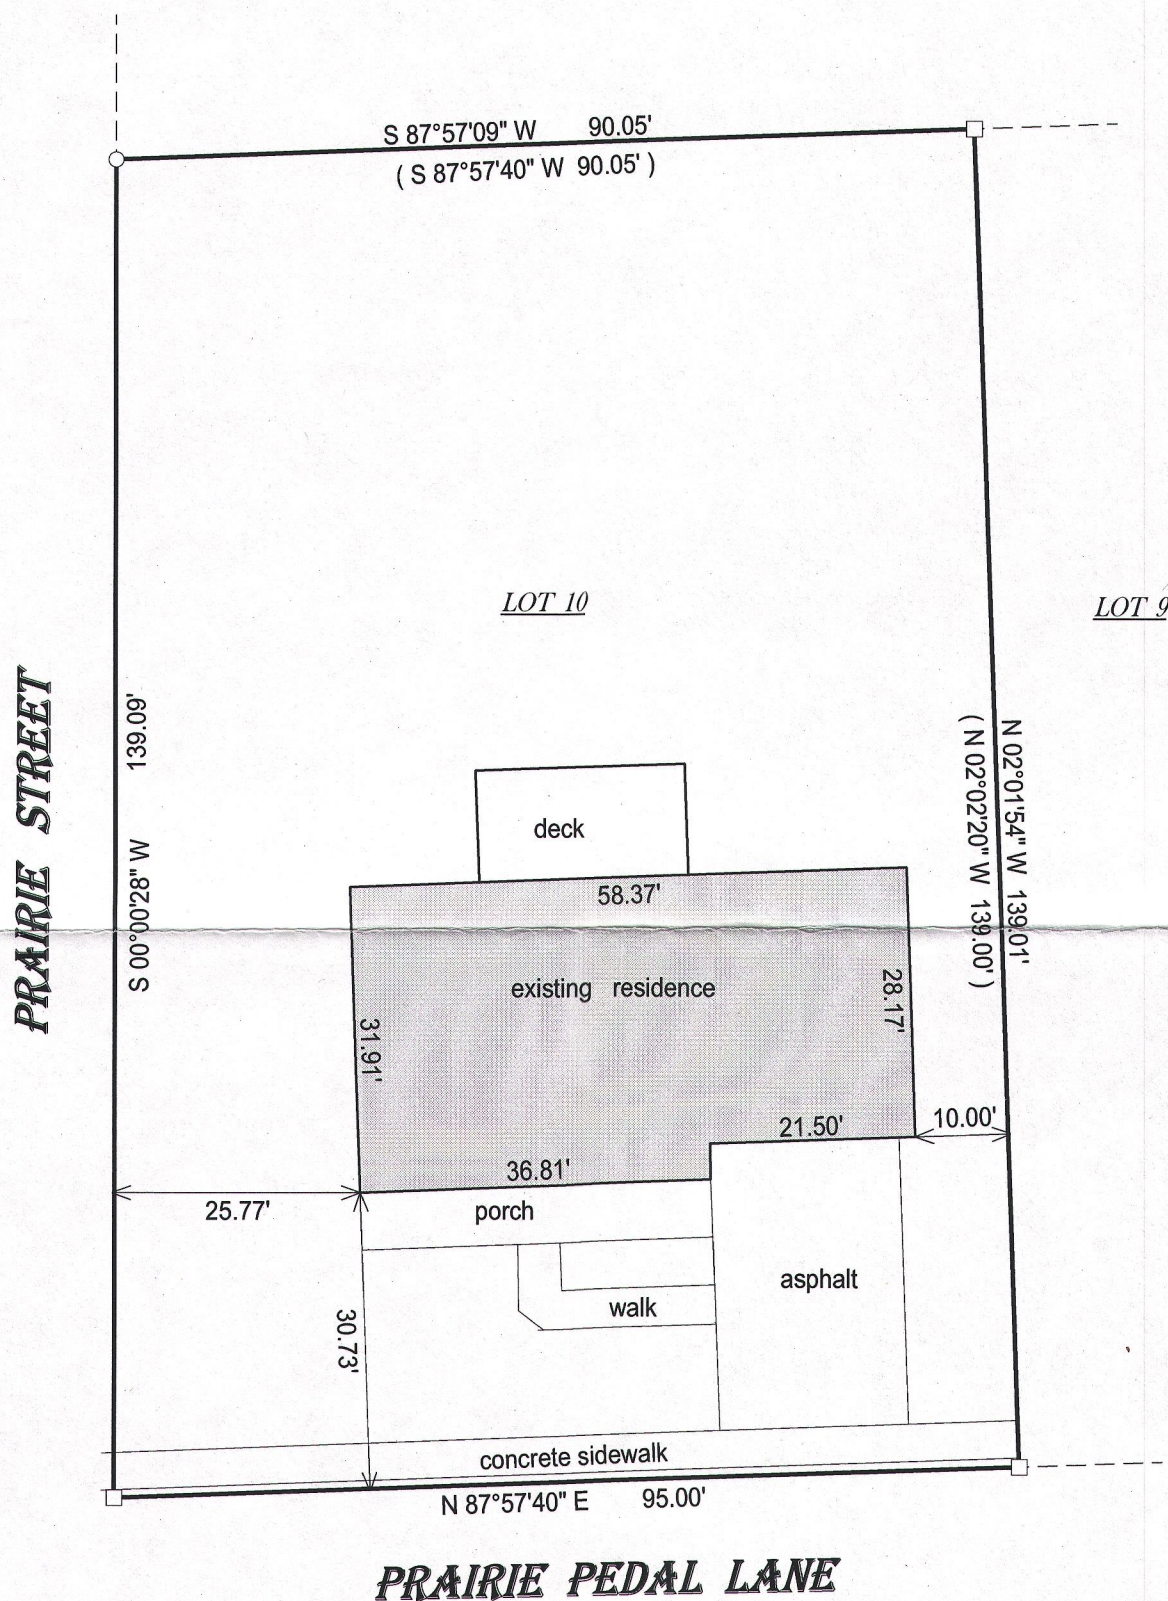


BASIS OF BEARING OF THIS PLAT: THE SUBDIVISION PLAT OF RECORD.

I hereby certify that I have surveyed the above- described property and the above map is a true representation thereof and shows the size and location of the property, its exterior boundaries, the location and dimensions of all structures thereon, fences, apparant easements and roadways and visible encroachments if any.

This survey is made for the present owners of the property, and those who purchase, mortgage, or guarantee the title thereto, within one year from the date hereof.

DATED THIS 13TH DAY OF SEPTEMBER, 2015.

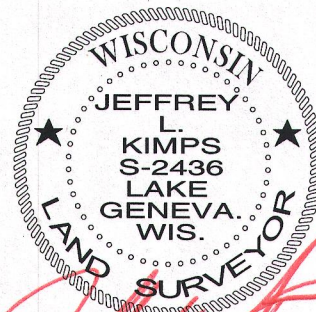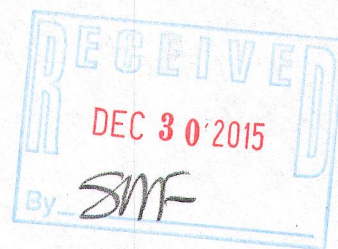

JEFFREY L. KIMPS S - 2436  
Wisconsin Professional Land Surveyor  
(original if signed in red)

( ) = recorded as

□ = found iron bar

○ = found iron pipe

● = set iron pipe

■ = set iron bar

SCALE 1" = 20'

JOB # 15-287

TAX ID # UHN 00010