


ABELL  
SURVEYING & MAPPING  
DELANAN, WISCONSIN 53115  
414-728-6737

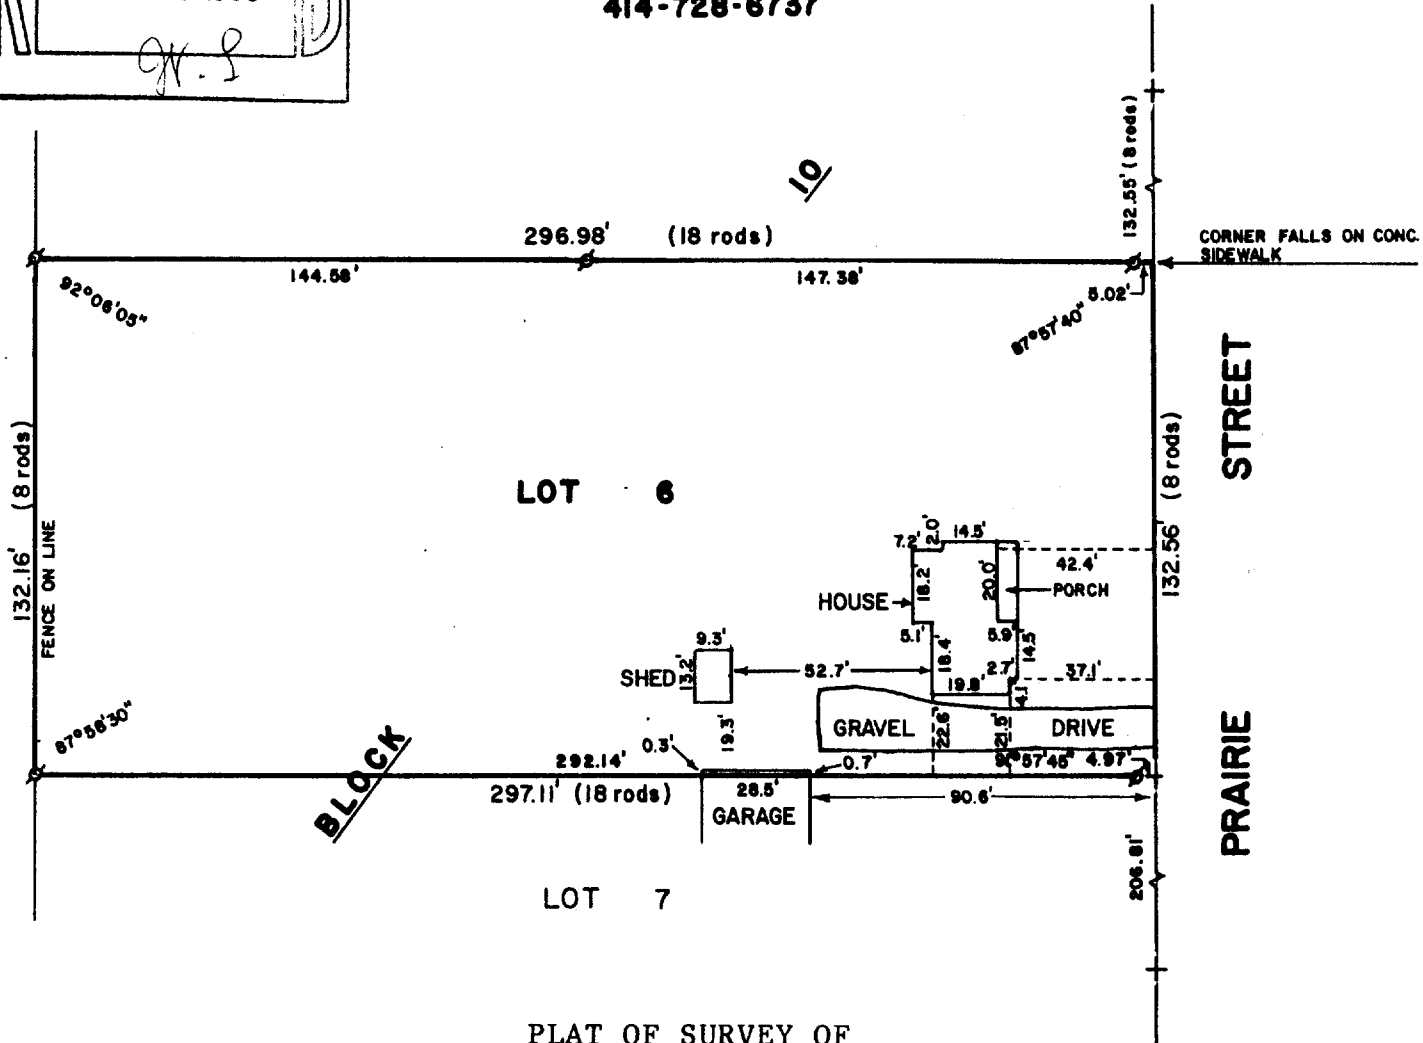

PLAT OF SURVEY OF

LOT 6, BLOCK 10, CITIZENS ADDITION TO THE VILLAGE  
OF SHARON, WALWORTH COUNTY, WISCONSIN.

ORDERED BY: THE RAULAND AGENCY  
118 KENOSHA STREET  
WALWORTH, WI 53184



SCALE - 1"=50'

LEGEND

- ∘ - IRON PIPE FOUND
- + - CUTCROSS IN CONCRETE FOUND
- ( ) - RECORDED AS

NOTE: 1 ROD = 16.5'

I HEREBY CERTIFY THAT I HAVE SURVEYED THE ABOVE DESCRIBED PROPERTY AND THAT THE ABOVE MAP IS A TRUE REPRESENTATION THEREOF AND SHOWS THE SIZE AND LOCATION OF THE PROPERTY, ITS EXTERIOR BOUNDARIES, THE LOCATION OF ALL PRINCIPAL BUILDINGS THEREON, BOUNDARY FENCES, APPARENT EASEMENTS, ROADWAYS, AND VISIBLE ENCROACHMENTS, IF ANY, TO THE BEST OF MY KNOWLEDGE AND BELIEF.

THIS SURVEY IS MADE FOR THE USE OF THE PRESENT OWNERS OF THE PROPERTY, AND ALSO THOSE WHO PURCHASE, MORTGAGE, OR GUARANTEE THE TITLE THERETO WITHIN ONE (1) YEAR FROM DATE HEREOF.

*David F. Abell*

DAVID F. ABELL  
WISCONSIN REGISTERED LAND SURVEYOR, S-1596

DATE *July 22, 1986* JOB NUMBER - 86025

*8-111*