
GEORGE T. DUNHAM SURVEYING & SUBDIVIDING

SURVEYING & SUBDIVIDING DELAYAN, WISCONSIN

SCHOOL

STREET

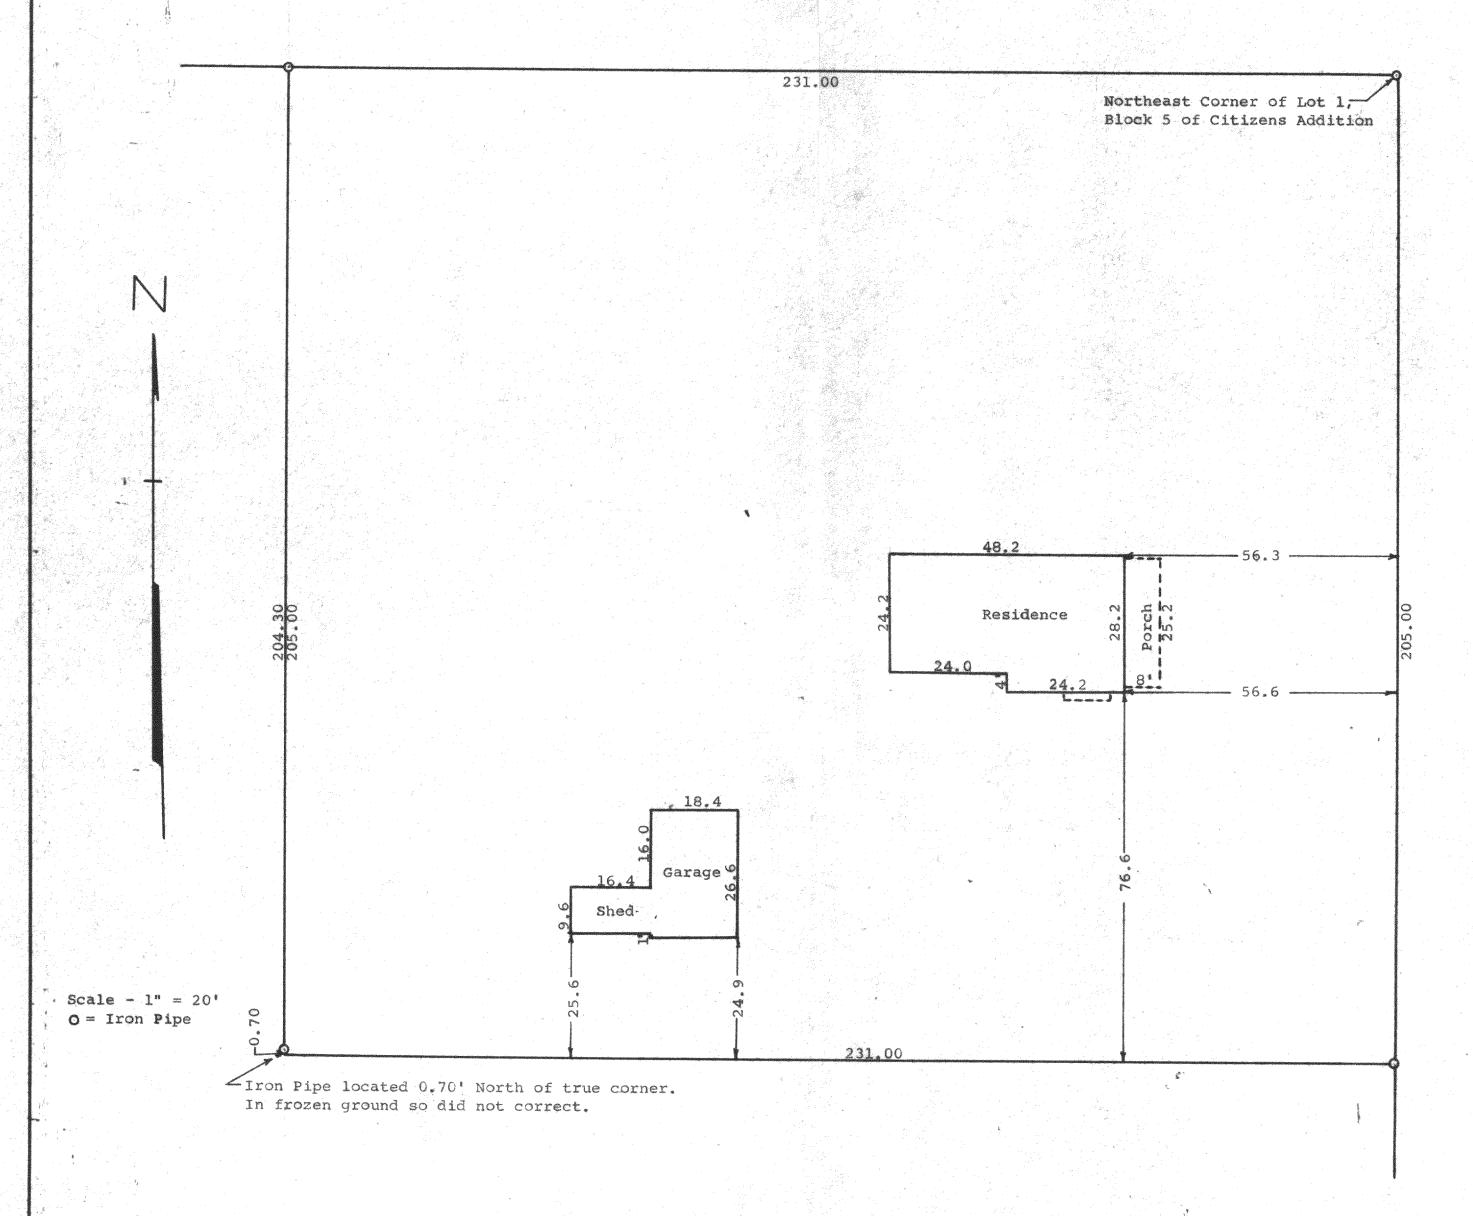

STATE OF WISCONSIN) SS WALWORTH COUNTY

T George T Dunha

I. George T. Dunham, Surveyor, do certify that I have surveyed the property described as follows,

he property described as follows,

That portion of Lot 1 in Block 5 of Citizens Addition in the Village of Sharon, Walworth County, Wisconsin as per plat thereof recorded in the Office of the Register of Deeds in and for the County of Walworth and State of Wisconsin, described as follows, to-wit: Beginning at the northeast corner of said Lot 1, Block 5 of Citizens Addition to the Village of Sharon; thence southerly along the easterly line of said Lot 1, 205.00 feet; thence Westerly on a line parallel with the North line of said Lot 1, 231.00 feet; thence Northerly on a line parallel with the east line of said Lot 1, 205.00 feet to a point on the North line of said Lot 1; thence Easterly along the north line of said Lot 1, 231.00 feet to the place of beginning.

and that the above plat is an accurate survey and a true representation thereof and correctly shows the exterior boundary lines and location of the improvements located thereon and the correct measurements thereof. March 16, 1965

Story S. Dundom George T. Dunham, Surveyor

K 8 E 10-8198-250-8-64

C 4-78