


2554 N. 100TH STREET P.O. BOX 26596 WAUWATOSA, WISCONSIN 53226 (414) 257-2212


PLAT OF SURVEY

LOT 7 and the South 55.5 feet of LOT 8, BLOCK 1, WISE & NELSON'S ADDITION OF THE VILLAGE OF SHARON, being a part of the Northwest 1/4 of Section 33, Township 1 North, Range 15 East, in the Village of Sharon, Walworth County, Wisconsin.

Survey location: 228 Nelson Street Buyer: Patrick F. & Janet M. Yates

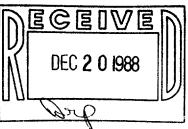

NELSON ST.

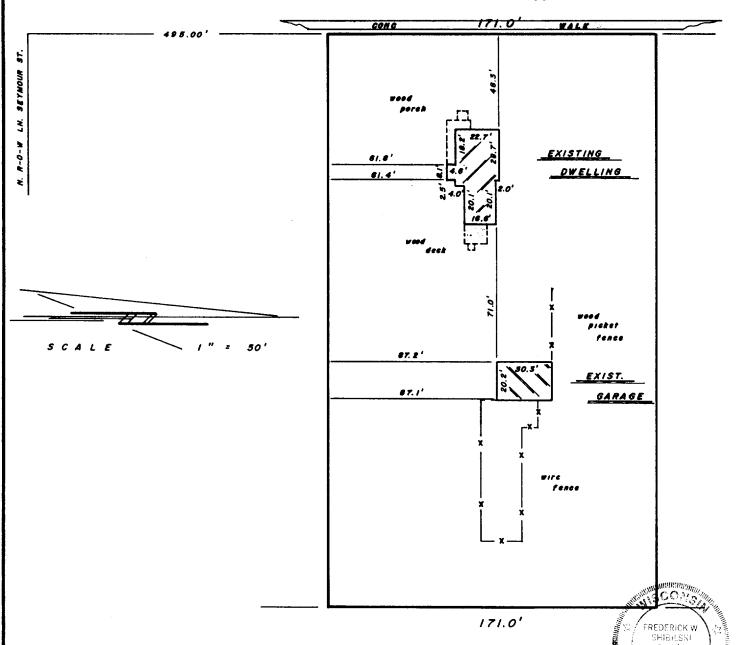

Surveyed for: G.M.A.C. MORTGAGE CORP.

"I hereby certify that I have surveyed the above described property and that the above map is a true representation thereof and shows the size and location of the property, its exterior boundaries, the location of all visible structures and dimensions of all principal buildings thereon, boundary fences, apparent easements, roadways and encroachments,

"This survey is made for the use of the present owners of the property, and also those who purchase, mortgage, or guarantee the title thereto within one year from date hereof."

MONUMENTATION BY WRITTEN AGREEMENT WITH THE ABOVE NAMED CLIENT HAS 4547 BEEN WAIVED IN ACCORDANCE WITH A-E 5.01 (1) (b) OF THE WISCONSIN ADMINISTRATIVE CODE.

NOTE: THIS IS NOT AN ORIGINAL SURVEY UNLESS THIS SEAL IS RED.

MAR. 23 , 1988

mdn , bjk

19338

SURV

WISCONSIN REGISTERED LAND SURVEYOR

DATE FIELD WORK BY

DRAWN BY

JOB NUMBER