


ABELL SURVEYING & MAPPING

DELAVAN, WISCONSIN 53115

414-728-6737

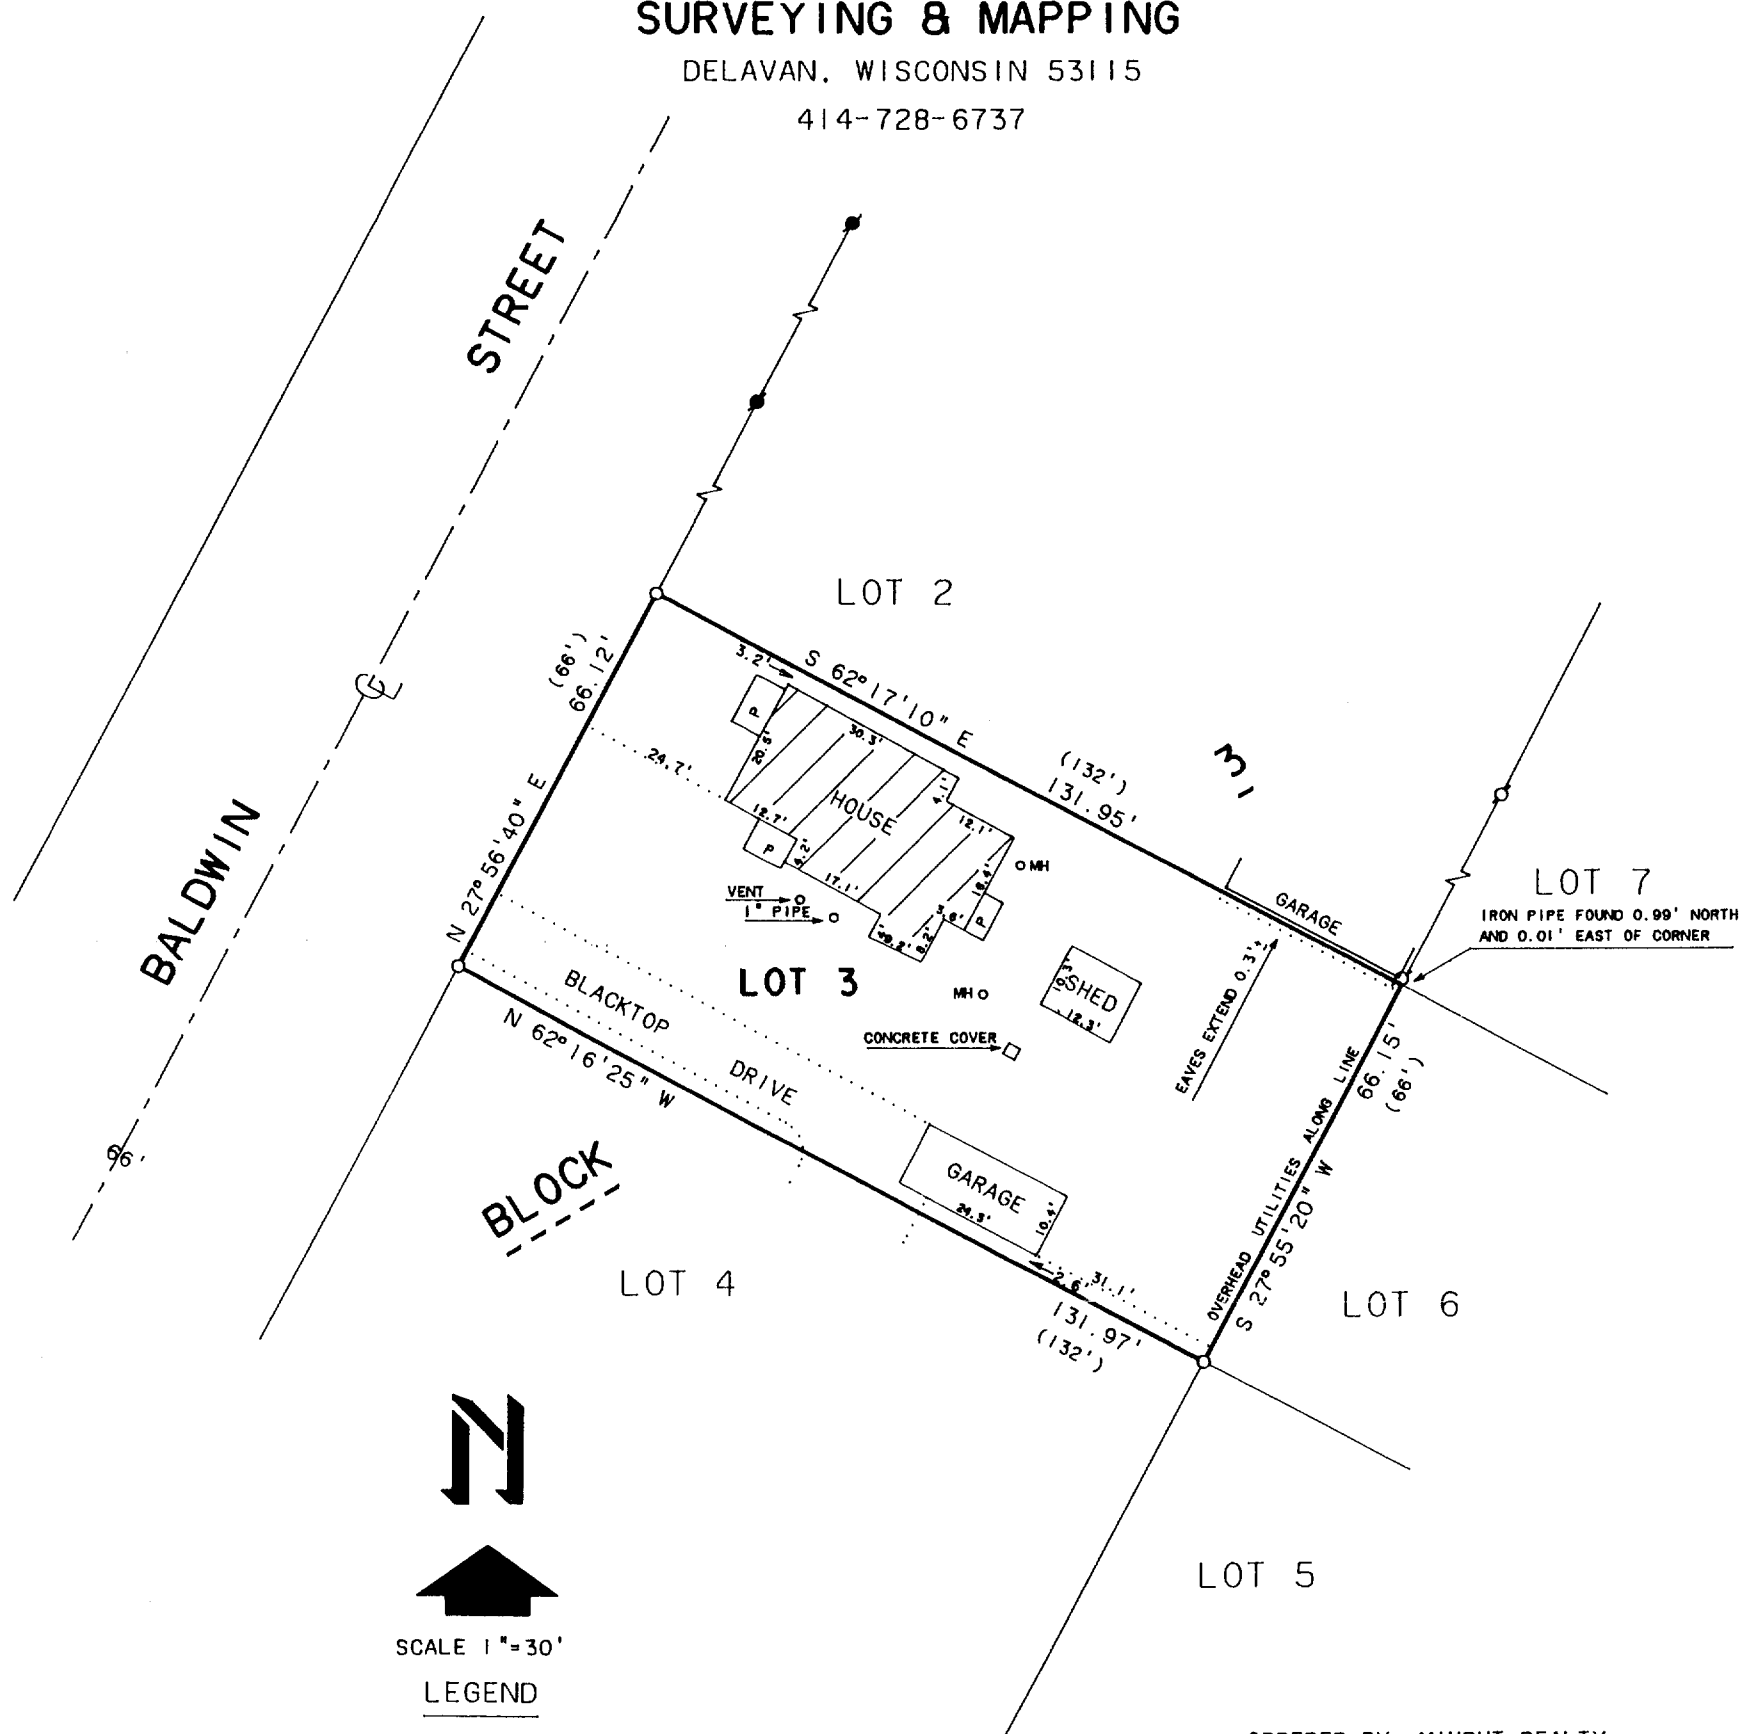


- - IRON PIPE FOUND
- - IRON ROD FOUND
- - IRON PIPE SET
- MH - MANHOLE COVER
- P - PORCH
- () - RECORDED AS

PLAT OF SURVEY OF

LOT 3, BLOCK 3, ORIGINAL PLAT, VILLAGE
OF SHARON, WALWORTH COUNTY, WISCONSIN.

NOTE: BEARINGS ARE REFERENCED TO
CERTIFIED SURVEY MAP NO. 922.

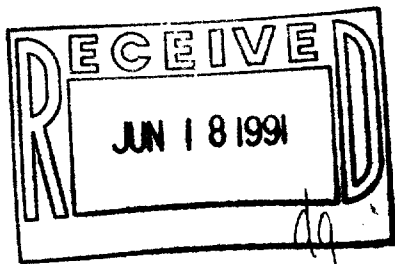

I HEREBY CERTIFY THAT I HAVE SURVEYED THE ABOVE DESCRIBED PROPERTY AND THAT THE ABOVE MAP IS A TRUE REPRESENTATION THEREOF AND SHOWS THE SIZE AND LOCATION OF THE PROPERTY, ITS EXTERIOR BOUNDARIES, THE LOCATION OF ALL VISIBLE STRUCTURES AND DIMENSIONS OF ALL PRINCIPAL BUILDINGS THEREON, BOUNDARY FENCES, APPARENT EASEMENTS, ROADWAYS AND VISIBLE ENCROACHMENTS, IF ANY, TO THE BEST OF MY KNOWLEDGE AND BELIEF.

THIS SURVEY IS MADE FOR THE USE OF THE PRESENT OWNERS OF THE PROPERTY, AND ALSO THOSE WHO PURCHASE, MORTGAGE, OR GUARANTEE THE TITLE THERETO WITHIN ONE (1) YEAR FROM DATE HEREOF.

David F. Abell

DAVID F. ABELL
WISCONSIN REGISTERED LAND SURVEYOR, S-1596

February 15, 1991

DATE JOB NUMBER - 91024
NOTE: THIS IS NOT A CERTIFIED COPY UNLESS SEALED.

008-176

UOP 00008