


DELAVAN. WISCONSIN 53115

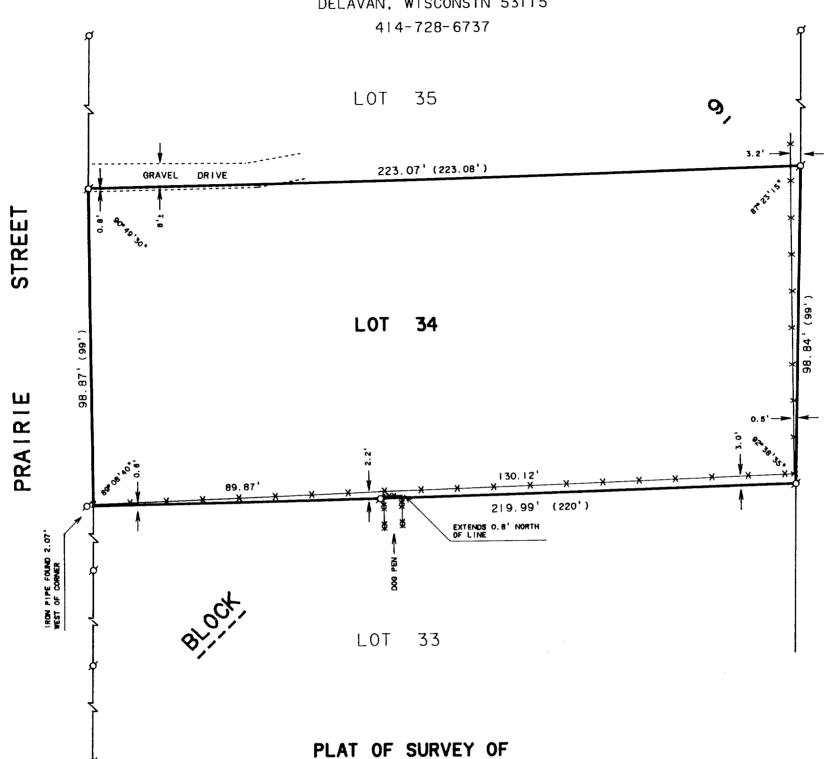

LOT 34. BLOCK 9 OF CITIZENS ADDITION TO THE VILLAGE OF SHARON, WALWORTH COUNTY, WISCONSIN.



LEGEND

Ø -IRON PIPE FOUND - X - FENCE AND REMAINS OF FENCE ()-RECORDED AS

ORDERED BY: MIKRUT REALTY 199 BALDWIN ST. SHARON, WI. 53585



I HEREBY CERTIFY THAT I HAVE SURVEYED THE ABOVE DESCRIBED PROPERTY AND THAT THE ABOVE MAP IS A TRUE REPRESENTATION THEREOF AND SHOWS THE SIZE AND LOCATION OF THE PROPERTY, ITS EXTERIOR BOUNDARIES, THE LOCATION OF ALL VISIBLE STRUCTURES AND DIMENSIONS OF ALL PRINCIPAL BUILDINGS THEREON, BOUNDARY FENCES, APPARENT EASEMENTS, ROADWAYS AND VISIBLE ENCROACHMENTS, IF ANY, TO THE BEST OF MY KNOWLEDGE AND BELIEF.

THIS SURVEY IS MADE FOR THE USE OF THE PRESENT OWNERS OF THE PROPERTY. AND ALSO THOSE WHO PURCHASE, MORTGAGE, OR GUARANTEE THE TITLE THERETO WITHIN ONE (1) YEAR

WISCONSIN REGISTERED LAND SURVEYOR, S-1596

May 3, 1991

NOTE: THIS IS NOT A CERTIFIED COPY UNLESS SEALED.