
DUNHAM SURVEYING, S.C. SURVEYING & SUBDIVIDING DELAVAN, WISCONSIN 53115

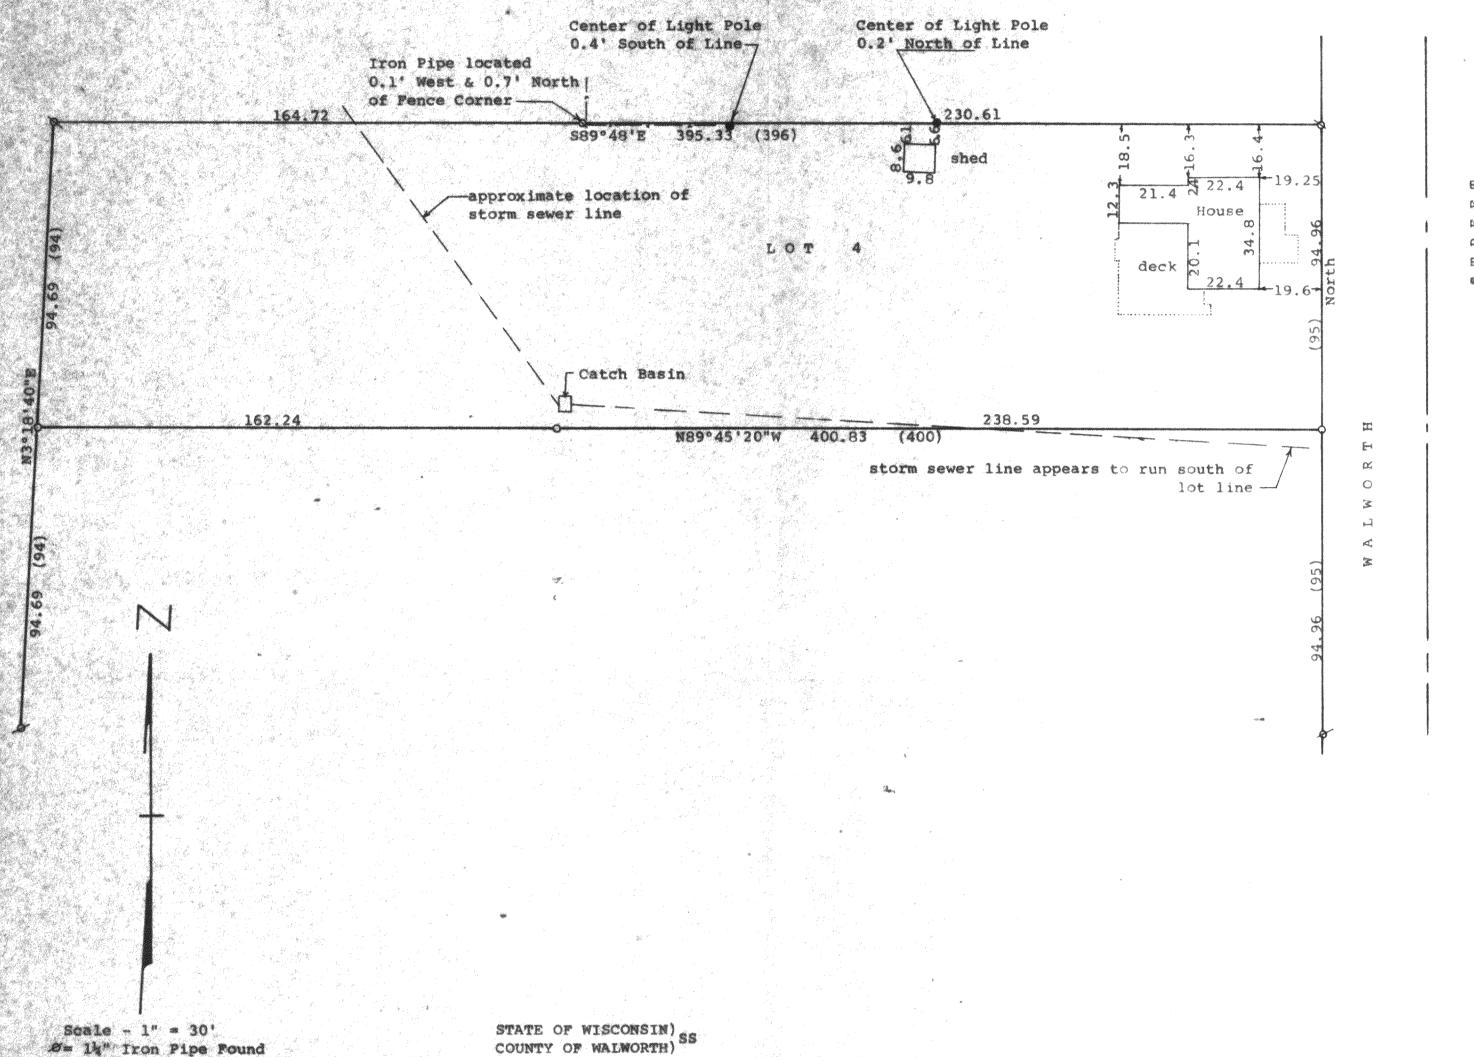

Ø= 14" Iron Pipe Found Q = 3/4" Iron Pipe Found 0 = 1" X 24" Iron Pipe Set (0.00) = recorded distance ------ fence line Bearings referenced to the west line of Walworth Street - Assumed bearing North Survey ordered by:

Danielson & Osman Realty 23 North Wisconsin Darien, WI 53114

I. George T. Dunham, Surveyor, certify that I have surveyed the

property described as follows:

Lot 4 in Block 5 of Citizens Addition to the Village of Sharon, Walworth County, Wisconsin, subject to easements of record, and that the plat shown hereon is a correct representation thereof and shows the size and location of the property, its exterior boundaries, the location of all visible structures and dimensions of all principal buildings thereon, boundary fences, apparent easements, roadways and visible encroachments, if any, and that I have surveyed the property hereon described, according to the offical records, to the best of my knowledge and belief. September 24, 1992

George Or. Dunham, Surveyor



