


Wisconsin Registered Land Surveyor S-1594

PLAT OF SURVEY

(N 88°07'24"E 148.98')

N 88°06'00" E 148.86'
118.83'

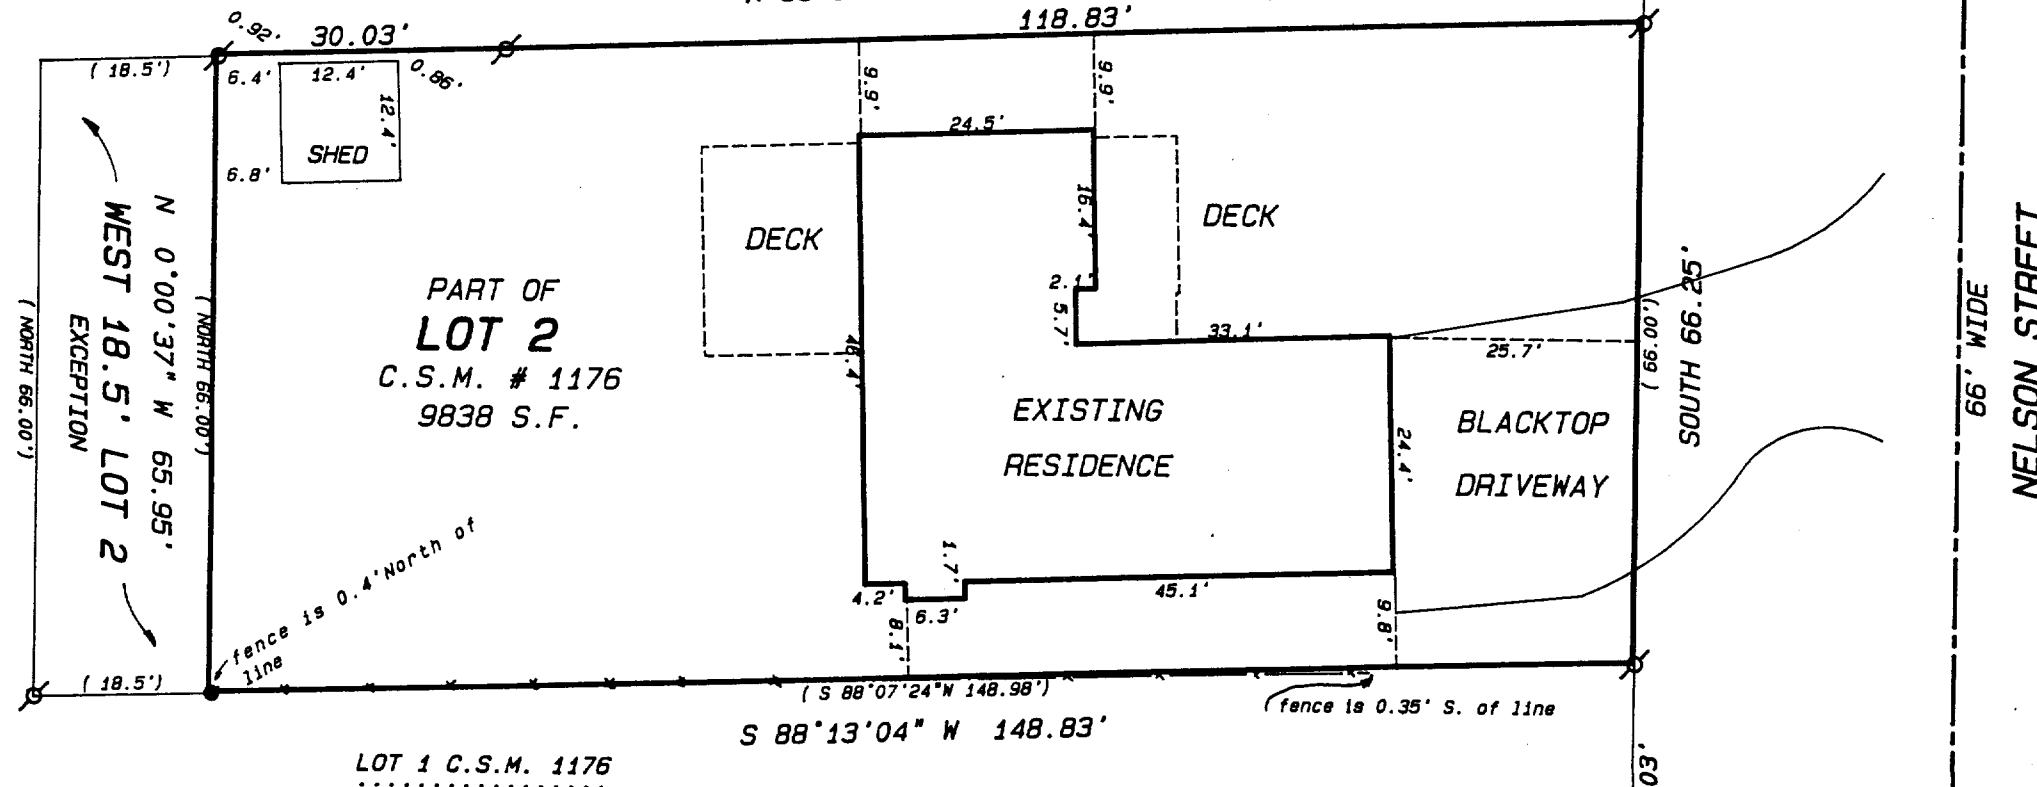

Date: 4-20-95 Job No. 95.412

SCALE: 1" = 20 FEET

Legend

- FOUND IRON PIPE
 - FOUND IRON ROD
 - FOUND BRASS CAPPED MONUMENT
 - FOUND CONCRETE MONUMENT
 - CHISEL CUT IN CONCRETE
 - SET IRON ROD, 24" LONG, WEIGHING 1.5 LBS./LINEAL FT., 3/4" DIA.
 - SET IRON ROD, 30" LONG, WEIGHING 4.5 LBS./LINEAL FT., 1-11/16" DIA.
- (xx) RECORDED AS DIMENSION
- EXISTING FENCE

UA-1176-2

008 - 275