ABERNATHY and ASSOCIATES Kenneth B. Abernathy Jr.


Wisconsin Registered Land Surveyor S-1594

W4056 Bray Road Elkhorn, Wisconsin 53121 Phone: (414) 723-4260 (office) (414) 723-4813 (residence)

PLAT OF SURVEY

LOT 2 OF BLOCK 8 OF CITIZENS ADDITION TO THE VILLAGE OF SHARON, WALWORTH COUNTY, WISCONSIN.

OWNERS: JAMES IRA STAFFORD III LINDA ELLEN STAFFORD 178 MARTIN ST. P. O. BOX 601 SHARON, WI. 53585

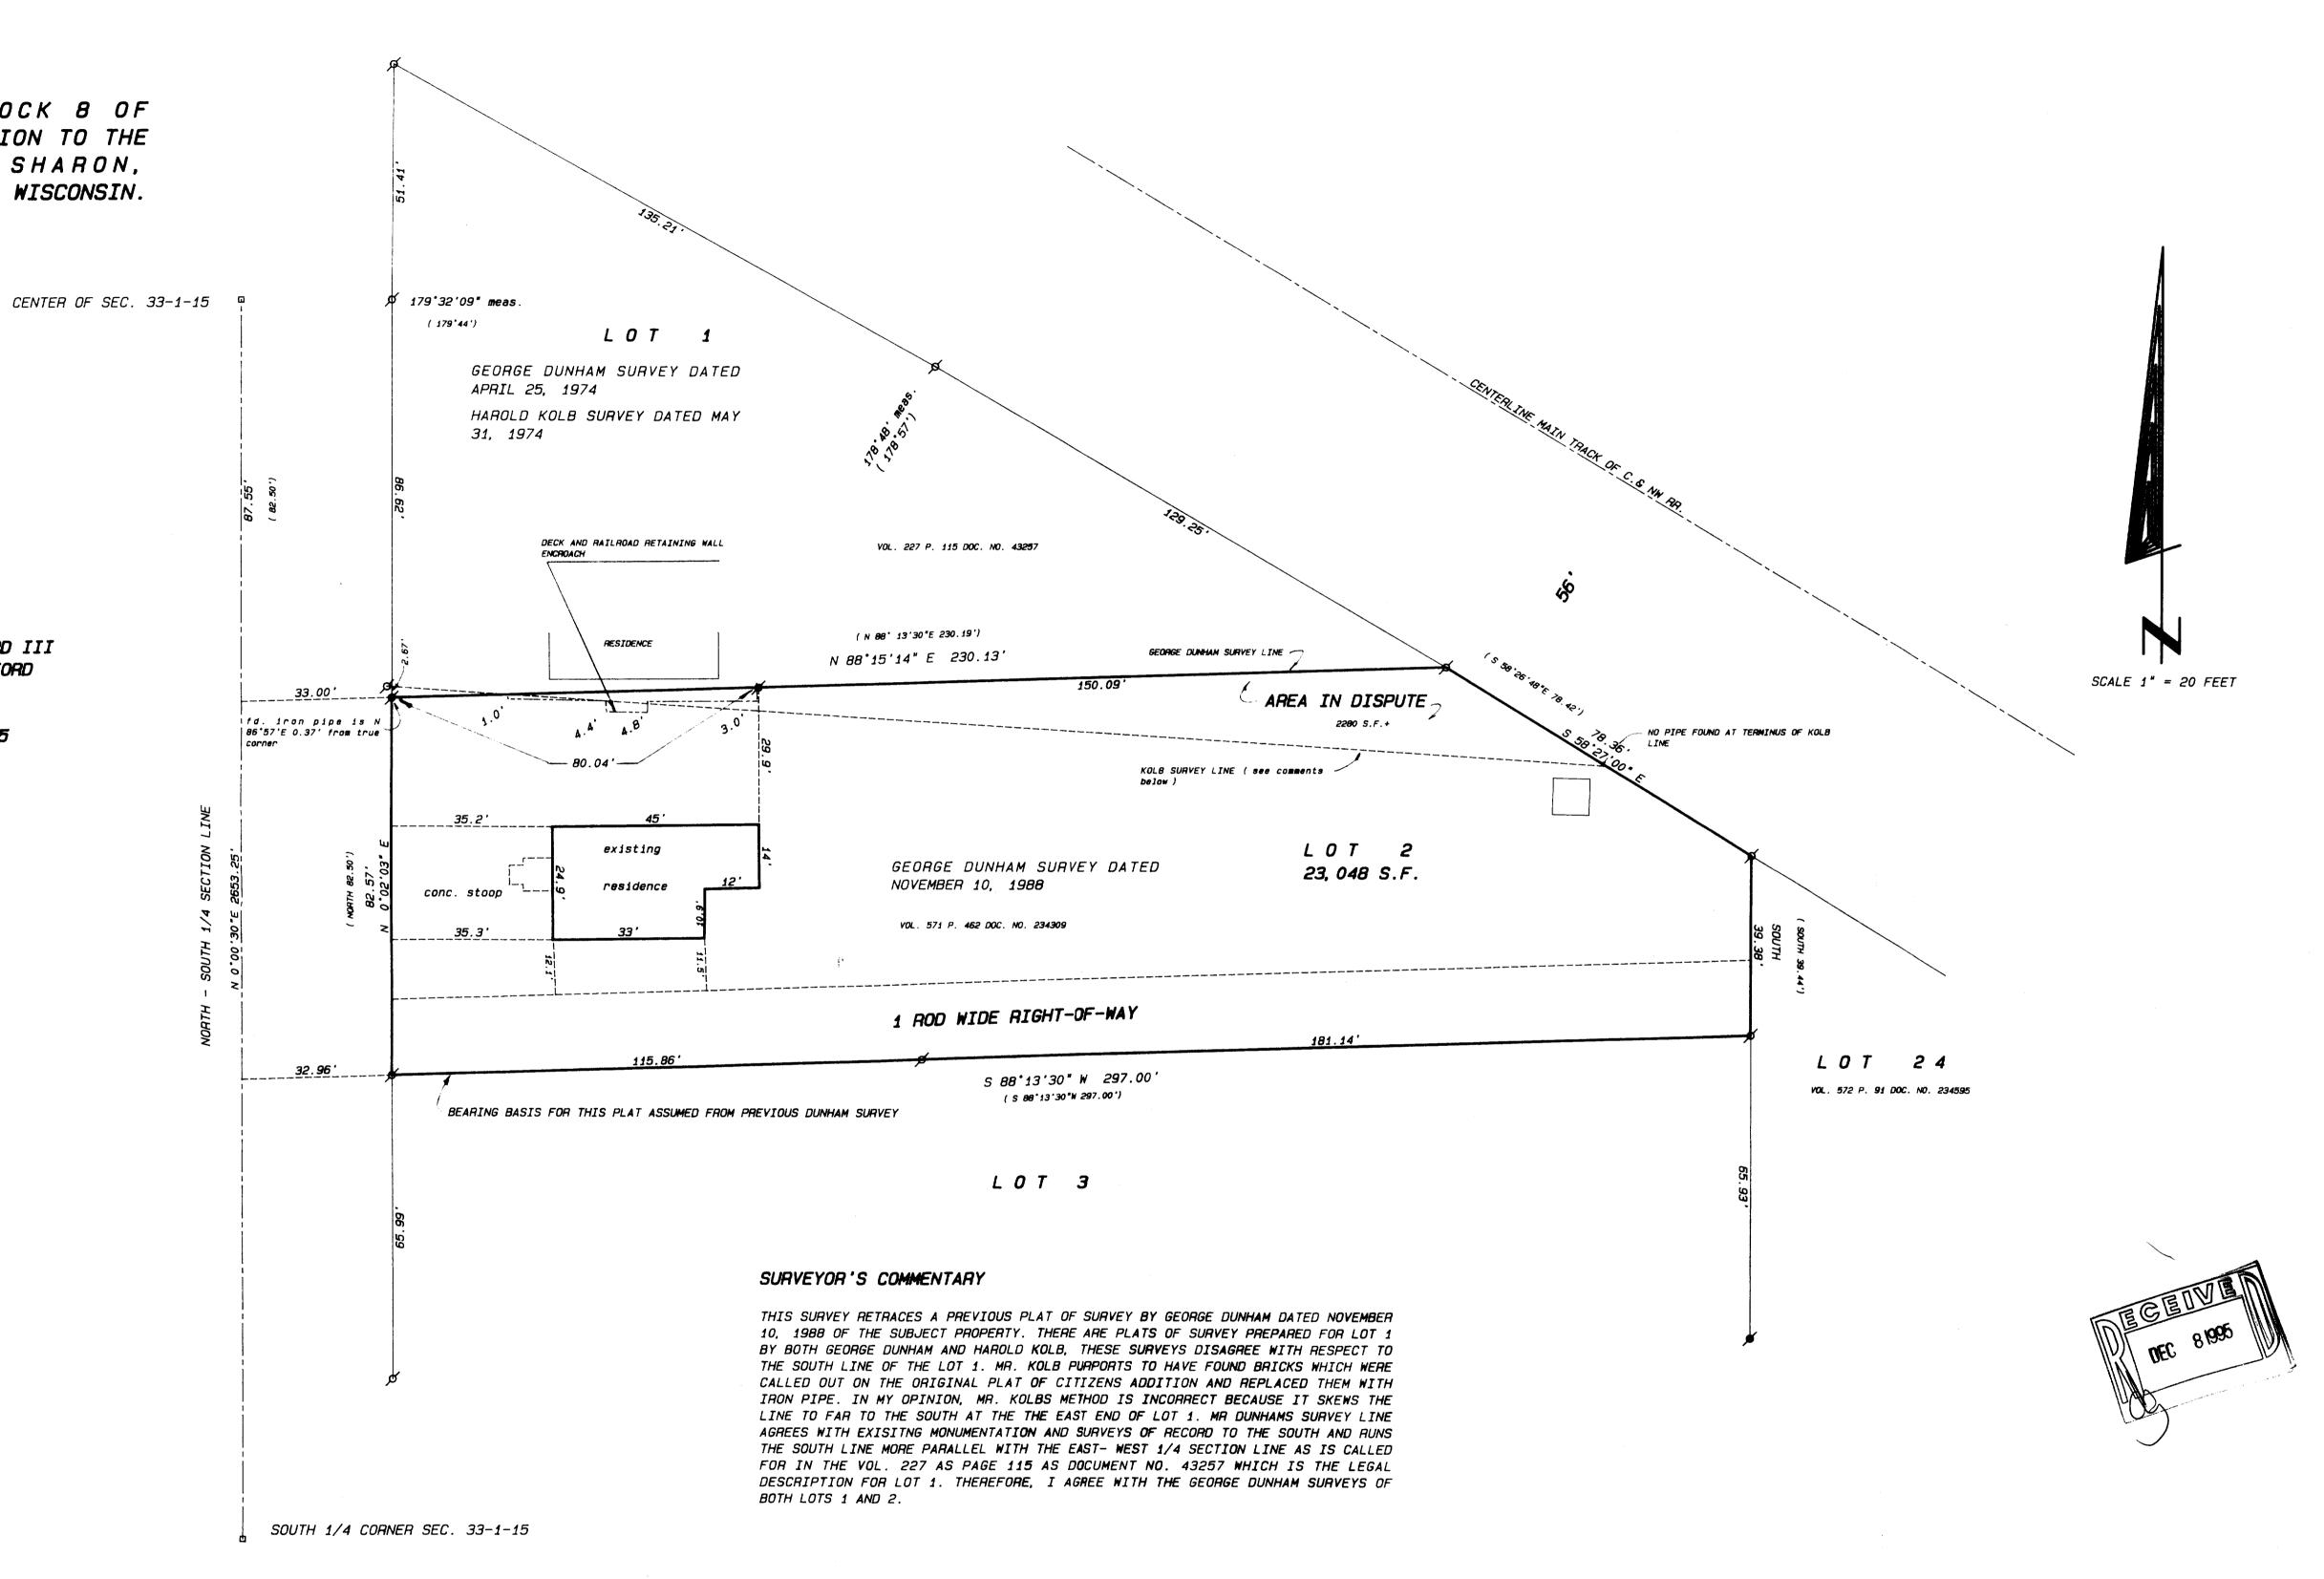

FOUND IRON PIPE FOUND IRON ROD

□ FOUND BRASS CAPPED MONUMENT

FOUND CONCRETE MONUMENT + CHISEL CUT IN CONCRETE

• SET IRON ROD, 24" LONG, WEIGHING 1.5 LBS./LINEAL FT., 3/4" DIA.

SET IRON ROD, 30" LONG, WEIGHING
 4.5 LBS./LINEAL FT., 1-11/16" DIA.

(xx) RECORDED AS DIMENSION ------ EXISTING FENCE

ABERNATHY IR

SCALE: 1"= ZO FEET

"I hereby certify that the above described property has been surveyed by me or under my direction and that the above map is a true representation thereof and shows the size and location of the property, its exterior boundaries, the location of all visible structures and dimensions of all principal buildings thereon, boundary fences, apparent easements, roadways and visible encroachments, if any."

"This survey is made for the use of the present owners of the property, and also those who purchase, mortgage, or guarantee the tipe thereto within one year from date hereof."

KENNETH B. ABERNATHY, JR. WISCONSIN REGISTERED LAND SURVEYOR,