

ABELL  
SURVEYING & MAPPING

1140 SEQUOIA STREET • DELAVAN, WISCONSIN 53115  
414-728-6737

PLEASANT

STREET

N



SCALE 1"=30'

LEGEND


- - IRON PIPE FOUND
- - IRON ROD FOUND
- - IRON PIPE SET
- ( ) - RECORDED AS

NOTE: THE BEARING OF THE SOUTH  
LINE OF PLEASANT STREET  
IS ASSUMED EAST-WEST AS  
SHOWN IN EXISTING SURVEY  
RECORDS.

PLAT OF SURVEY OF

A PROPOSED LOT LINE ADJUSTMENT TO LOT 14,  
BLOCK 9, CITIZENS ADDITION TO THE VILLAGE  
OF SHARON, WALWORTH COUNTY, WISCONSIN, AND  
DESCRIBED AS FOLLOWS: COMMENCING AT THE  
NORTHEAST CORNER OF SAID LOT 14; THENCE  
S 2°11'32" W 165.08 FEET TO THE PLACE OF  
BEGINNING; THENCE CONTINUE S 2°11'32" W  
82.54 FEET; THENCE WEST 82.59 FEET;  
THENCE N 2°06'24" E 82.54 FEET; THENCE  
EAST 82.71 FEET TO THE PLACE OF BEGINNING.  
CONTAINING 0.16 ACRES OF LAND MORE OR LESS.

BLOCK

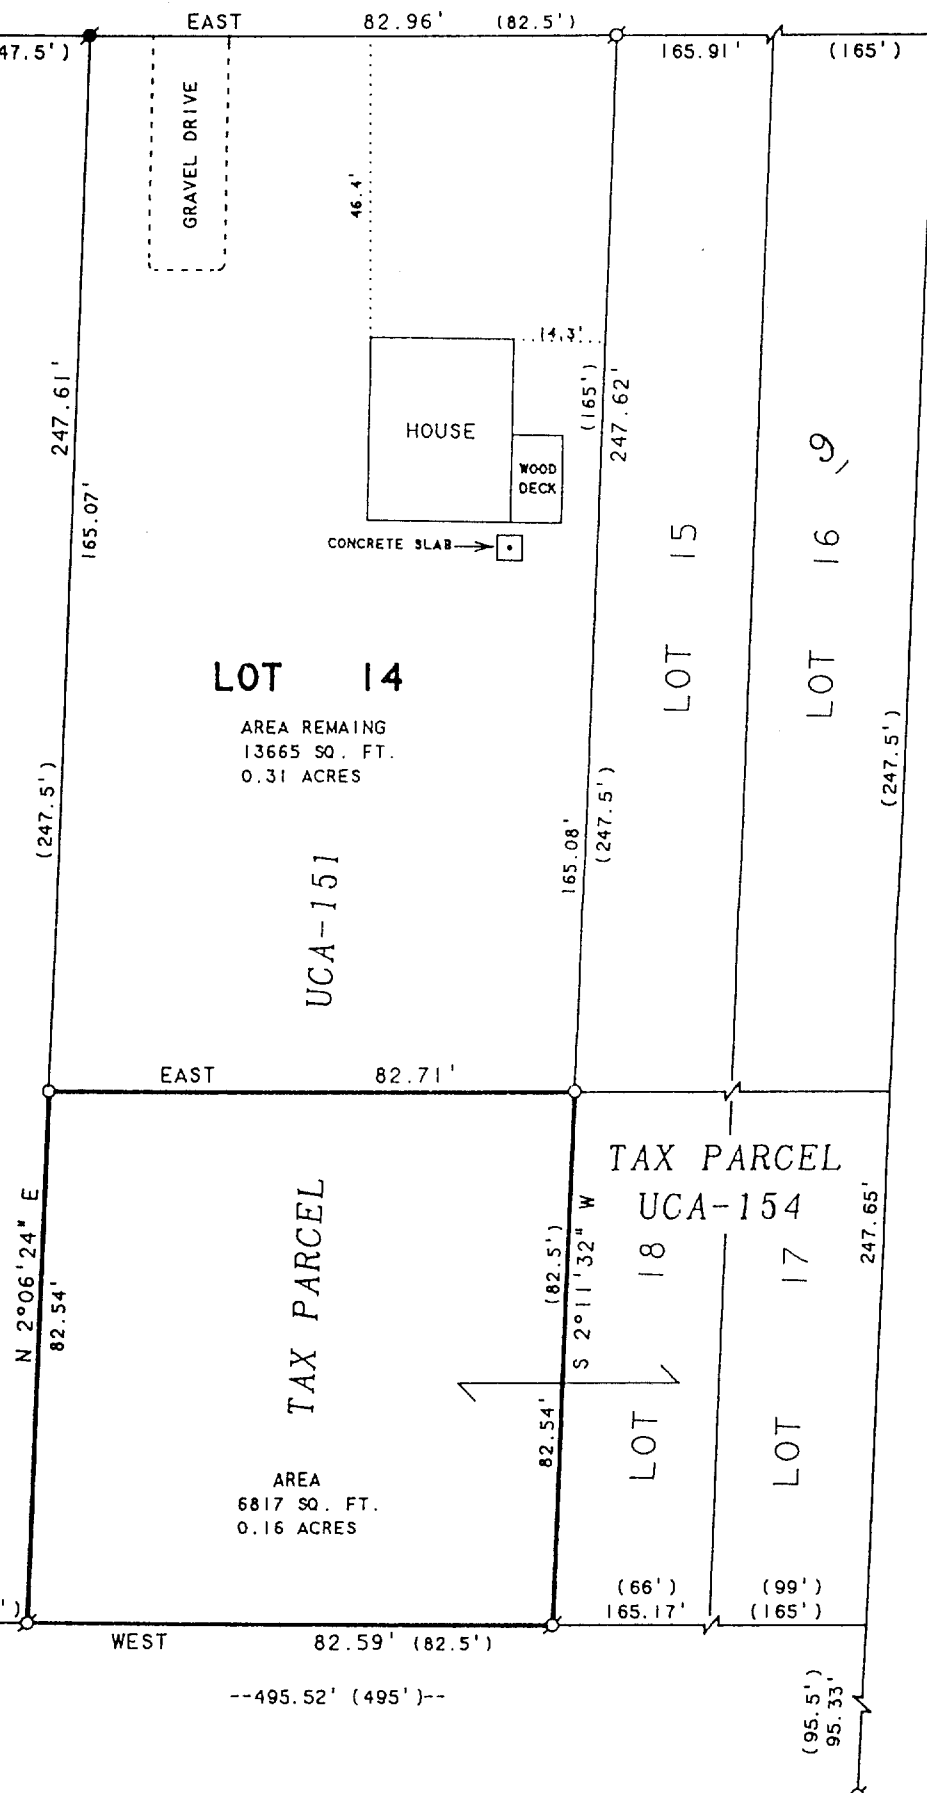

STREET

MARTIN

ORDERED BY: GAIL THOMAS  
105 PLEASANT STREET  
SHARON, WI 53585


I, DAVID F. ABELL, DO HEREBY CERTIFY THAT I HAVE SURVEYED THE PROPERTY HEREON  
DESCRIBED ACCORDING TO THE OFFICIAL RECORDS AND THAT THE PLAT HEREON IS A  
CORRECT REPRESENTATION OF THE PROPERTY LINES TO THE BEST OF MY KNOWLEDGE AND  
BELIEF.

David F. Abell

DAVID F. ABELL  
WISCONSIN REGISTERED LAND SURVEYOR, S-1596

March 17, 1997

DATE: March 17, 1997 JOB NUMBER - 92044  
NOTE: THIS IS NOT A CERTIFIED COPY UNLESS SEALED.

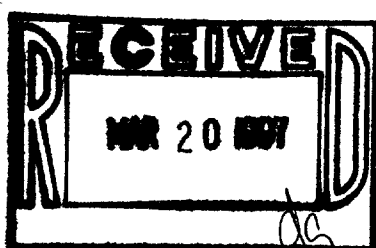

UCA-154

008-291