

ABELL  
SURVEYING & MAPPING  
1140 SEQUOIA STREET • DELAVAN, WISCONSIN 53115  
414-728-6737

GRACE STREET

STREET

MARTIN STREET

STREET

BLOCK

PROSPECT

BLOCK

LOT 1

N



SCALE 1"=30'

LEGEND

- - IRON PIPE FOUND
- - CONCRETE MONUMENT FOUND
- ✕ - CUT CROSS IN CONCRETE SIDEWALK FOUND
- ✕ - CROSS CUT IN CONCRETE SIDEWALK SET
- WP - WOOD PORCH
- ( ) - RECORDED AS

AS SURVEYED BY GEORGE T. DUNHAM  
JUNE 2, 1986

TAX PARCEL  
UHA-13  
AREA 0.85 ACRES

LOT 2

LOT 6

LOT 5

LOT 4

LOT 3

LOT 2

AS SURVEYED BY GEORGE T. DUNHAM  
NOVEMBER 13, 1991


NOTE: BEARINGS ARE REFERENCED TO  
EXISTING SURVEY RECORDS.

ORDERED BY: ADVANTAGE REALTY  
5319 ROUTE 14 SOUTH  
HARVARD, IL 60033

PLAT OF SURVEY OF

LOTS 3-5, BLOCK 3, HOARDS ADDITION TO THE VILLAGE  
OF SHARON, WALWORTH COUNTY, WISCONSIN.

RAILROAD RIGHT-OF-WAY

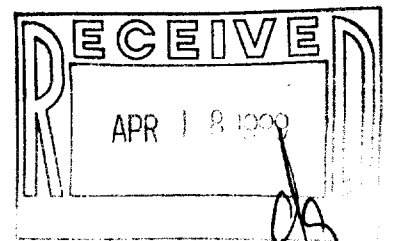

I HEREBY CERTIFY THAT I HAVE SURVEYED THE ABOVE DESCRIBED PROPERTY AND THAT THE ABOVE MAP IS A TRUE REPRESENTATION THEREOF AND SHOWS THE SIZE AND LOCATION OF THE PROPERTY, ITS EXTERIOR BOUNDARIES, THE LOCATION OF ALL VISIBLE STRUCTURES AND DIMENSIONS OF ALL PRINCIPAL BUILDINGS THEREON, BOUNDARY FENCES, APPARENT EASEMENTS, ROADWAYS AND VISIBLE ENCROACHMENTS, IF ANY, TO THE BEST OF MY KNOWLEDGE AND BELIEF.

THIS SURVEY IS MADE FOR THE USE OF THE PRESENT OWNERS OF THE PROPERTY, AND ALSO THOSE WHO PURCHASE, MORTGAGE, OR GUARANTEE THE TITLE THERETO WITHIN ONE (1) YEAR FROM DATE HEREON.

David F. Abell  
DAVID F. ABELL  
WISCONSIN REGISTERED LAND SURVEYOR, S-1596

March 25, 1999

DATE: THIS IS NOT A CERTIFIED COPY UNLESS SEALED

JOB NUMBER - 99028

UHA-13

008-321