
ABERNATHY and ASSOCIATES

Kenneth B. Abernathy Jr. Wisconsin Registered Land Surveyor S-1594 W4056 Bray Road Elkhorn, Wisconsin 53121 Phone: (414) 723-4260 (office) (414) 723-4813 (residence)

PLAT OF SURVEY

LOT 2 OF BLOCK 8 OF CITIZENS ADDITION TO THE VILLAGE OF SHARON, WALWORTH COUNTY, WISCONSIN.

OWNERS: JAMES IRA STAFFORD III LINDA ELLEN STAFFORD 178 MARTIN ST. P. O. BOX 601 SHARON, WI. 53585

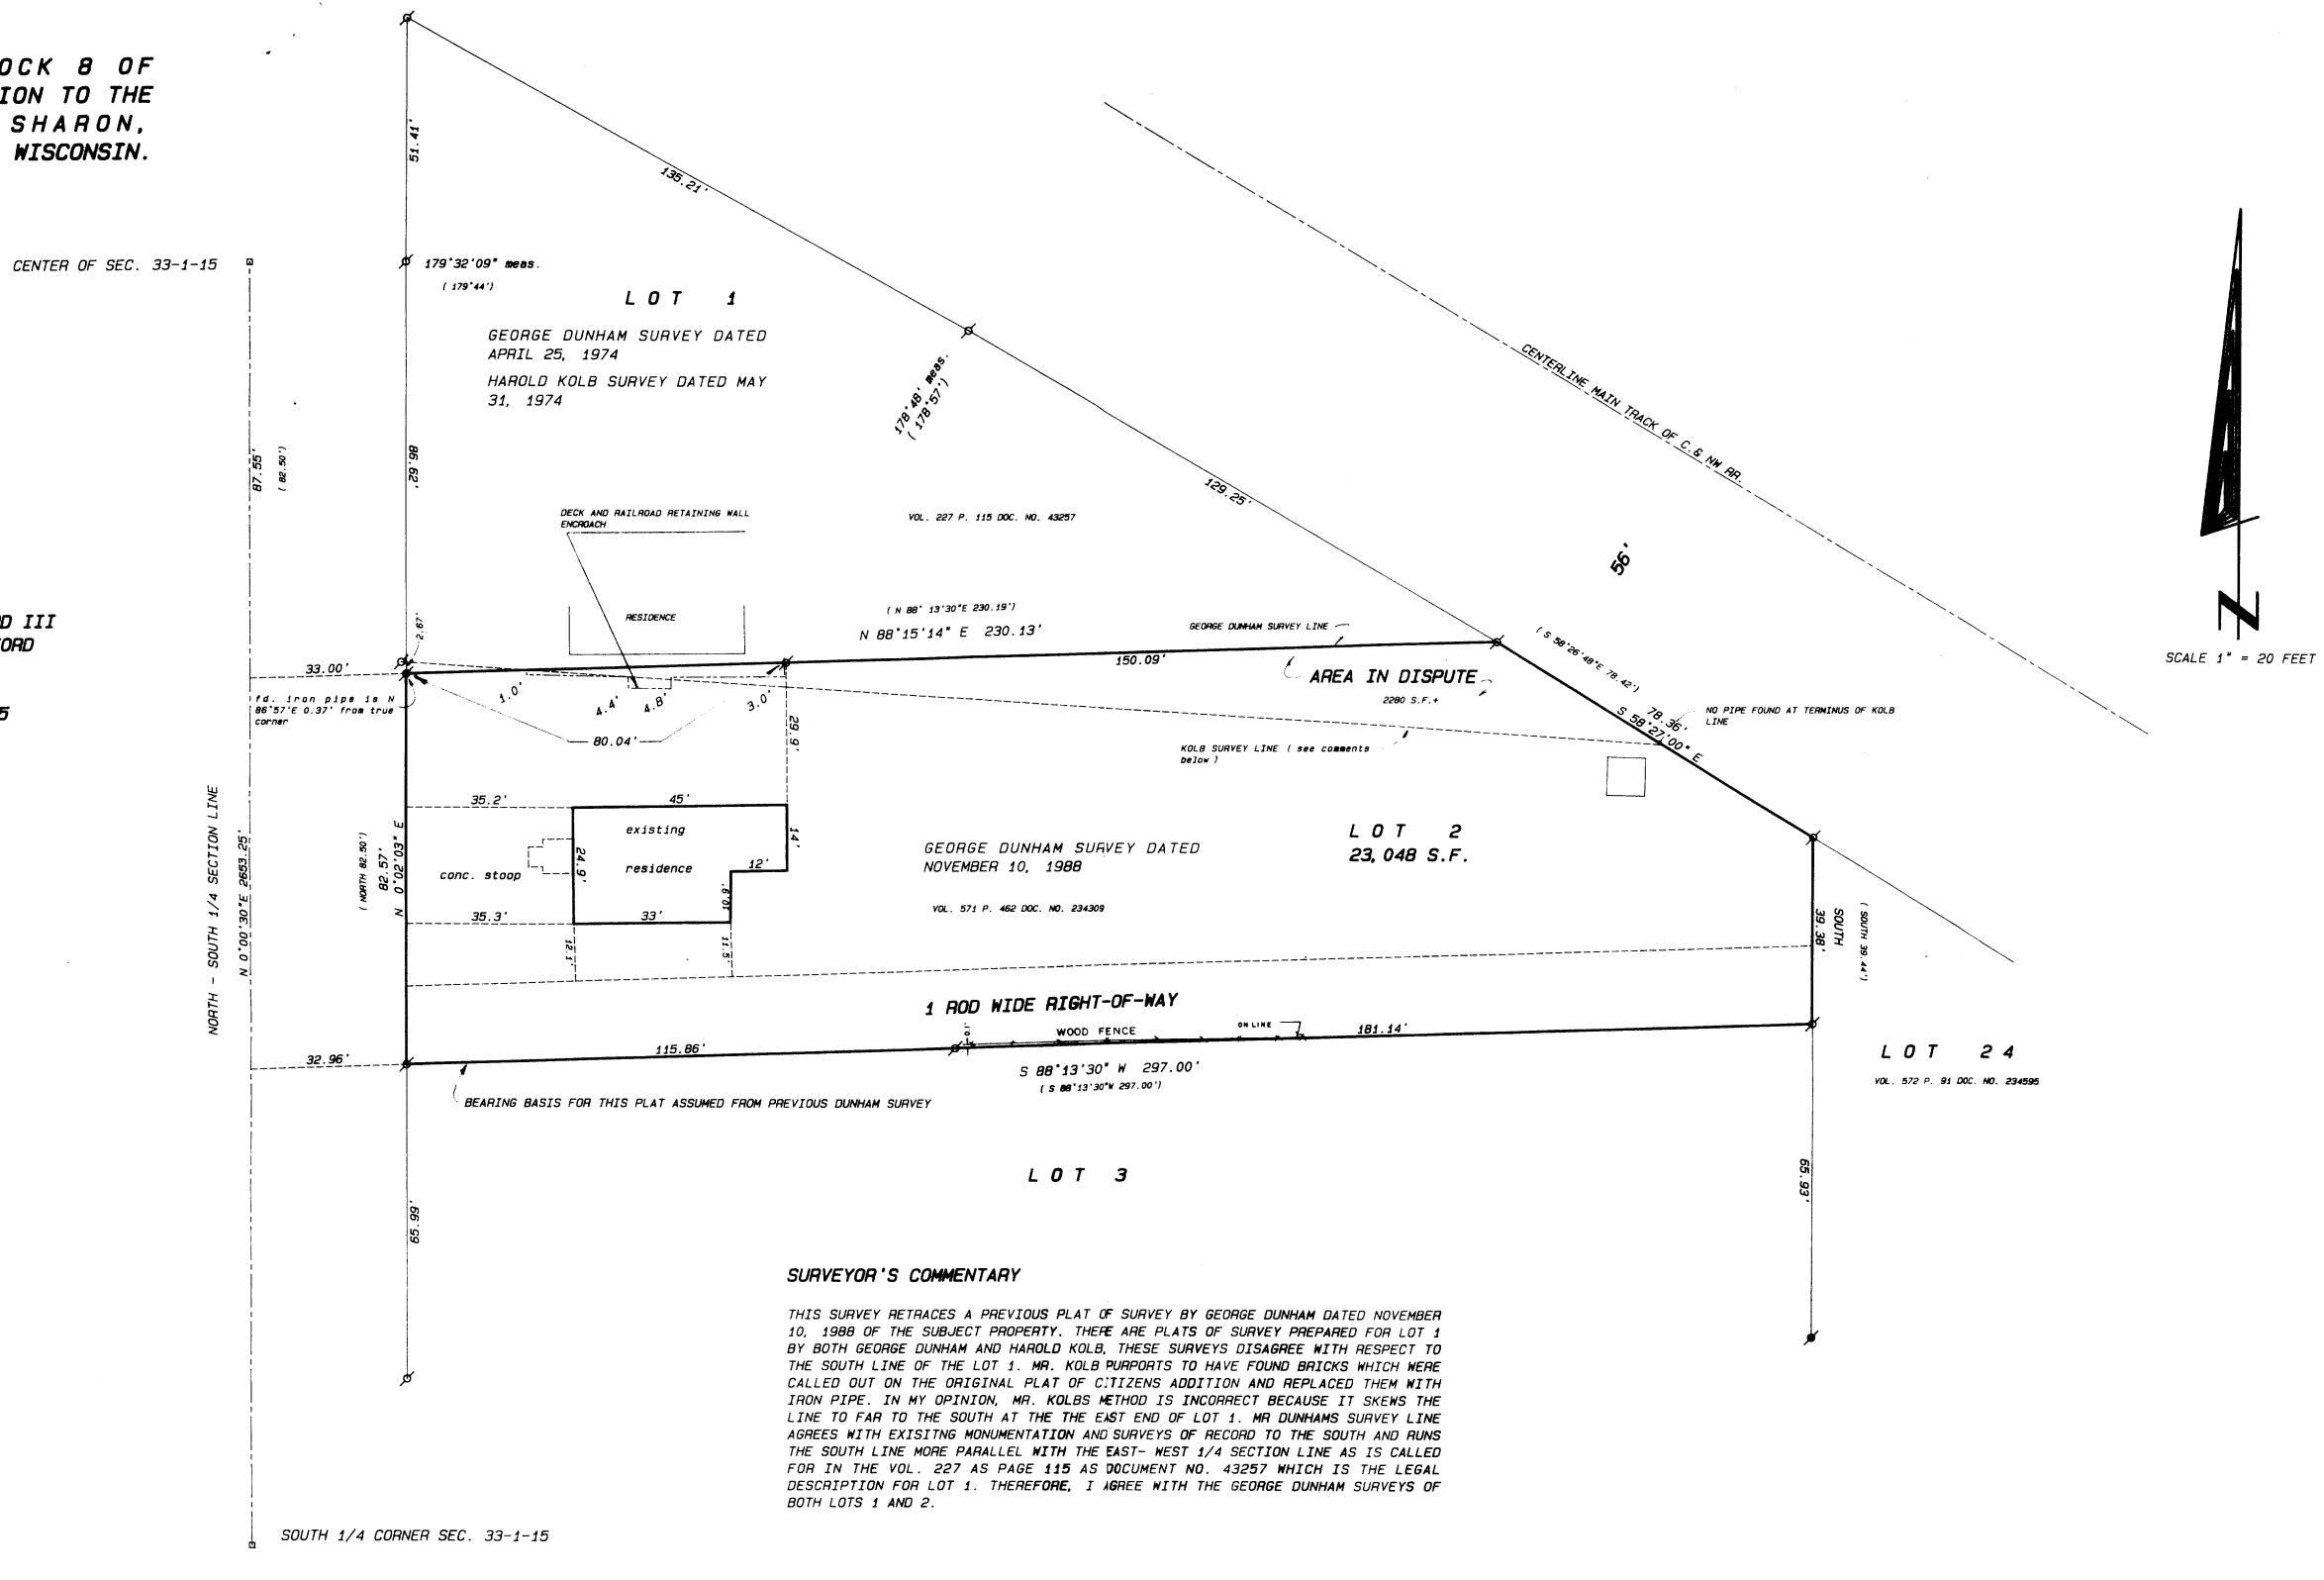

Legend

FOUND IRON PIPE FOUND IRON ROD

☐ FOUND BRASS CAPPED MONUMENT FOUND CONCRETE MONUMENT

+ CHISEL CUT IN CONCRETE

SET IRON ROD, 24" LONG, WEIGHING
 1.5 LBS, LINEAL FT., 3 4" DIA.

SET IRON ROD, 30" LONG, WEIGHING 4.5 LBS. LINEAL FT., 1 11/16" DIA.

(xx) RECORDED AS DIMENSION -x--x- EXISTING FENCE

KENNETH B C JEERNATHY IR

SCALE: 1"= ZO FEET

I hereby certify that the above described property has been surveyed In fereby certify that the above described property has been surveyed by me or under my direction and that the above map is a true representation thereof and shows the size and location of the property its exterior boundaries the location of all visible structures and dimensions of all principal buildings thereon, boundary fences, apparent easements, roadways and visible encroachments, if any

This survey is made for the use of the present owners of the property
and also those who purchase, mortgage, or guarantee the tive thereto within one year from date hereof

KENNETH B. ABERNATHY, JR. WISCONSIN RECISTERED LAND SURVEYOR,
REVISED: 11/20/98 S-1594 Date: 8-18-95

5 544 EKHORM