


1140 SEQUOIA STREET • DELAVAN, WISCONSIN 53115
414-728-6737



NOTE: BEARINGS ARE REFERENCED TO
EXISTING SURVEY RECORDS.

(INTERSECTION OF THE CENTERLINE OF PRAIRIE STREET →
AND THE SOUTH LINE OF SECTION 33-1-15)

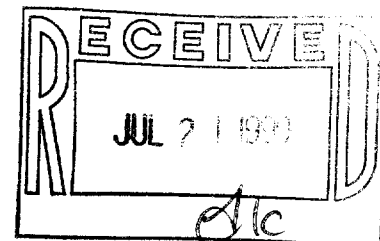

LEGEND

- I HEREBY CERTIFY THAT I HAVE SURVEYED THE ABOVE DESCRIBED PROPERTY AND THAT THE ABOVE MAP IS A TRUE REPRESENTATION THEREOF AND SHOWS THE SIZE AND LOCATION OF THE PROPERTY, ITS EXTERIOR BOUNDARIES, THE LOCATION OF ALL VISIBLE STRUCTURES AND DIMENSIONS OF ALL PRINCIPAL BUILDINGS THEREON, BOUNDARY FENCES, APPARENT EASEMENTS, ROADWAYS AND VISIBLE ENCROACHMENTS, IF ANY, TO THE BEST OF MY KNOWLEDGE AND BELIEF.

David F. Rhell

April 22, 1999

DATE _____ JOB NUMBER - 99054
NOTE: THIS IS NOT A CERTIFIED COPY UNLESS SEALED.

UCA-192C

008-324