




Plat of Survey

of

A parcel of land described in a Warranty Deed recorded in Vol. 213 on Page 475 as Document No. 34379 as shown below:

A parcel of land located in Lot 19, Block 3 of Citizen's Addition to the Village of Sharon, Walworth County, Wisconsin, described as follows to-wit: Beginning on the North line of Church Street in said Village of Sharon at a point located 35.00 feet East of the West line of said Lot 19; thence North parallel with the West line of said Lot 19, 105.00 feet; thence East parallel with the North line of Church Street 141.00 feet; thence South parallel with the West line of said Lot 19, 105.00 feet; thence West along the North line of said Church Street 141.00 feet to the place of beginning.

Surveyed for: **RE/MAX Lakes Area Realtors**
1815 North Shore Drive
Delavan, Wisconsin 53115

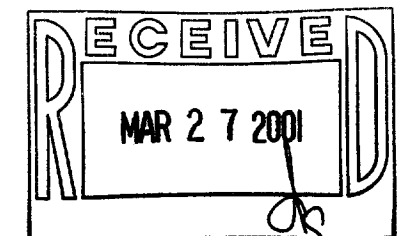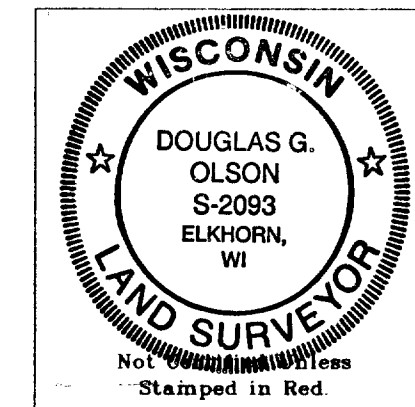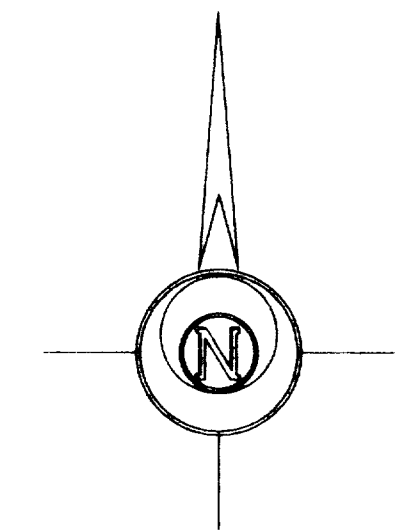


- Notes: 1) This survey plat is not certified unless signed and sealed in red ink.
2) This survey is subject to Wisconsin lien laws. This Plat of Survey is the notice of intent to file lien. Lien waiver required.

Copyright © 1999 by Jensen & Olson Land Surveying, LLC.


All rights reserved. No part of this survey plat may be reproduced or transmitted in any form by any means - graphic, electronic, or mechanical, including photocopying, tracing, or information storage and retrieval systems - without permission in writing from Douglas G. Olson, Jensen & Olson Land Surveying, LLC.

I hereby certify that I have surveyed the above described property and the map hereon is correct to the best of my professional knowledge and belief and shows the size and location of the property, its exterior boundaries, the location and dimensions of all visible structures thereon, boundary fences, apparent easements and roadways and visible encroachments, if any.
This survey is made for the exclusive use of the present owners of property, and also those who purchase, mortgage or guarantee title thereto, within one year from the date hereof.

Douglas G. Olson
Wisconsin Registered Land Surveyor - 2093

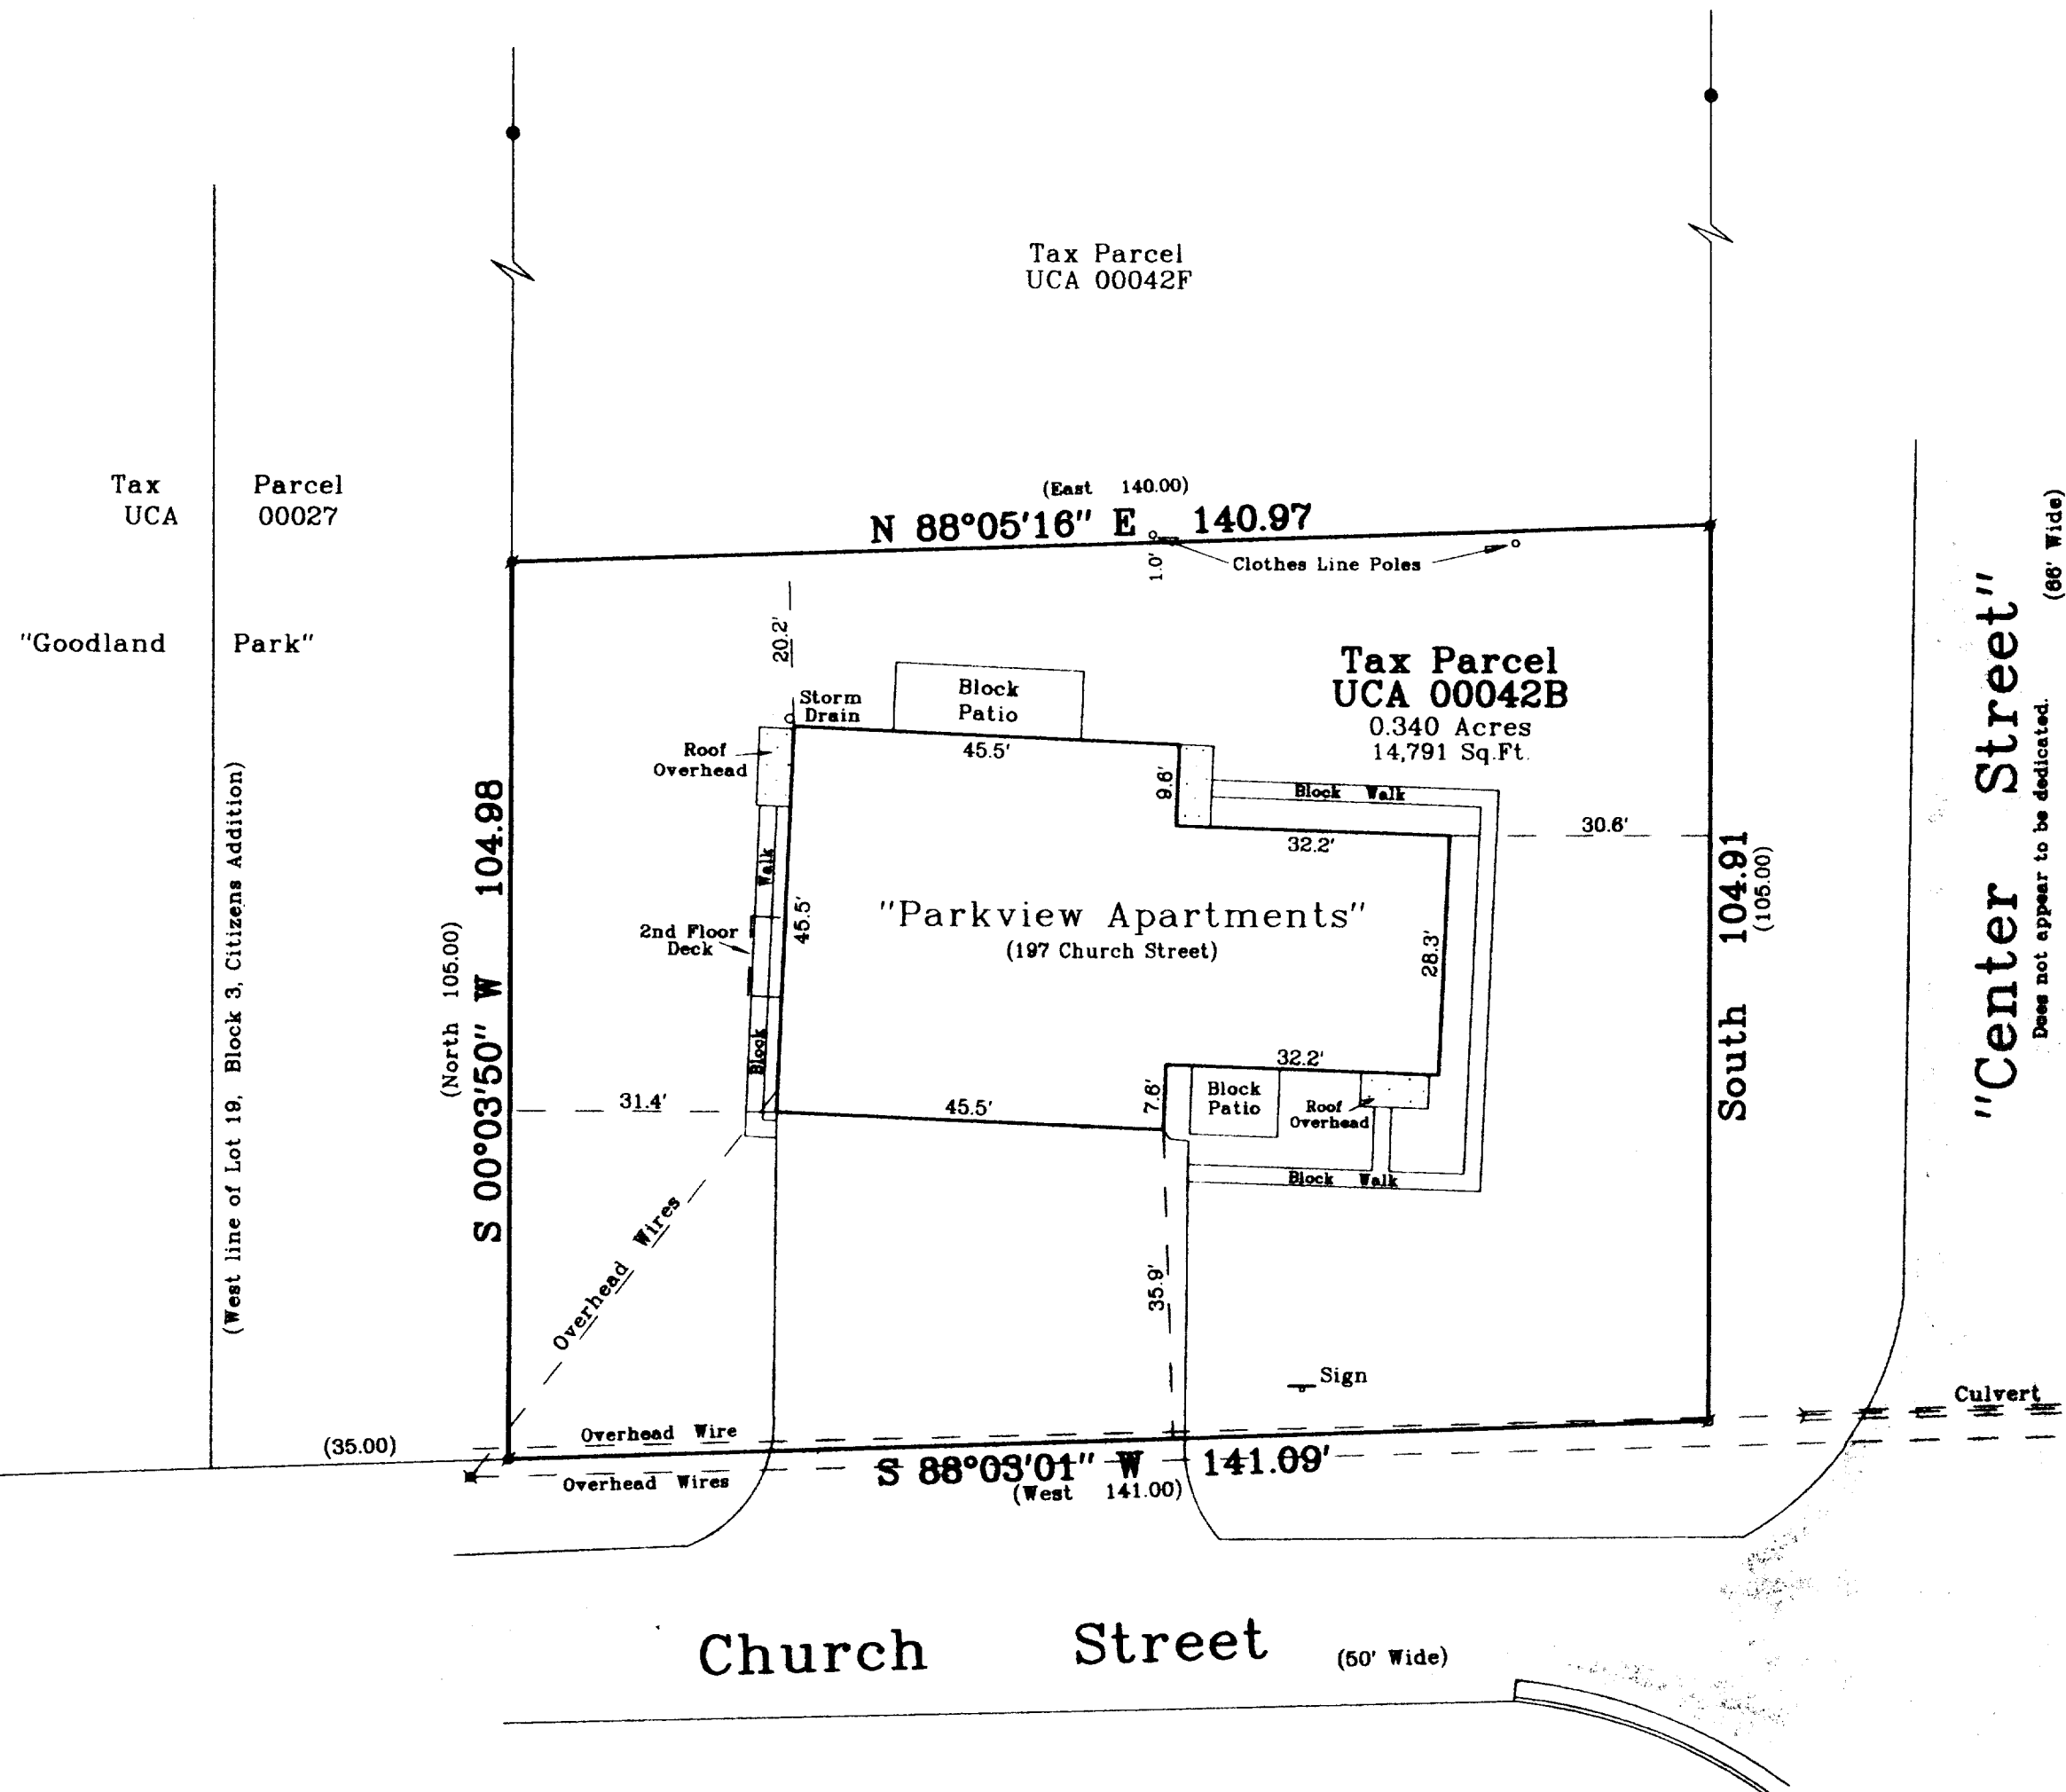

Survey Date: Nov. 19, 1999.
Revisions:

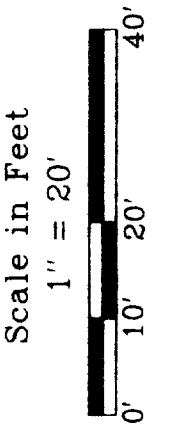

Jensen & Olson Land Surveying, LLC
45 South Wisconsin Street
Elkhorn, Wisconsin 53121
P.O. Box 322
Telephone (262) 723-3434
Facsimile (262) 723-8044

Legend
Found Iron Pipe
Found Iron Rod
Recorded Information
Utility Pole
Concrete Surface
Asphalt Surface

Sheet 1 of 1 Sheets
Job Reference Number
1999.133

1999.133

UCA-42B

008-348