
## SURVEYING & SUBDIVIDING DELAVAN, WISCONSEN 53115

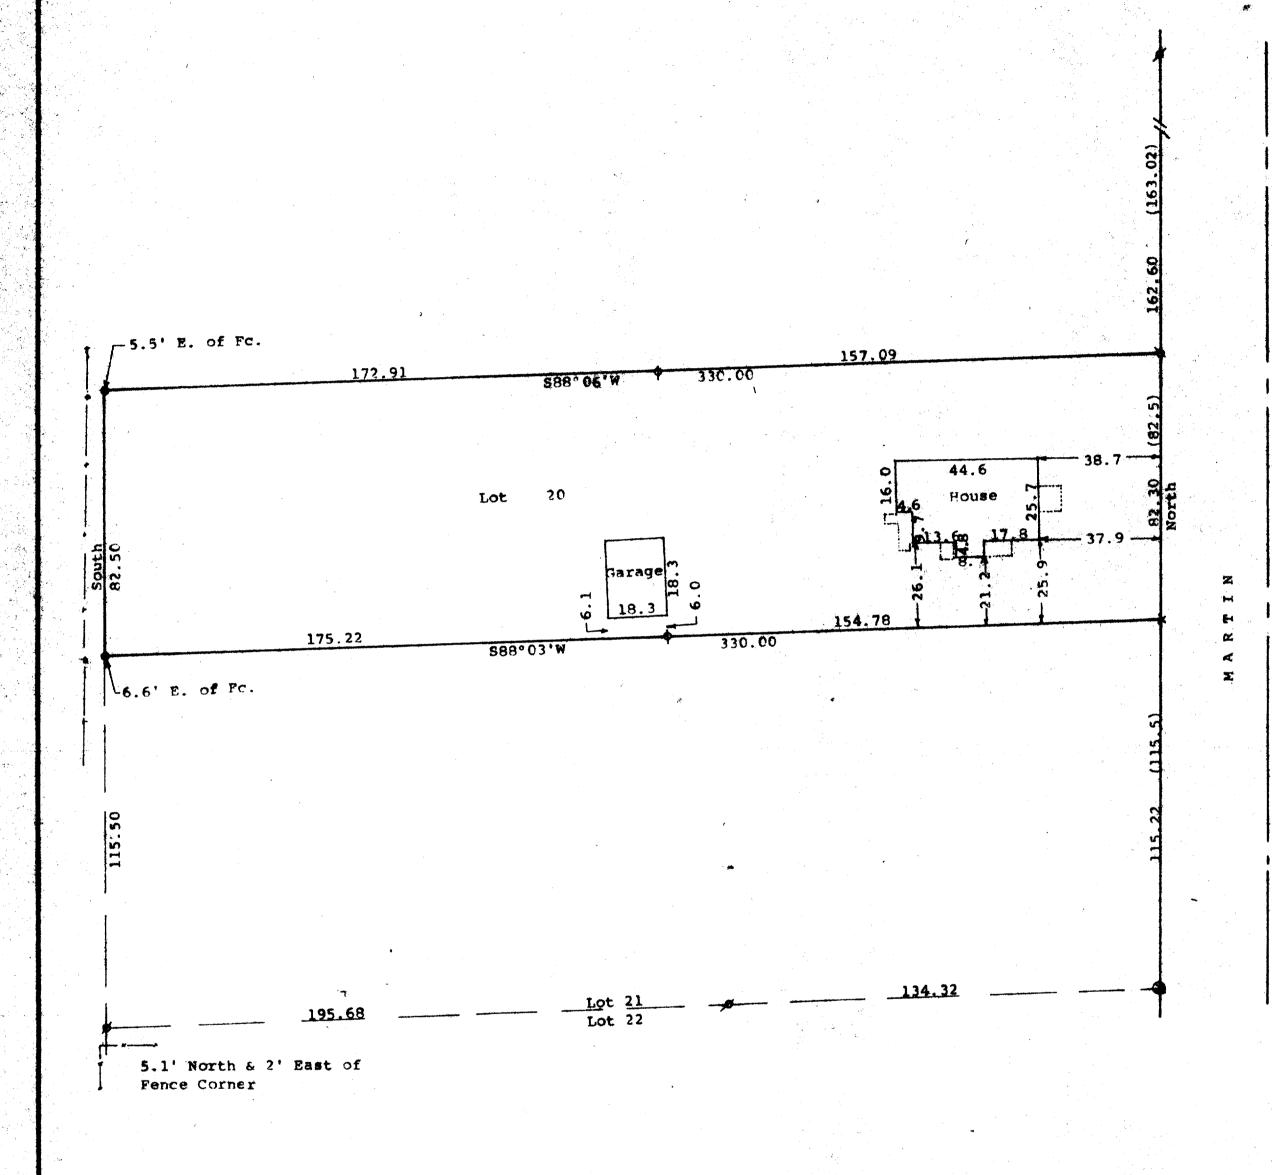

STATE OF WISCONSIN) SS

I, George T. Dunham, Surveyor, Surveyor, certify that I have surveyed the property described as follows:

Lot 20 in Block 9 of Citizens Addition to the Village of Sharon, Walworth County, Wisconsin

and that the plat shown hereon is a correct representation thereof and shows

the size and location of the property, its exterior boundaries, the location of all visible structures and dimensions of all principal buildings thereon, boundary fences, apparent easements, roadways and visible encroachments, if any, and that I have surveyed the property hereon described, according to the

official records, to the best of my knowledge and belief. November 25, 1996

George W. Dunham, Surveyor



Scale - 1" = 30'@ = Found cross in Con. x = Cut cross in Gonc.  $\mathscr{A} = 3/4$ " Iron Pipe Pound N= 3/4" Iron Pipe Set

• = 1" Iron Pipe Set Φ = '5" Iron Pipe Set Bearings reference to the west line

of Martin Street with the assumed bearing of North. Survey ordered by: The Rauland Agency 118 Kenosha Street Walworth, WI 53184

> (0.00)= recorded distance

