
## ABELL SURVEYING & MAPPING

1140 SEQUOIA STREET • DELAVAN, WISCONSIN 53115 262-728-6737

## PLEASANT

 $\mathcal{S}$   $\mathcal{T}$   $\mathcal{R}$   $\mathcal{E}$   $\mathcal{E}$   $\mathcal{T}$ 

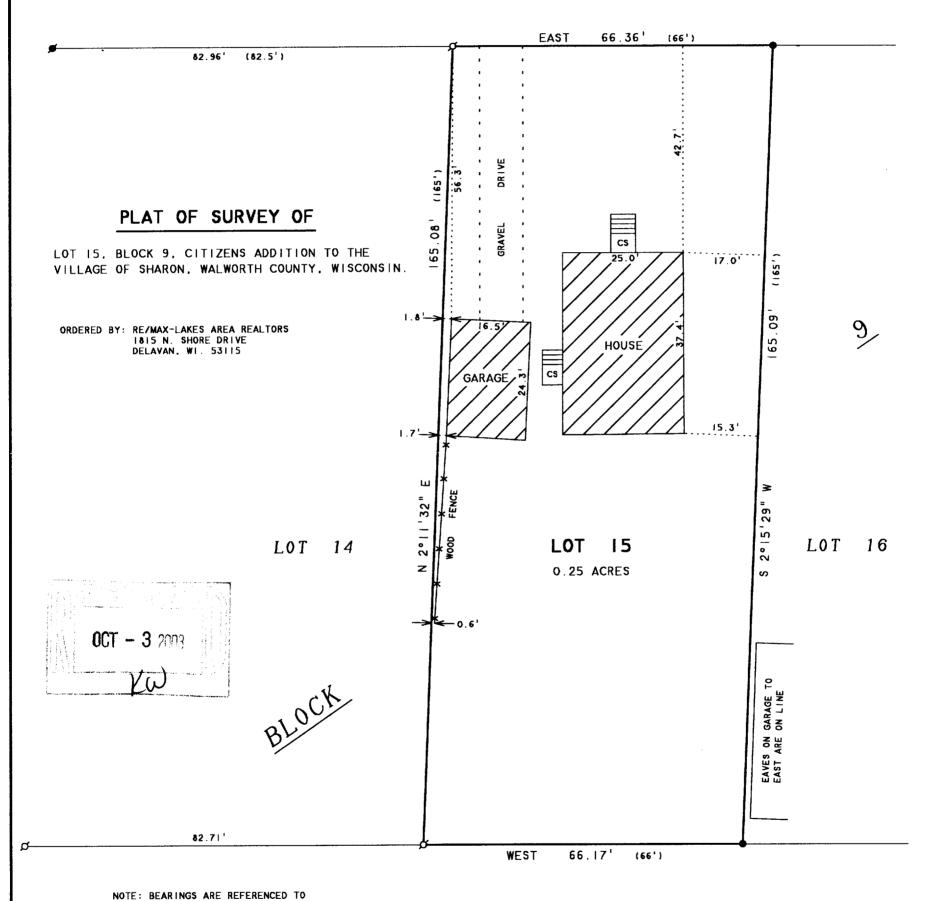

EXISTING SURVEY RECORDS.





SCALE | " = 20"

LEGEND

Ø - IRON PIPE FOUND Ø - IRON ROD FOUND ● - IRON ROD SET CS - CONCRETE STOOP ( ) - RECORDED AS I HEREBY CERTIFY THAT I HAVE SURVEYED THE ABOVE DESCRIBED PROPERTY AND THAT THE ABOVE MAP IS A TRUE REPRESENTATION THEREOF AND SHOWS THE SIZE AND LOCATION OF THE PROPERTY, ITS EXTERIOR BOUNDARIES, THE LOCATION OF ALL VISIBLE STRUCTURES AND DIMENSIONS OF ALL PRINCIPAL BUILDINGS THEREON. BOUNDARY FENCES. APPARENT EASEMENTS, ROADWAYS AND VISIBLE ENCROACHMENTS, IF ANY, TO THE BEST OF MY KNOWLEDGE AND BELIEF.

THIS SURVEY IS MADE FOR THE USE OF THE PRESENT OWNERS OF THE PROPERTY, AND ALSO THOSE WHO PURCHASE, MORTGAGE, OR GUARANTEE THE TITLE THERETO WITHIN ONE (I) YEAR FROM DATE HEREON.

Land 7. Chill

DAVID F. ABELL WISCONSIN REGISTERED LAND SURVEYOR, S-1596

July 22, 2003

DATE JOB NUMBER - 03/06 NOTE: THIS IS NOT A CERTIFIED COPY UNLESS SEALED.