



PHONE 262-537-48  
FAX 262-537-42

WISE AND NELSON NORTH SIDE ADDITION

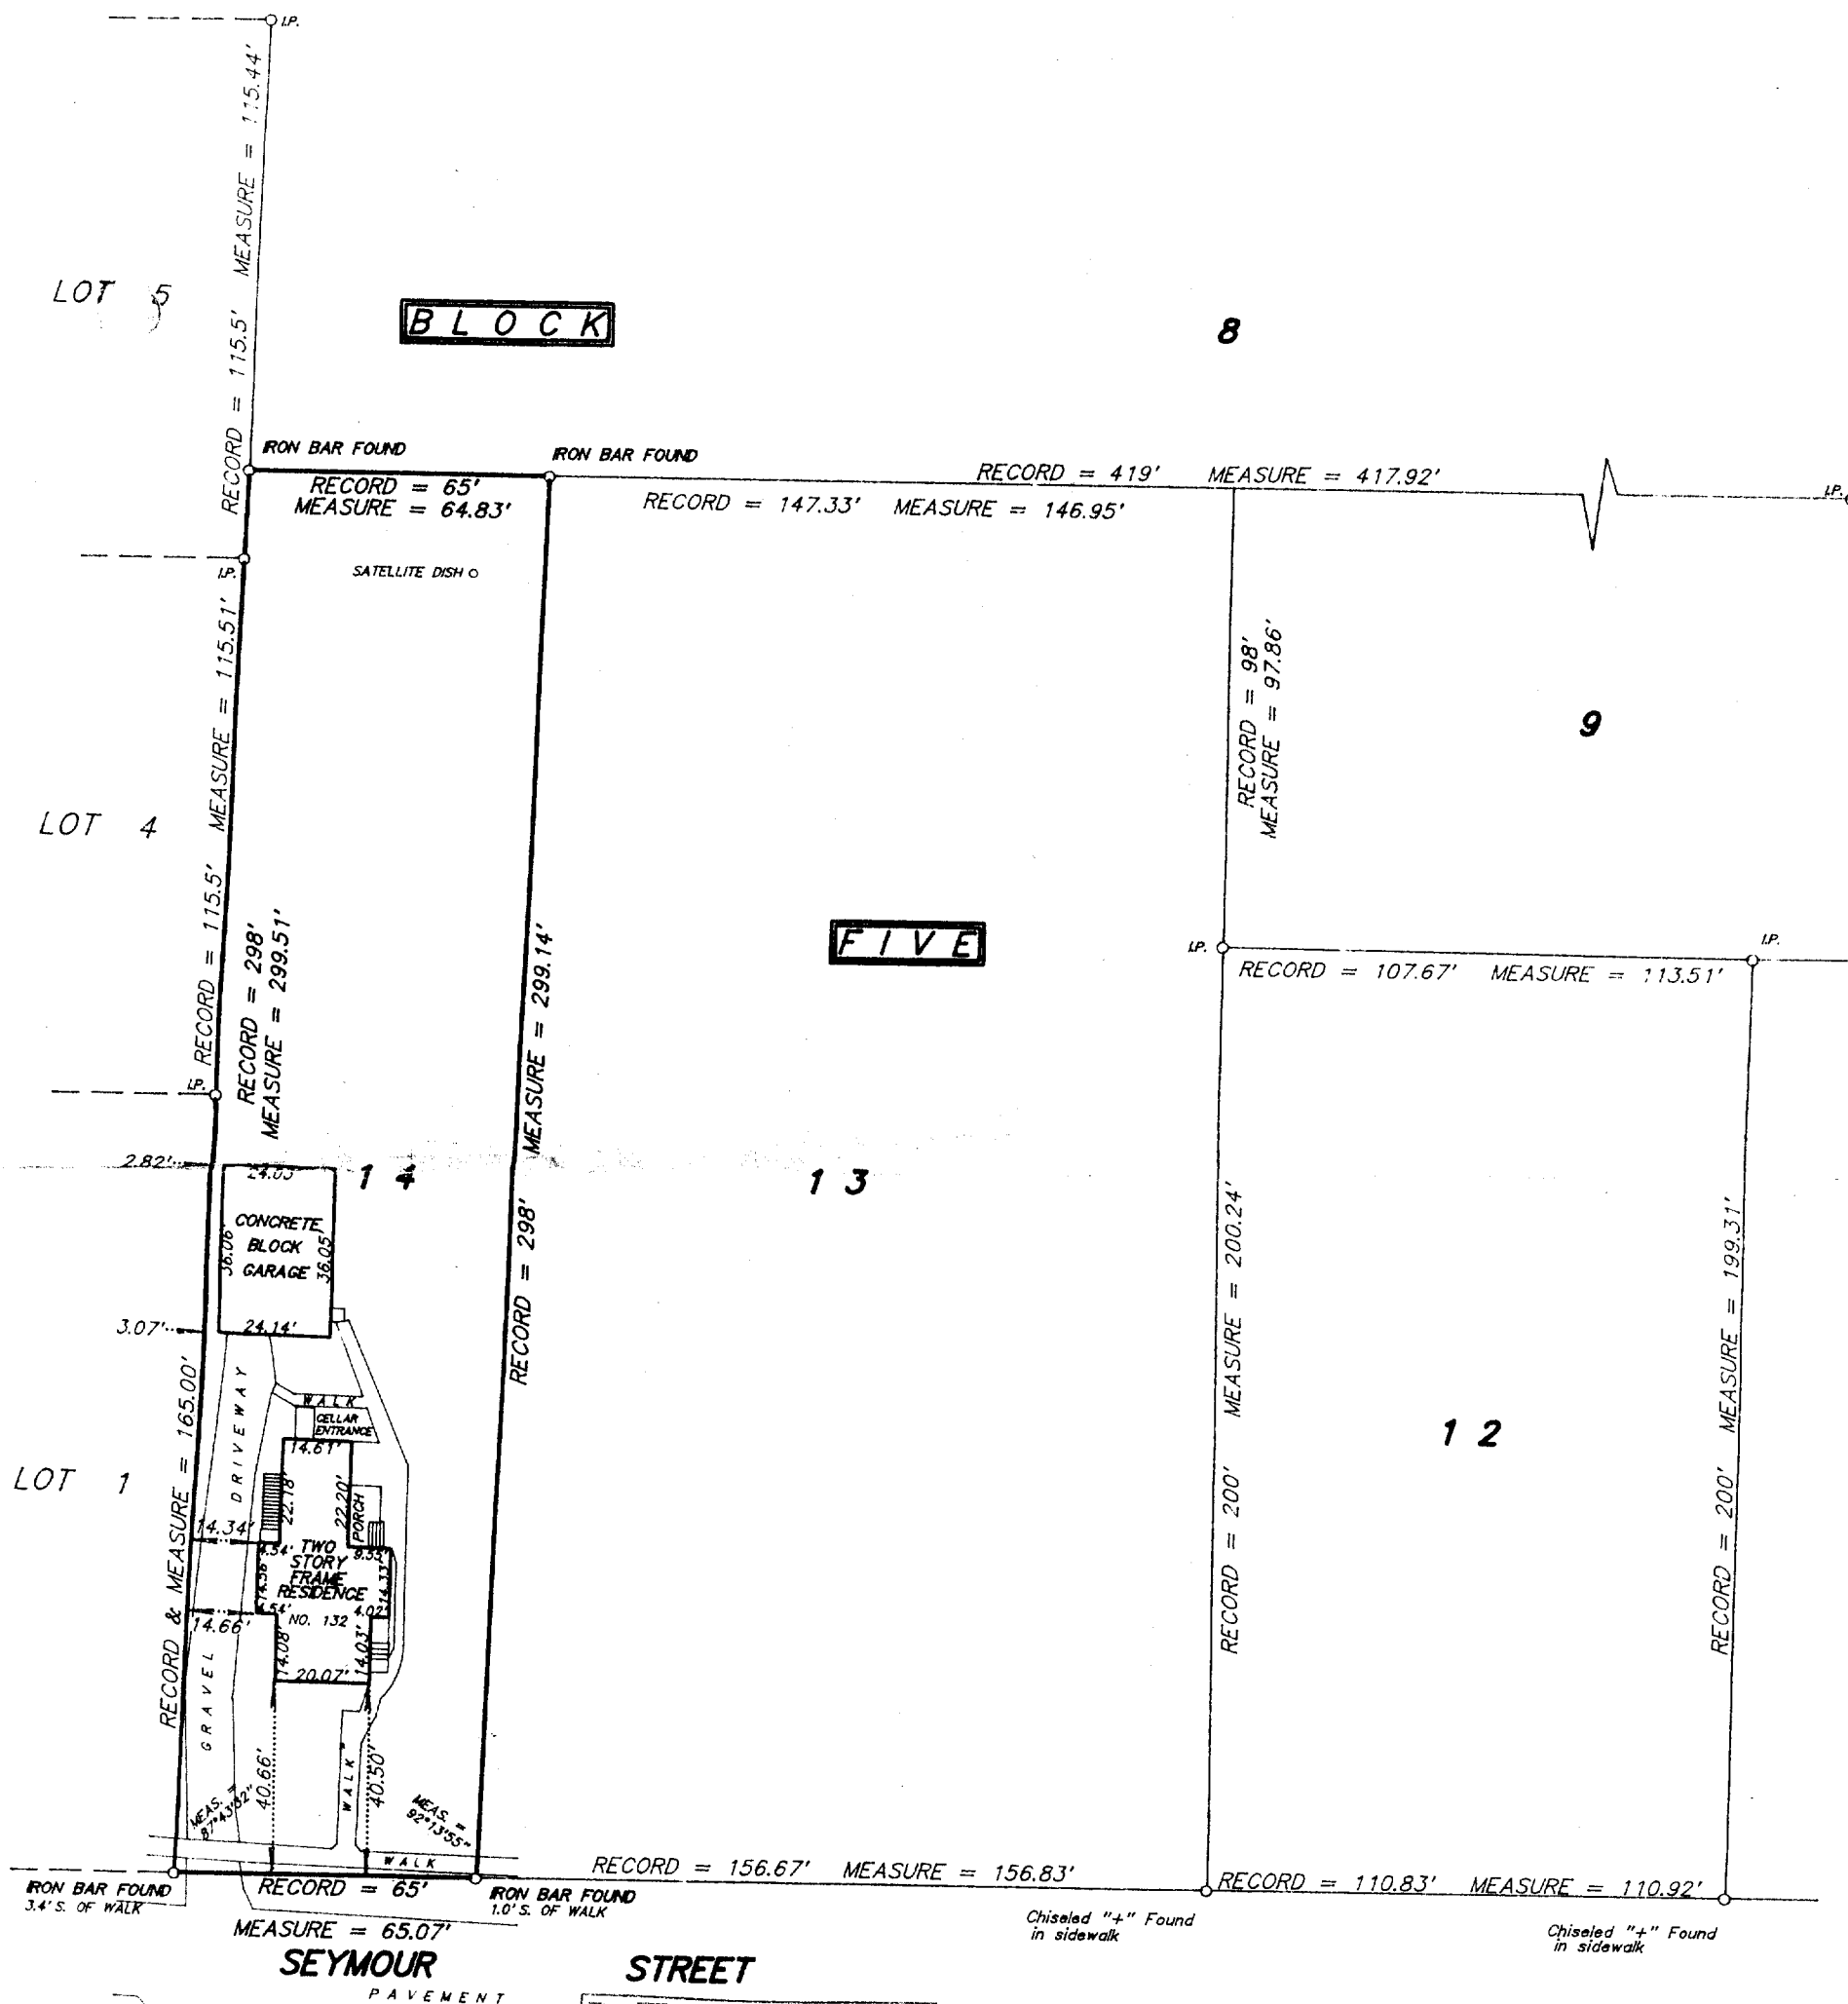


JOB NO. 00304

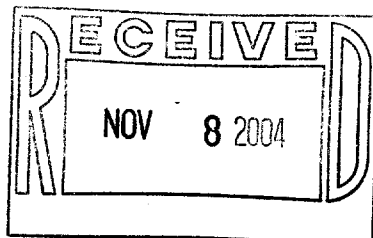

Dated at Bassett, Wisconsin this 30<sup>th</sup> day of NOVEMBER 2000

Mark A. Bolender  
Wisconsin Registered Land Surveyor S - 1784

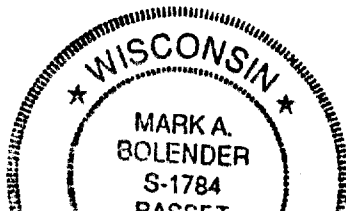

UCA 00095

008-404