


# PLAT OF SURVEY -OF-

LOT 3, CERTIFIED SURVEY MAP NO. 3359, BEING REDIVISION OF PART OF LOT 30 OF BLOCK 9 OF CITIZENS ADDITION - SOUTH SIDE, LOCATED IN PART OF THE SOUTHWEST 1/4 OF THE SOUTHWEST 1/4 OF SECTION 33, TOWN 1 NORTH, RANGE 15 EAST, VILLAGE OF SHARON, WALWORTH COUNTY, WISCONSIN.


SURVEY FOR: SOUTHEASTERN WISCONSIN HOUSING CORP.

PROPOSED ADDRESS: \_\_\_\_\_ STATE LINE RD.

EXISTING FN. FL.: 110.2

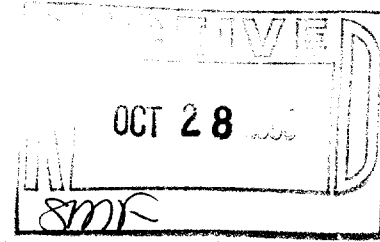

SCALE: 1" = 20'

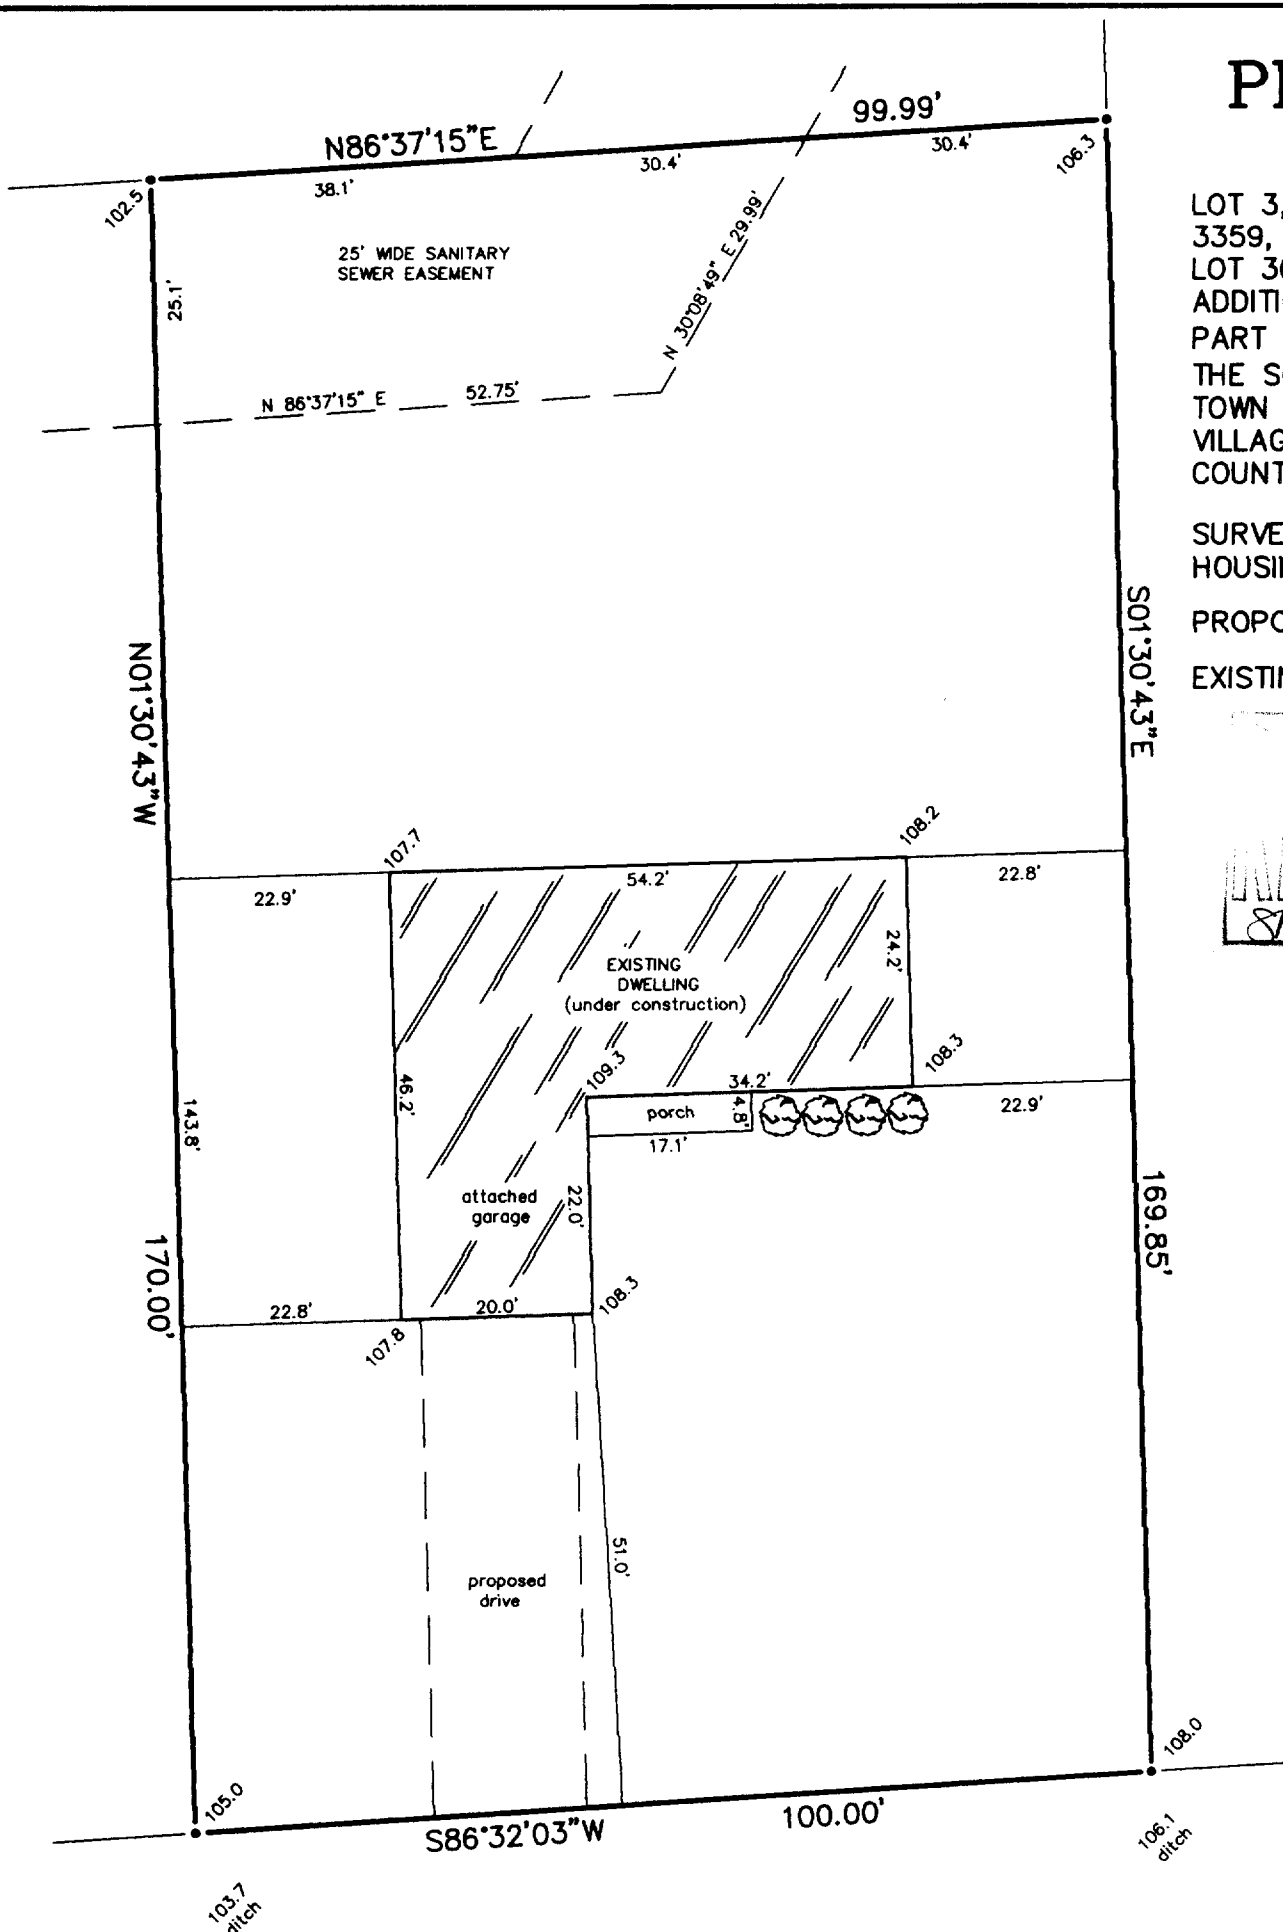


STATE LINE ROAD 66' WIDE

"I hereby certify that I have surveyed the above described property and that the above map is a correct representation thereof and shows the size and location of the property, its exterior boundaries, the location of all visible structures and dimensions of all principal buildings thereon, boundary fences, apparent easements, roadways and encroachments, if any."


"This survey is made for the use of the present owners of the property, and those who purchase, mortgage, or guarantee the title thereto within one year from date hereof."

## LEGEND

- FOUND IRON ROD
- 100.0 EXISTING ELEVATION

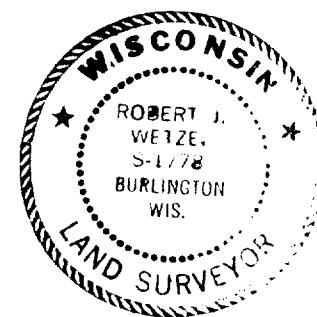

THIS IS NOT AN ORIGINAL PRINT  
UNLESS THIS SEAL IS RED.

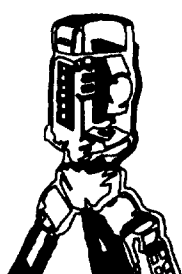

**B.W. SURVEYING, INC.**

LAND SURVEYS  
MAPPING AND PLANNING  
412 N. PINE STREET  
BURLINGTON, WI 53105  
(262)-767-0225

*Robert J. Wetzel*  
ROBERT J. WETZEL 5-1778

REVISED: SEPTEMBER 16, 2005

JUNE 29, 2005

DATE

6888

JOB NUMBER

UA3359-3

008-413