LAND-MARK SURVEYING Mark L. Miritz


Wisconsin Registered Land Surveyor S-2582


N9330 Knuteson Drive Whitewater, WI 53190 Phone:(262)495-3284 FAX: (262) 495-8421 LAND-MARKSURVEYING.COM


PLAT OF SURVEY

LOT 1 OF SHARON EAST SUBDIVISION, LOCATED IN THE NORTHEAST 1/4 OF SECTION 33, TOWN 1 NORTH, RANGE 15 EAST, VILLAGE OF SHARON, WALWORTH COUNTY, WISCONSIN.

OWNERS: RICHARD and NICOLETTE CEISEL
N2447 SHADY SIDE DR.
LAKE GENEVA, WI. 53147

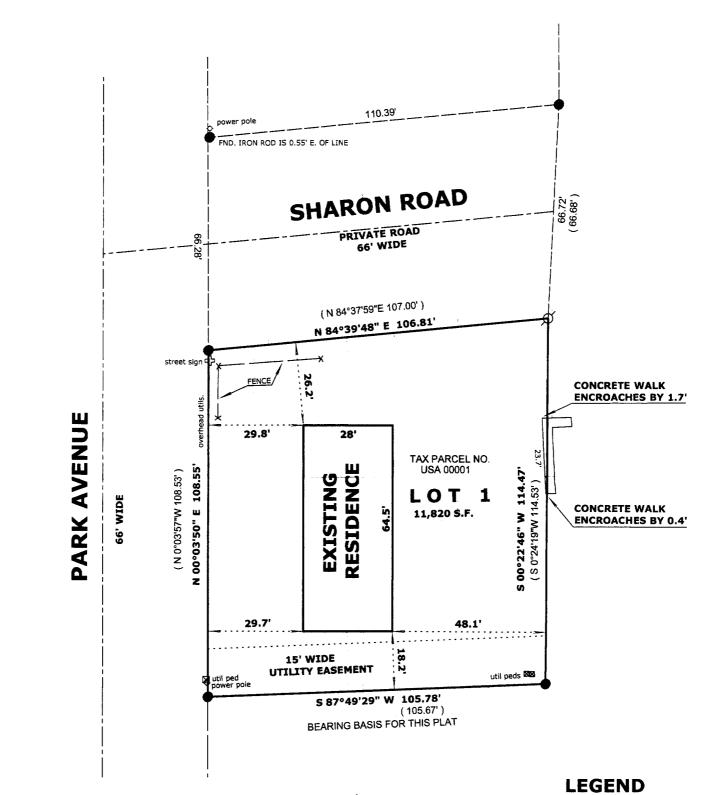

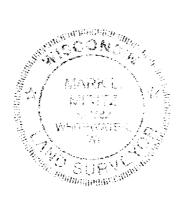

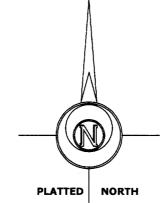



FOUND IRON PIPE
FOUND IRON ROD 1 5/16" DIA.

UTILITY PEDESTAL

CHISEL CUT IN CONCRETE
SET IRON ROD, 24" LONG, WEIGHING

1.5 LBS./LINEAL FT., 3/4" DIA.

(x x) RECORDED AS DIMENSION

SCALE: 1" = 30 FEET

EXISTING FENCE

"I hereby certify that the above described property has been surveyed by me or under my direction and that the above map is a true representation thereof and shows the size and location of the property, its exterior boundaries, the location of all visible structures and dimensions of all principal buildings thereon, boundary fences, apparent easements, roadways and visible encroachments, if any."

easements, roadways and visible encroachments, if any."
"This survey is made for the use of the present owners of
the property, and also those who purchase, mortgage, or
guarantee the title thereto within one year from date
hereof."

MARK L. MIRITZ
WISCONSIN REGISTERED
LAND SURVEYOR S-2582

3MF

NOV 17

REVISED OCT. 19, 2005 TO SHOW RESIDENCE "AS BUILT"

008-415

DATE: JUNE 16, 2005 JOB NO. 05.610