PREPARED FOR BOB LIMOSANI HOMESTEAD REALTY INC. 520 BROAD ST. LAKE GENEVA WI. 53147


## PLAT OF SURVEY


-OF-

LOT 2 CERTIFIED SURVEY MAP NO. 922 LOCATED IN LOT 1 AND PART OF LOT 2, BLOCK 2 OF THE ORIGINAL PLAT OF THE VILLAGE OF SHARON, IN THE VILLAGE OF SHARON, WALWORTH COUNTY, WISCONSIN.

KROTT SUR VEYING INC.


N3705 WILLOW BEND LANE
LAKE GENEVA WI. 53147
PHONE # (262)248-3697
FAX # (262)249-0639

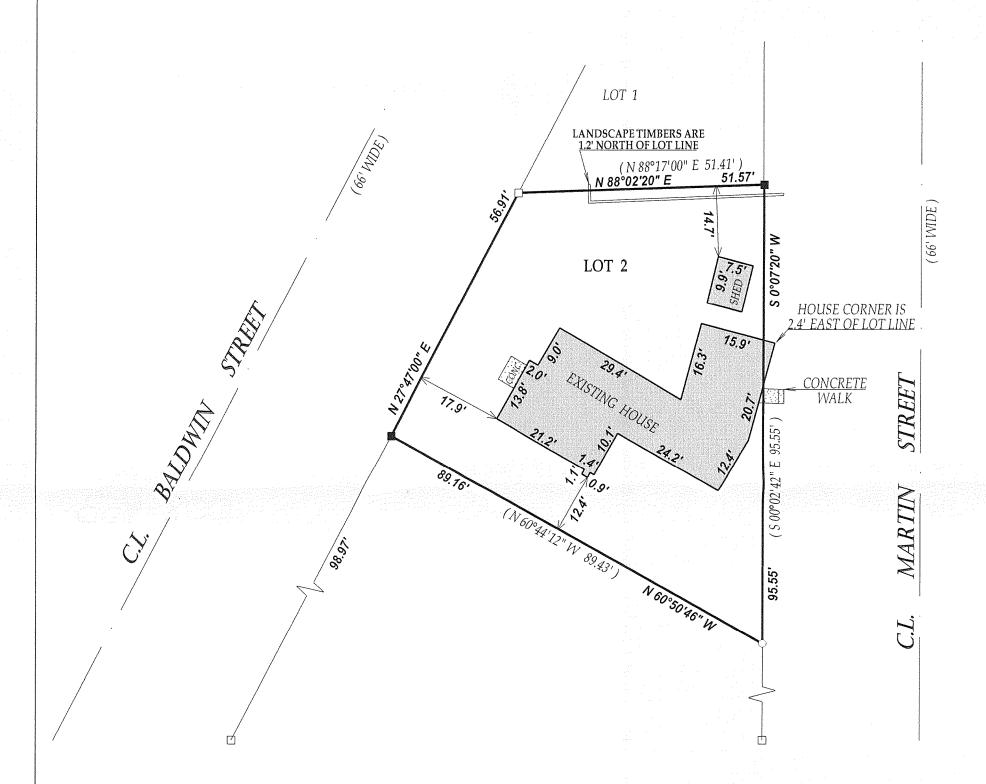

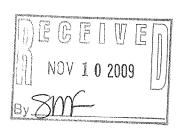

SCALE 1'' = 20'

20

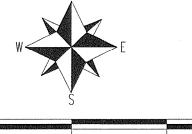

60

80

40

NOTE: BEARINGS REFRENCED TO C.S.M. # 922.

LEGEND

O FOUND IRON PIPE


□ FOUND IRON BAR

■ SET IRON BAR

(XX) RECORDED AS
TAX ID # UA92200002

I have surveyed the above-described property and the above map is a true representation thereof and shows the size and location of the property, its exterior boundaries, the location and dimensions of all structures thereon, fences apparent easements and roadways and visible encroachments. if any.

This survey is made for the exclusive use of the present owners of the property, and also those who puchase, mortgage, or insure the title therto within one (1) year from date hereof; and as to them I warrant the accuracy of said survey map.

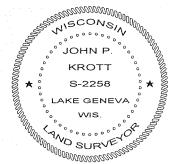

DATED THIS 11th DAY OF SEPTEMBER 2009.

JOHN KROTT S - 2258 Wisconsin Registered Land Surveyor

( original if signed in red )