


**SURVEYING & SUBDIVIDING  
DEHAVAN, WISCONSIN**

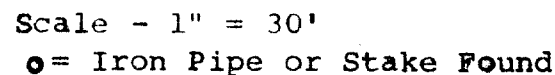

I, George T. Dunham, Surveyor, certify that I have surveyed the property described as follows,  
Beginning 350 feet east of the intersection of Walworth and Seymour Street; thence North 273 feet; East 53 feet; South 73 feet; East 33 feet; South 200 feet; West 86 feet to the place of beginning. Said land located in the East part of Lot 12, Block 4, Citizens Addition to the Village of Sharon, Walworth County, Wisconsin,  
and that the above plat is an accurate survey and a true representation thereof and correctly shows the exterior boundary lines and location of buildings and driveway on said property and the correct measurements thereof.  
January 19, 1972

A circular seal with a dotted border. The word "WISCONSIN" is arched across the top, and "LAND SURVEYOR" is arched across the bottom. In the center, the name "GEORGE T. DUNHAM" is printed in bold, with "DELAVAN, WIS." below it. Two small five-pointed stars are positioned on the left and right sides of the central text.