


KOLB SURVEYING S.C.
PROFESSIONAL BUILDING
415 BROAD STREET
LAKE GENEVA, WI 53147



Eugene A. Blomquist
EUGENE A. BLOMQUIST
WISCONSIN REGISTERED SURVEYOR, S-1279
Feb. 13, 1976
DATE

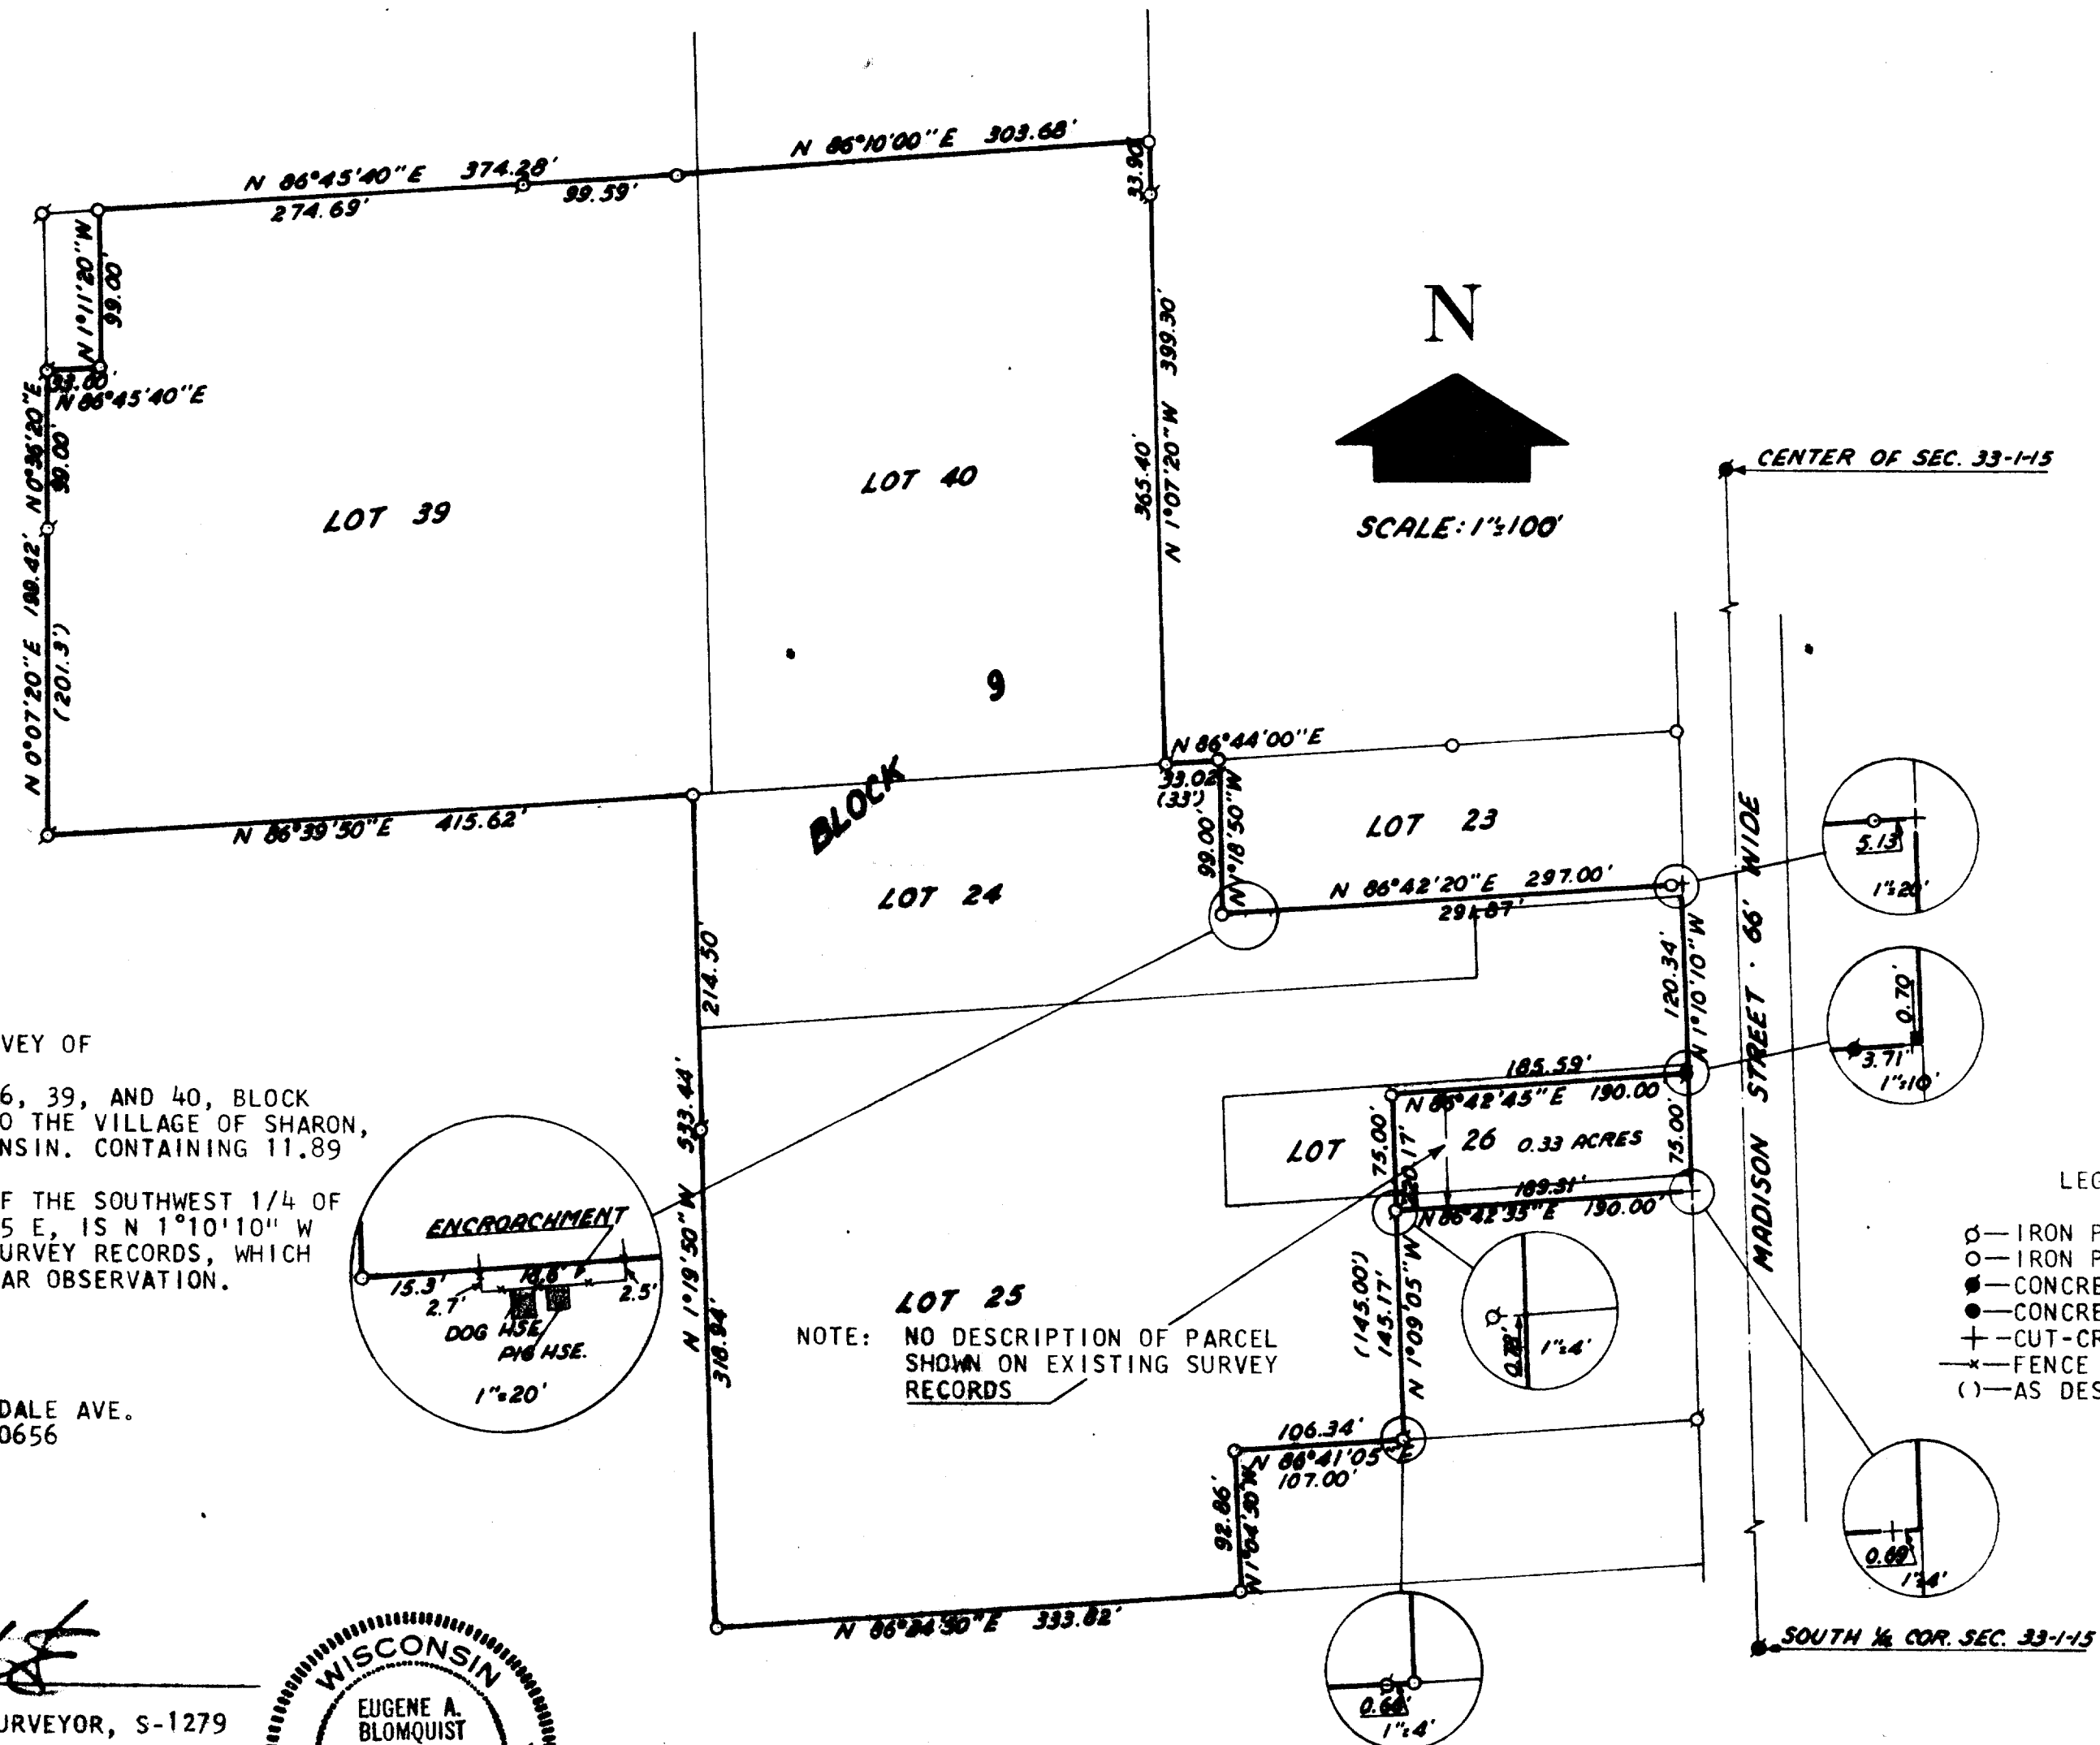