


**GEORGE T. DUNHAM**  
 SURVEYING & SUBDIVIDING  
 DELAVAN, WISCONSIN

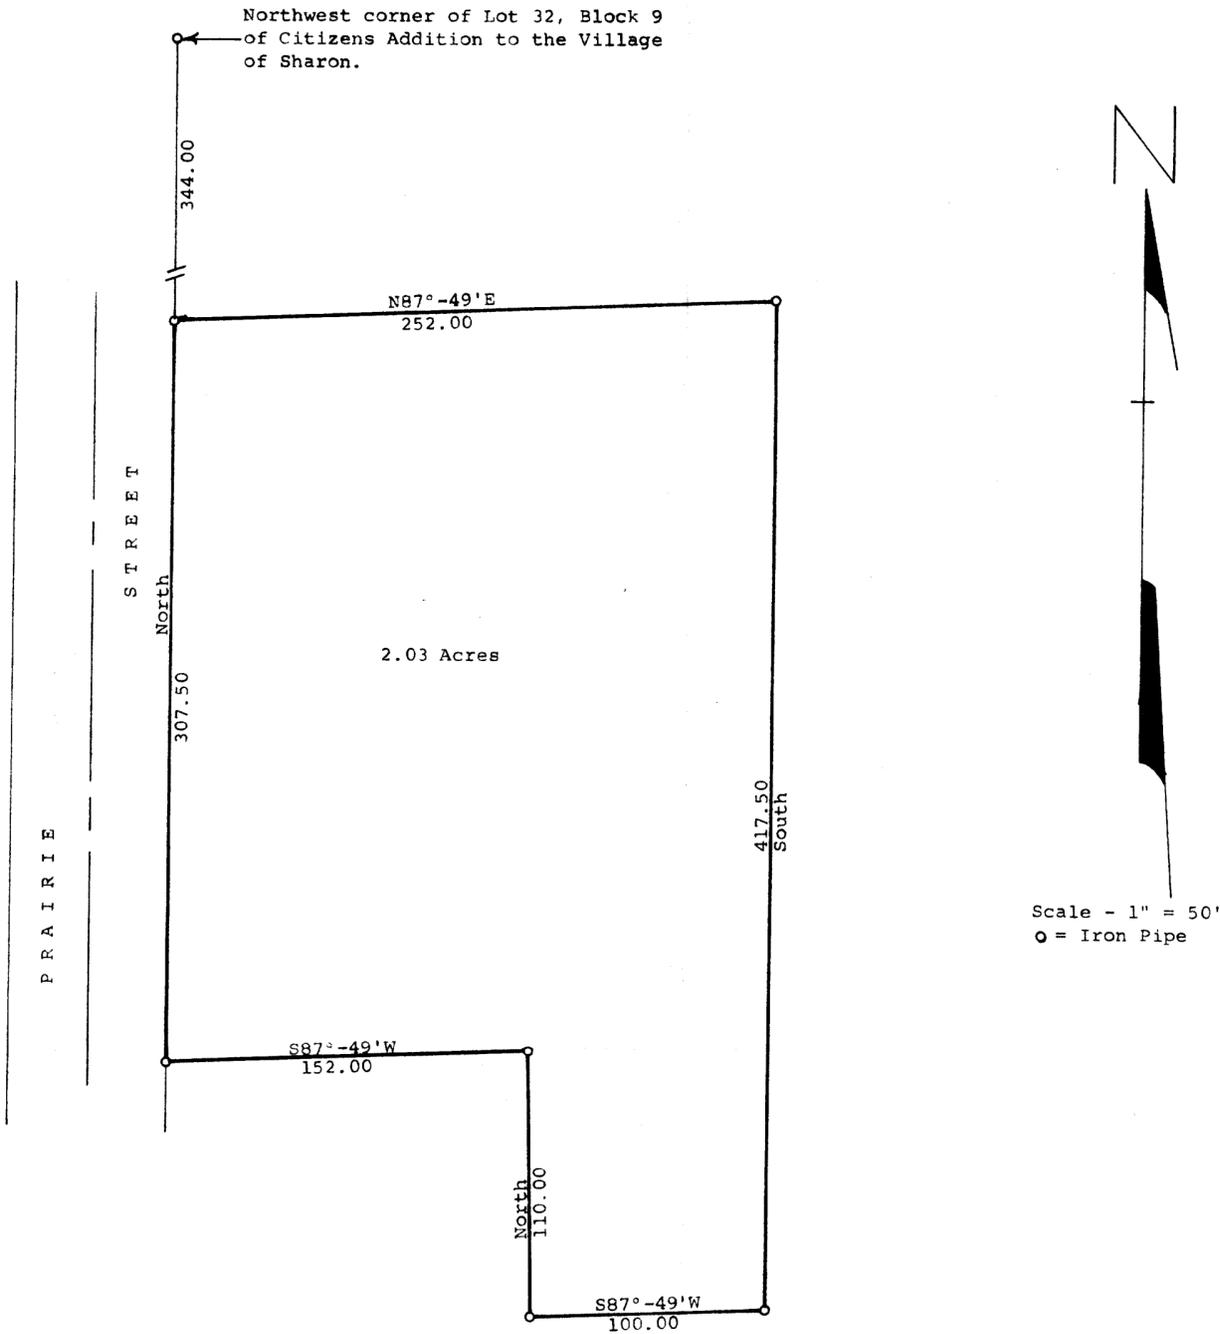

STATE OF WISCONSIN)  
 COUNTY OF WALWORTH) SS

I, George T. Dunham, Surveyor, certify that I have surveyed the property described as follows,

A parcel of land located in Lot 31, Block 9 of Citizens Addition to the Village of Sharon, Walworth County, Wisconsin, described as follows: Commencing at the Northwest corner of Lot 32 in said Block 9; thence South along the west line of said Lots 32 and 31, 344.00 feet to the place of beginning; thence N87°-49'E parallel with the north line of said Lot 32, 252.00 feet; thence South parallel with the west line of said lot 31, 417.50 feet; thence S87°-49'W, 100.00 feet; thence North 110.00 feet; thence S87°-49'W, 152.00 feet to the east line of Prairie Street; thence North along the east line of Prairie Street, 307.50 feet to the place of beginning containing 2.03 acres of land,

and the above map is a true representation thereof and shows the size and location of the property, its exterior boundaries, apparent easements and roadways and visible encroachments, if any, and that there are buildings located on the above described property which are not shown on the plat but all of which are located well within the boundaries of said described land.

This survey is made for the exclusive use of the present owners of the property, and also those who purchase, mortgage, or guarantee the title thereto within one (1) year from date hereof; and as to them I warrant the accuracy of said survey and map.

February 18, 1976

*George T. Dunham*  
 George T. Dunham, Surveyor

