


60-57


8-8B

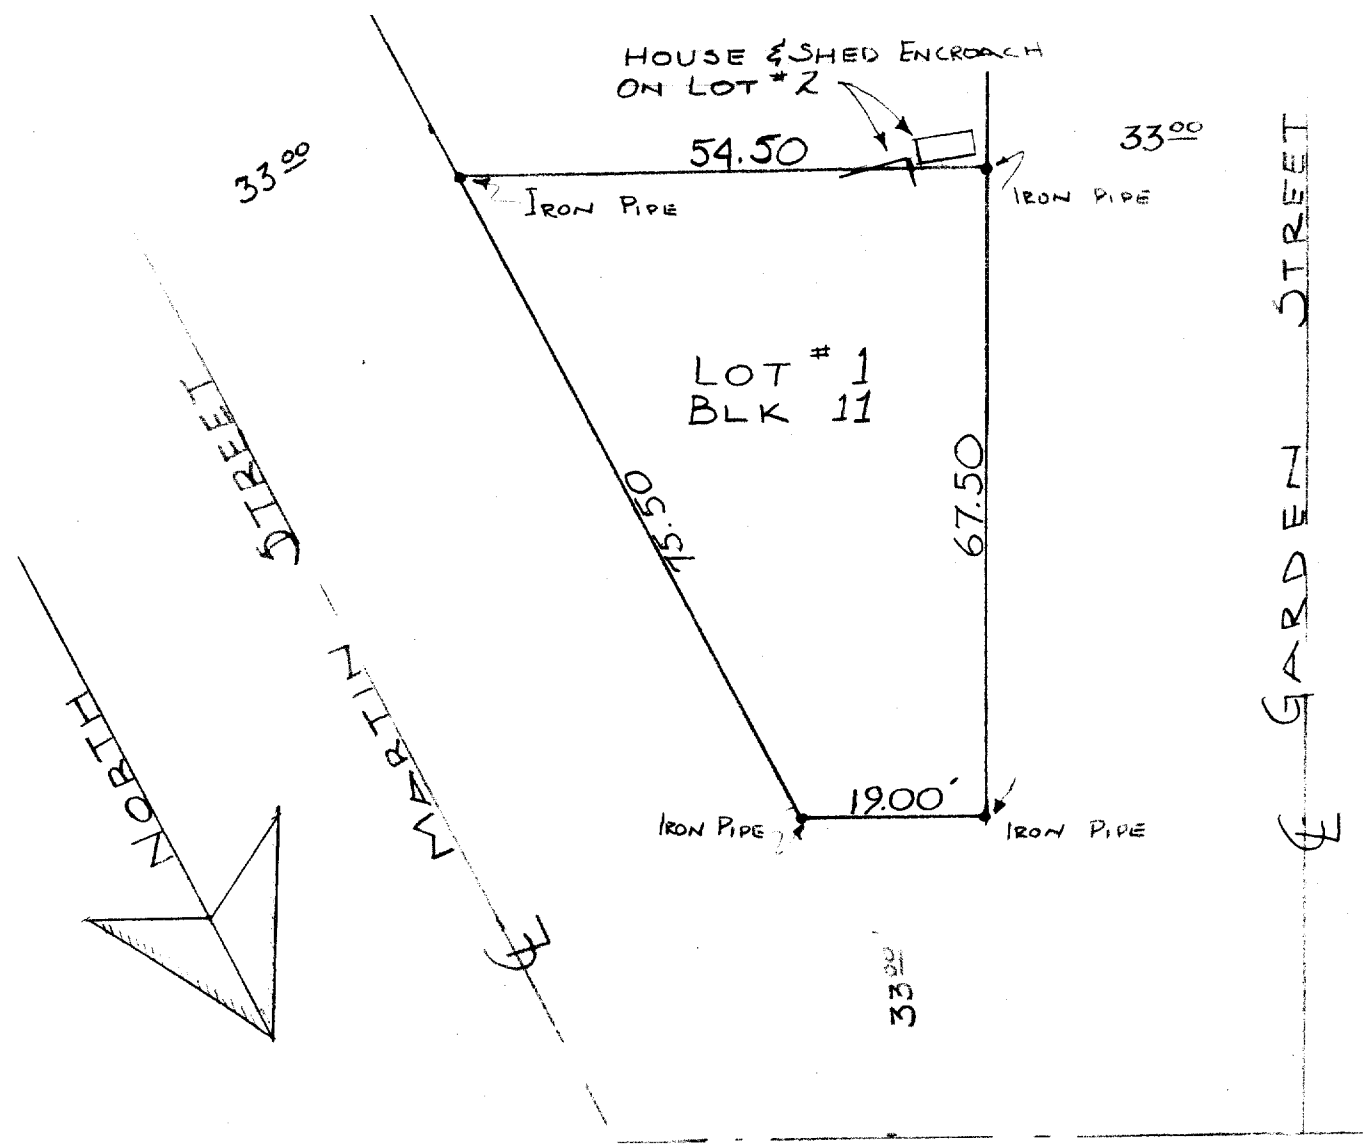

Description: Lot #1 of Block #11 of the Original Plat of the Village of Sharon, Walworth County, Wisconsin.

Plat of survey by James F. Biagi.

Surveyed May 27, 1960.

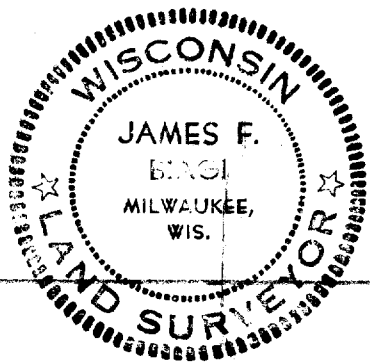

*James F. Biagi*  
James F. Biagi RLS 272

8-8B

8-8B