


HAROLD H. KOLB
REGISTERED PROFESSIONAL LAND SURVEYOR
LAKE GENEVA, WISCONSIN




PLAT OF SURVEY OF

Lot 4, Block 1, Crandall and Swinney's
Subdivision, Village of Walworth,
Walworth County, Wisconsin.

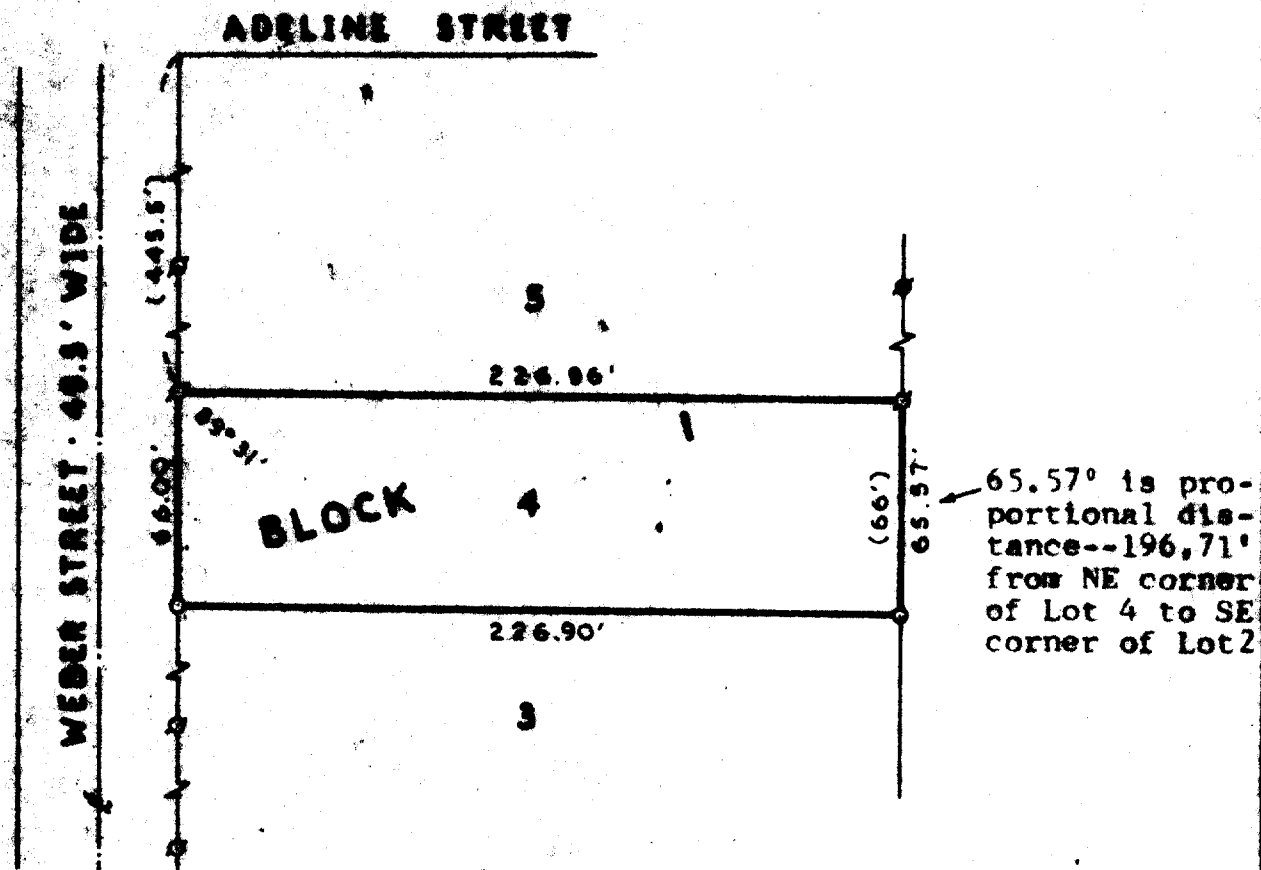

LEGEND

- 6 - IRON PIPE FOUND
- 6 - IRON PIPE PLACED
- 6 - CONCRETE MONUMENT
- 2 - SPICE
- (1) - AS PLATTED

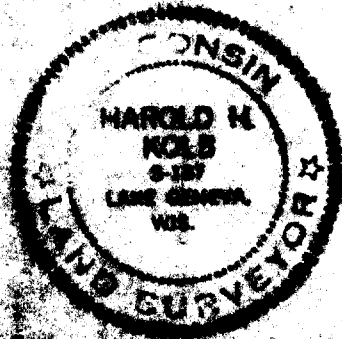

I, HAROLD H. KOLB, DO HEREBY CERTIFY THAT I HAVE
 SURVEYED THE PROPERTY HEREON DESCRIBED ACCORDING
 TO THE OFFICIAL RECORDS, AND THAT THE PLAT HEREON
 IS A CORRECT REPRESENTATION OF THE LOT LINES.

Harold H. Kolb
 HAROLD H. KOLB
 WISCONSIN REGISTERED LAND SURVEYOR, S-187
 DATE November 2, 1972

4-101