PREPARED FOR KEEFE REAL ESTATE C\O CHRIS STECKER 751 GENEVA PARKWAY LAKE GENEVA WI. 53147

## PLAT OF SURVEY


- OF -

PATHFINDER SURVEYING INC. W2888 KRUEGER RD. UNIT "D" LAKE GENEVA WI. 53147 (262) 248-3697

LOT 2 CERTIFIED SURVEY MAP NO. 1201 LOCATED IN THE SOUTHEAST 1/4 OF SECTION 16, TOWN 1 NORTH, RANGE 16 EAST, VILLAGE OF WALWORTH, WALWORTH COUNTY, WISCONSIN.

## C.L. WISCONSIN STREET

(66' WIDE ROAD)

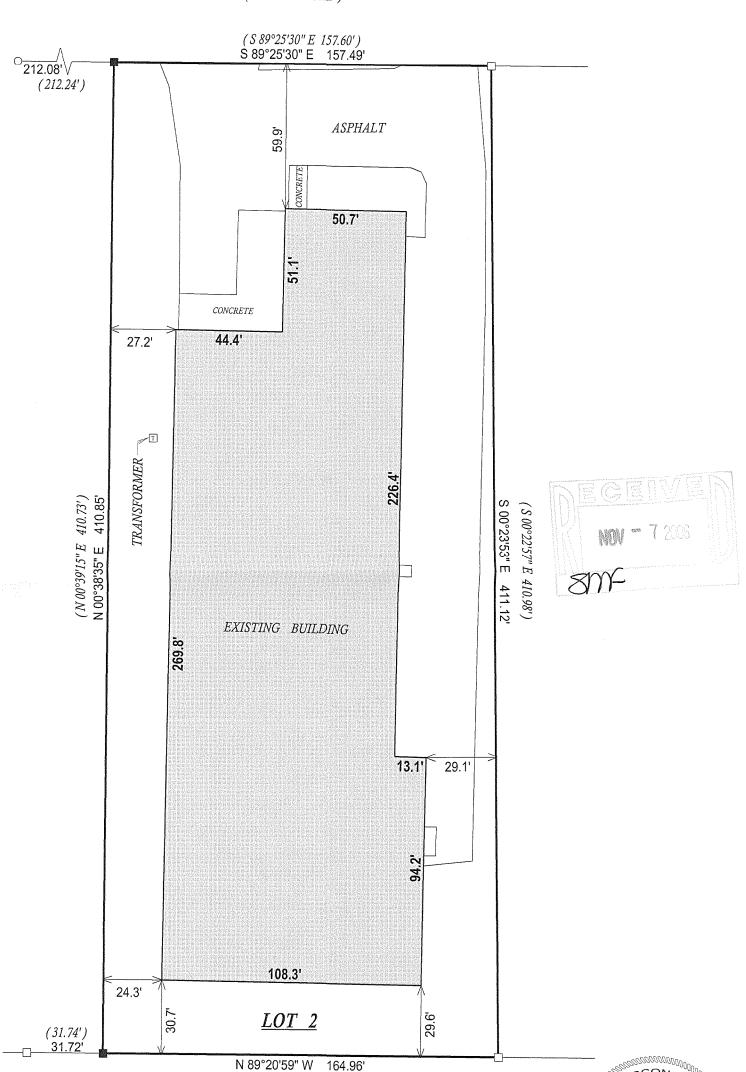



LOT 1

( )= recorded as

 $\Box$  = found iron bar

= found iron pipe

= set iron pipe

= set iron bar

SCALE 1" = 40'

JOB # 06-479

TAXAD # VA120100002

COMPARE LEGAL DESCRIPTION ABOVE AND DRAWING WITH DEED. FOR BUILDING RESTRICTIONS AND EASEMENTS NOT SHOWN, REFER TO DEED. ABSTRACT SOURCES AND LOCAL MUNICIPAL CODES. NOTIFY THE SURVEYOR IMMEDIATELY OF ANY DISCREPANCY.

(N 89°21'30" W 165.04')

"I hereby certify that I have surveyed the above described property and that the above map, to the best of my knowledge and belief, is a true representation thereof and shows the size and location of all visible structures, apparent easements and encroachments of any."

This survey is made for the present owners of the property, and those who purchase, mortgage, or guarentee the title thereto, within one year from the date hereof.



JOHN KROTT S - 2258
Wisconsin Registered Land Surveyor
( original if signed in red )

DATED THIS THE 25th DAY OF SEPTEMBER 2006.