


# FARRIS, HANSEN & ASSOCIATES, INC.

ENGINEERING — ARCHITECTURE — SURVEYING  
7 RIDGWAY COURT — P.O. BOX 437 — ELKHORN, WISCONSIN 53121  
PHONE: (262) 723-2098 FAX: (262) 723-5886

ASSIGNED THE EASTERLY BOUNDARY OF  
LOT 4 N 04°12'07" W PER RECORD  
PLAT OF BIGFOOT RIDGE OF WALWORTH

— WORK ORDERED BY —  
SHOREWEST REALTY, INC.  
623 MAIN STREET  
LAKE GENEVA, WI 53147

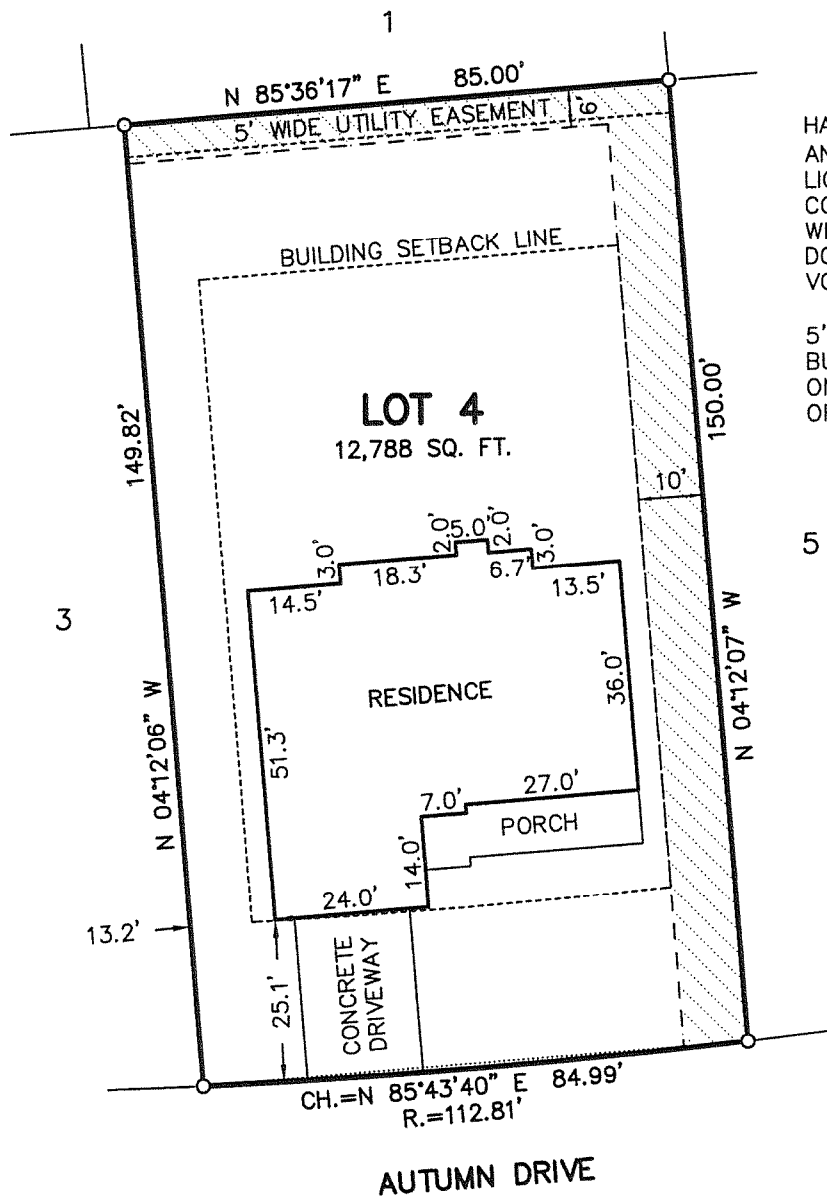

HATCHED AREA REPRESENTS 10' WIDE  
AND 6' WIDE WISCONSIN POWER &  
LIGHT COMPANY, GENERAL TELEPHONE  
CO., AND TCI CABLEVISION OF  
WISCONSIN, INC. EASEMENTS PER  
DOCUMENT NO. 327940 RECORDED IN  
VOL. 640 ON PAGE 5106.

5' WIDE UTILITY EASEMENT AND  
BUILDING SETBACK LINES AS SHOWN  
ON RECORD PLAT OF BIGFOOT RIDGE  
OF WALWORTH.

LEGEND  
O—FOUND IRON PIPE STAKE



## PLAT OF SURVEY

Lot 4 in Block 3 of Bigfoot Ridge of Walworth, a Subdivision located in the SE 1/4  
of the SW 1/4 of Section 22, T1N, R16E, Village of Walworth, Walworth County,  
Wisconsin.

Tax Key No: VBIG 00017

LEGAL DESCRIPTION OF RECORD FROM TITLE COMMITMENT PROVIDED BY CLIENT



NOTE: COPIES OF THIS MAP TO WHICH THE FOLLOWING CERTIFICATE  
WILL APPLY SHOW THE SURVEYOR'S ORIGINAL SEAL AND SIGNATURE IN  
RED INK. COPIES BY ANY OTHER MEANS MAY HAVE ALTERATIONS  
WHICH DO NOT REPRESENT THE SURVEYOR'S WORK PRODUCT. I  
HEREBY CERTIFY THAT THE ABOVE DESCRIBED PROPERTY HAS BEEN  
SURVEYED UNDER MY DIRECTION AND THAT THE ABOVE MAP IS A  
TRUE REPRESENTATION THEREOF AND SHOWS THE SIZE AND LOCATION  
OF THE PROPERTY, ITS EXTERIOR BOUNDARIES, THE LOCATION OF ALL  
VISIBLE STRUCTURES, AND DIMENSIONS OF ALL PRINCIPLE BUILDINGS  
THEREON, BOUNDARY FENCES, APPARENT EASEMENTS, ROADWAYS,  
AND VISIBLE ENCROACHMENTS, IF ANY. THIS SURVEY IS MADE FOR  
THE USE OF THE PRESENT OWNERS OF THE PROPERTY, AND ALSO  
THOSE WHO PURCHASE, MORTGAGE, OR GUARANTEE THE TITLE  
THERETO WITHIN ONE YEAR FROM THE DATE HEREOF.

DATED: 7/14/2008

PETER S. GORDON

PROJECT: 7681  
DATE: 07/14/2008  
SHEET 1 OF 1

VBIG-17  
JUL 15 2008

009-1077