


80. Thurs. Oct. 10, 1905
Survey of a parcel
of land in N. E. $\frac{1}{4}$ (S. 1/2)
of N. E. $\frac{1}{4}$ Sect 21, T. 1, N. 16 E
Village of Walworth,
Walworth, Wis
For Ward Davis Executor
of Est. of Mary E. Maxon
deceased
described as follows:
Begin at an iron stake in
N. line of Beloit St. 68'
E. of West line lot 7,
Block 3, original plat
of Walworth village.
Said parcel of land
is in Sect 21, N. E. $\frac{1}{4}$, Sect 21,
described in deed as,
begin at an iron stake in
N. line Beloit St. 68' East
of West line of ^{lot 7} plat of village
Kate Hantay Zell lot. Thence
in East line of Zell lot North
173 ft. to an iron stake in
a line of fence. Thence E.
in fence line and
S. line of one halves lot
225-9 ft. to an iron

Stake in S. W. line Madison St. S. 1.
Thence S. E. in said line of
Madison St. 34 ft. more or less
Southeast to an iron stake
at walk line. Thence S. 160'
in West line of a walk. Which
is East line of lot 3, Block 3
160' to N. line Beloit St. Thence
south 33' to ctr. of Beloit
St. Thence west in ctr.
line of Beloit St. 285 ft
more or less to a point S.
of point of beginning. Thence
N. 33' to point of beginning.
Iron stake at point of beginning
is 3 ft. inside walk line.
Beloit St. & Kenosha St. do
not line up perfectly.
Beloit St. instead of being 66'
wide is over 70' inside of walk
to inside of walk.
Above land contains 1.3 A,
more or less.
Checked all changes in
abstract and description
of above land correct.
E. line runs into N. Beloit St.
walk, 6".

Diagonal 373.35'
MADISON

1/2 of SW 1/4 Sec. 21, T. 1, N. R. 16, E.

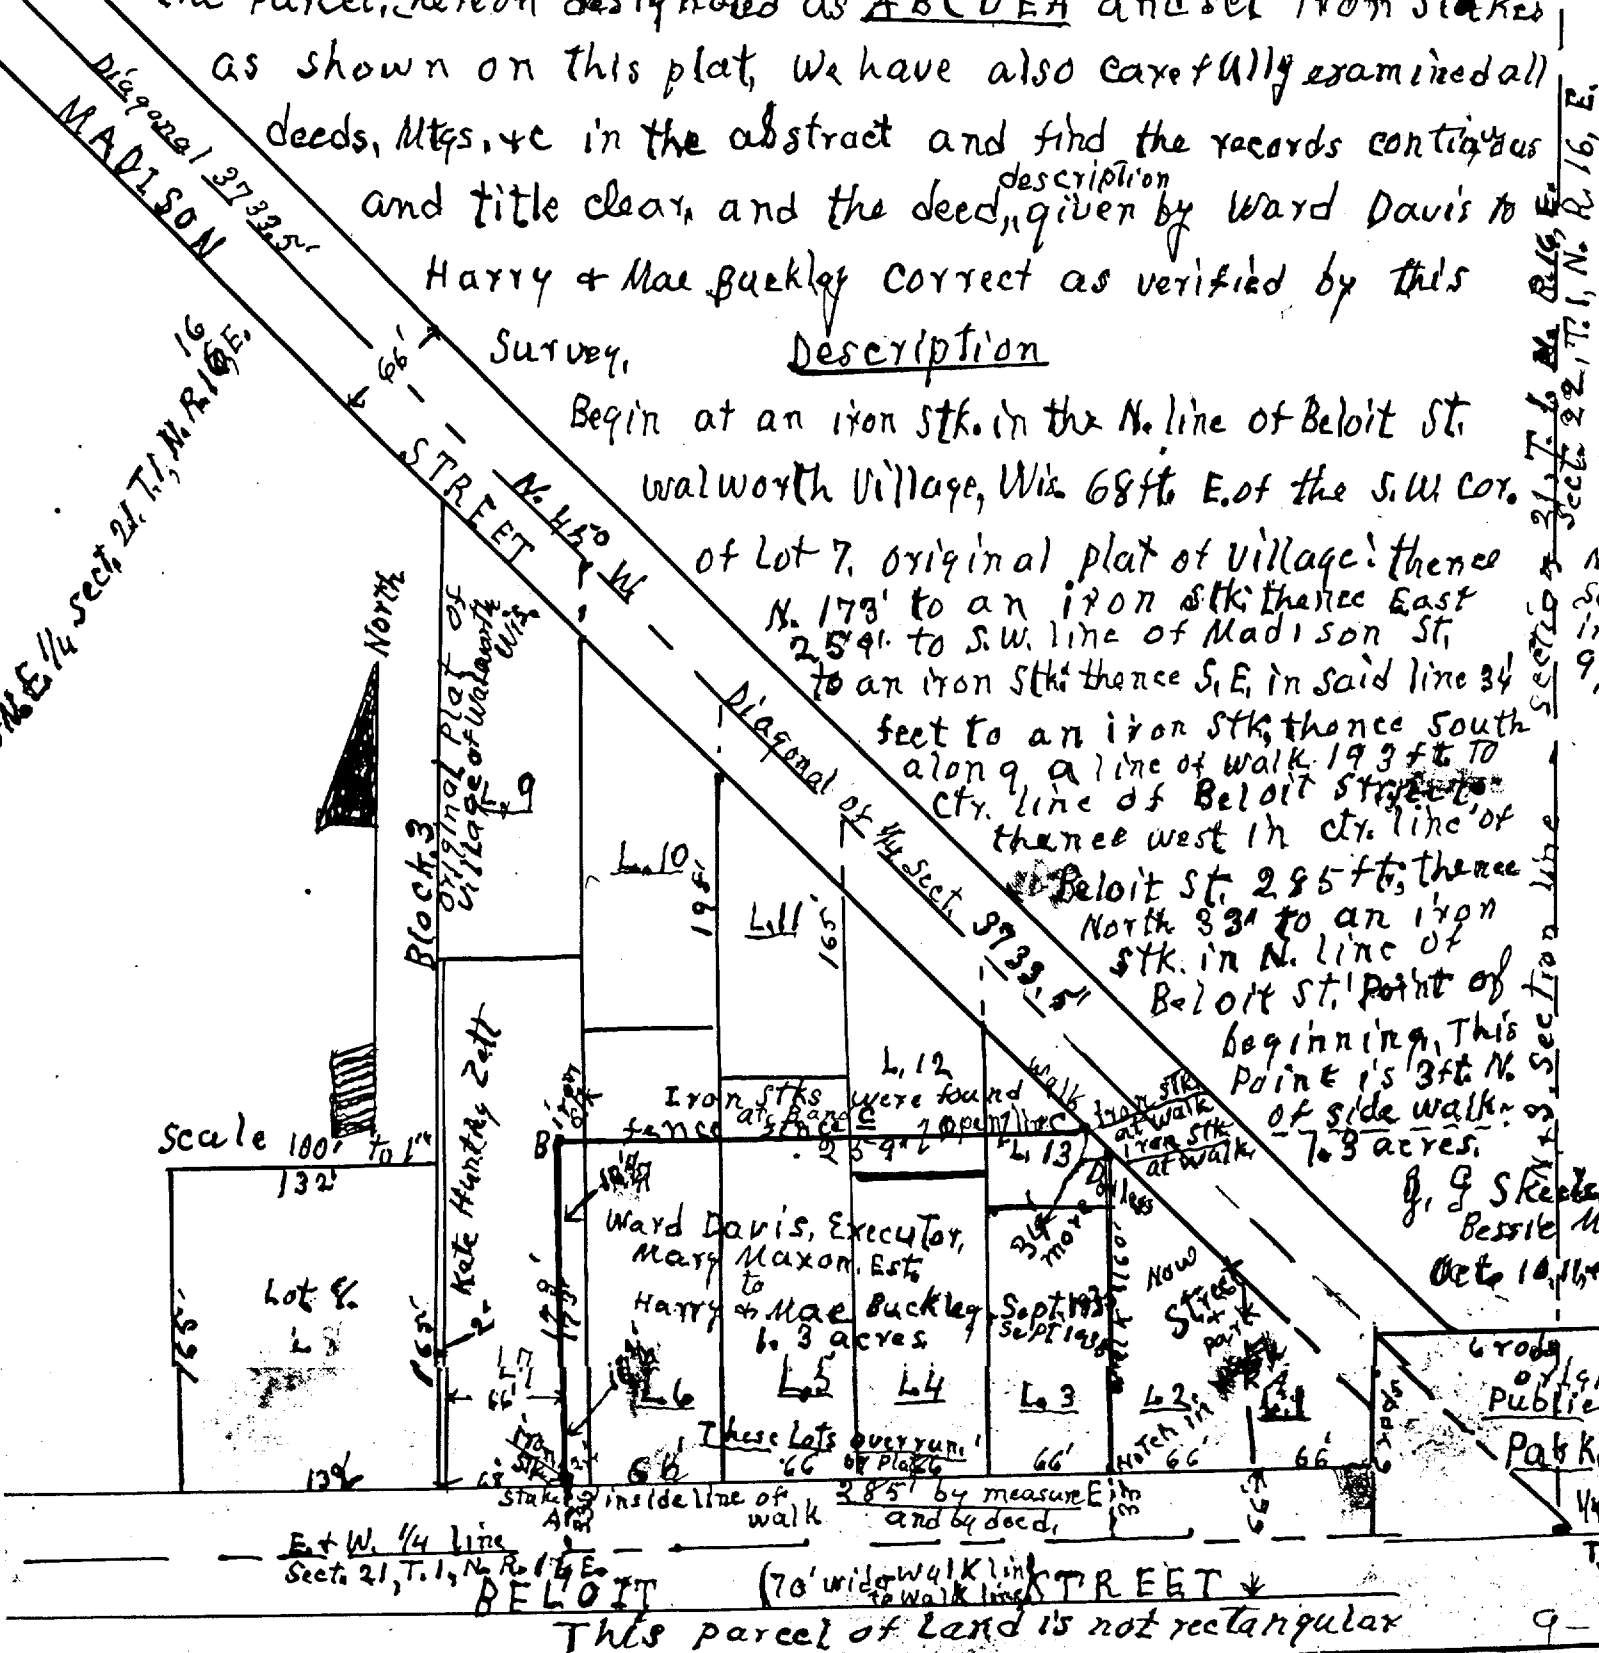

as shown on this plat, we have also carefully examined all deeds, Mts. &c in the abstract and find the records contiguous and title clear, and the deed ^{description} given by Ward Davis to Harry & Mae Buckley correct as verified by this

Survey, Description

Begin at an iron stk. in the N. line of Beloit St. Walworth Village, Wix 68ft E. of the S.W. cor. of Lot 7. original plat of Village: thence N. 179° to an iron stk. thence East 254' to S.W. line of Madison St. to an iron stk. thence S. E. in said line 34 feet to an iron stk. thence South along a line of walk 193 ft to Ctr. line of Beloit Street. thence west in Ctr. line of Beloit St. 285 ft. thence North 83° to an iron stk. in N. line of Beloit St. Point of beginning. This Point is 3ft N. of side walk. 7.3 acres.

Notes - Several lines in deeds were given as "more or less"

J. G. S. Rees, Wis. Reg. C.E.
Bessie M. Pa. Lm. Reg.
Oct. 10, 11, 12, 1935

as shown on this plat, we have also examined the records, deeds, Mtgs, &c in the abstract and find the records continuous and title clear, and the deed ^{description} given by Ward Davis to Harry & Mae Buckley correct as verified by this Survey.

Description


Begin at an iron stk in the N. line of Beloit St. Walworth Village. Wis. 68 ft. E. of the S.W. Cor. of Lot 7. Original plat of Village: thence

N. 173° to an iron stk; thence East 254' to S.W. line of Madison St. to an iron stk; thence S.E. in said line 34

feet to an iron stk; thence South along a line of walk 193 ft to city line of Beloit St. thence west in city line of


Beloit St. 285 ft; thence North 33° to an iron stk. in N. line of Beloit St. Point of beginning. This Point is 3 ft N. of side walk.

J. G. Skeels, Wis. Reg. C.E.
Bessie M. Pa Limer Assn
Oct. 10, 11, 12, 1935

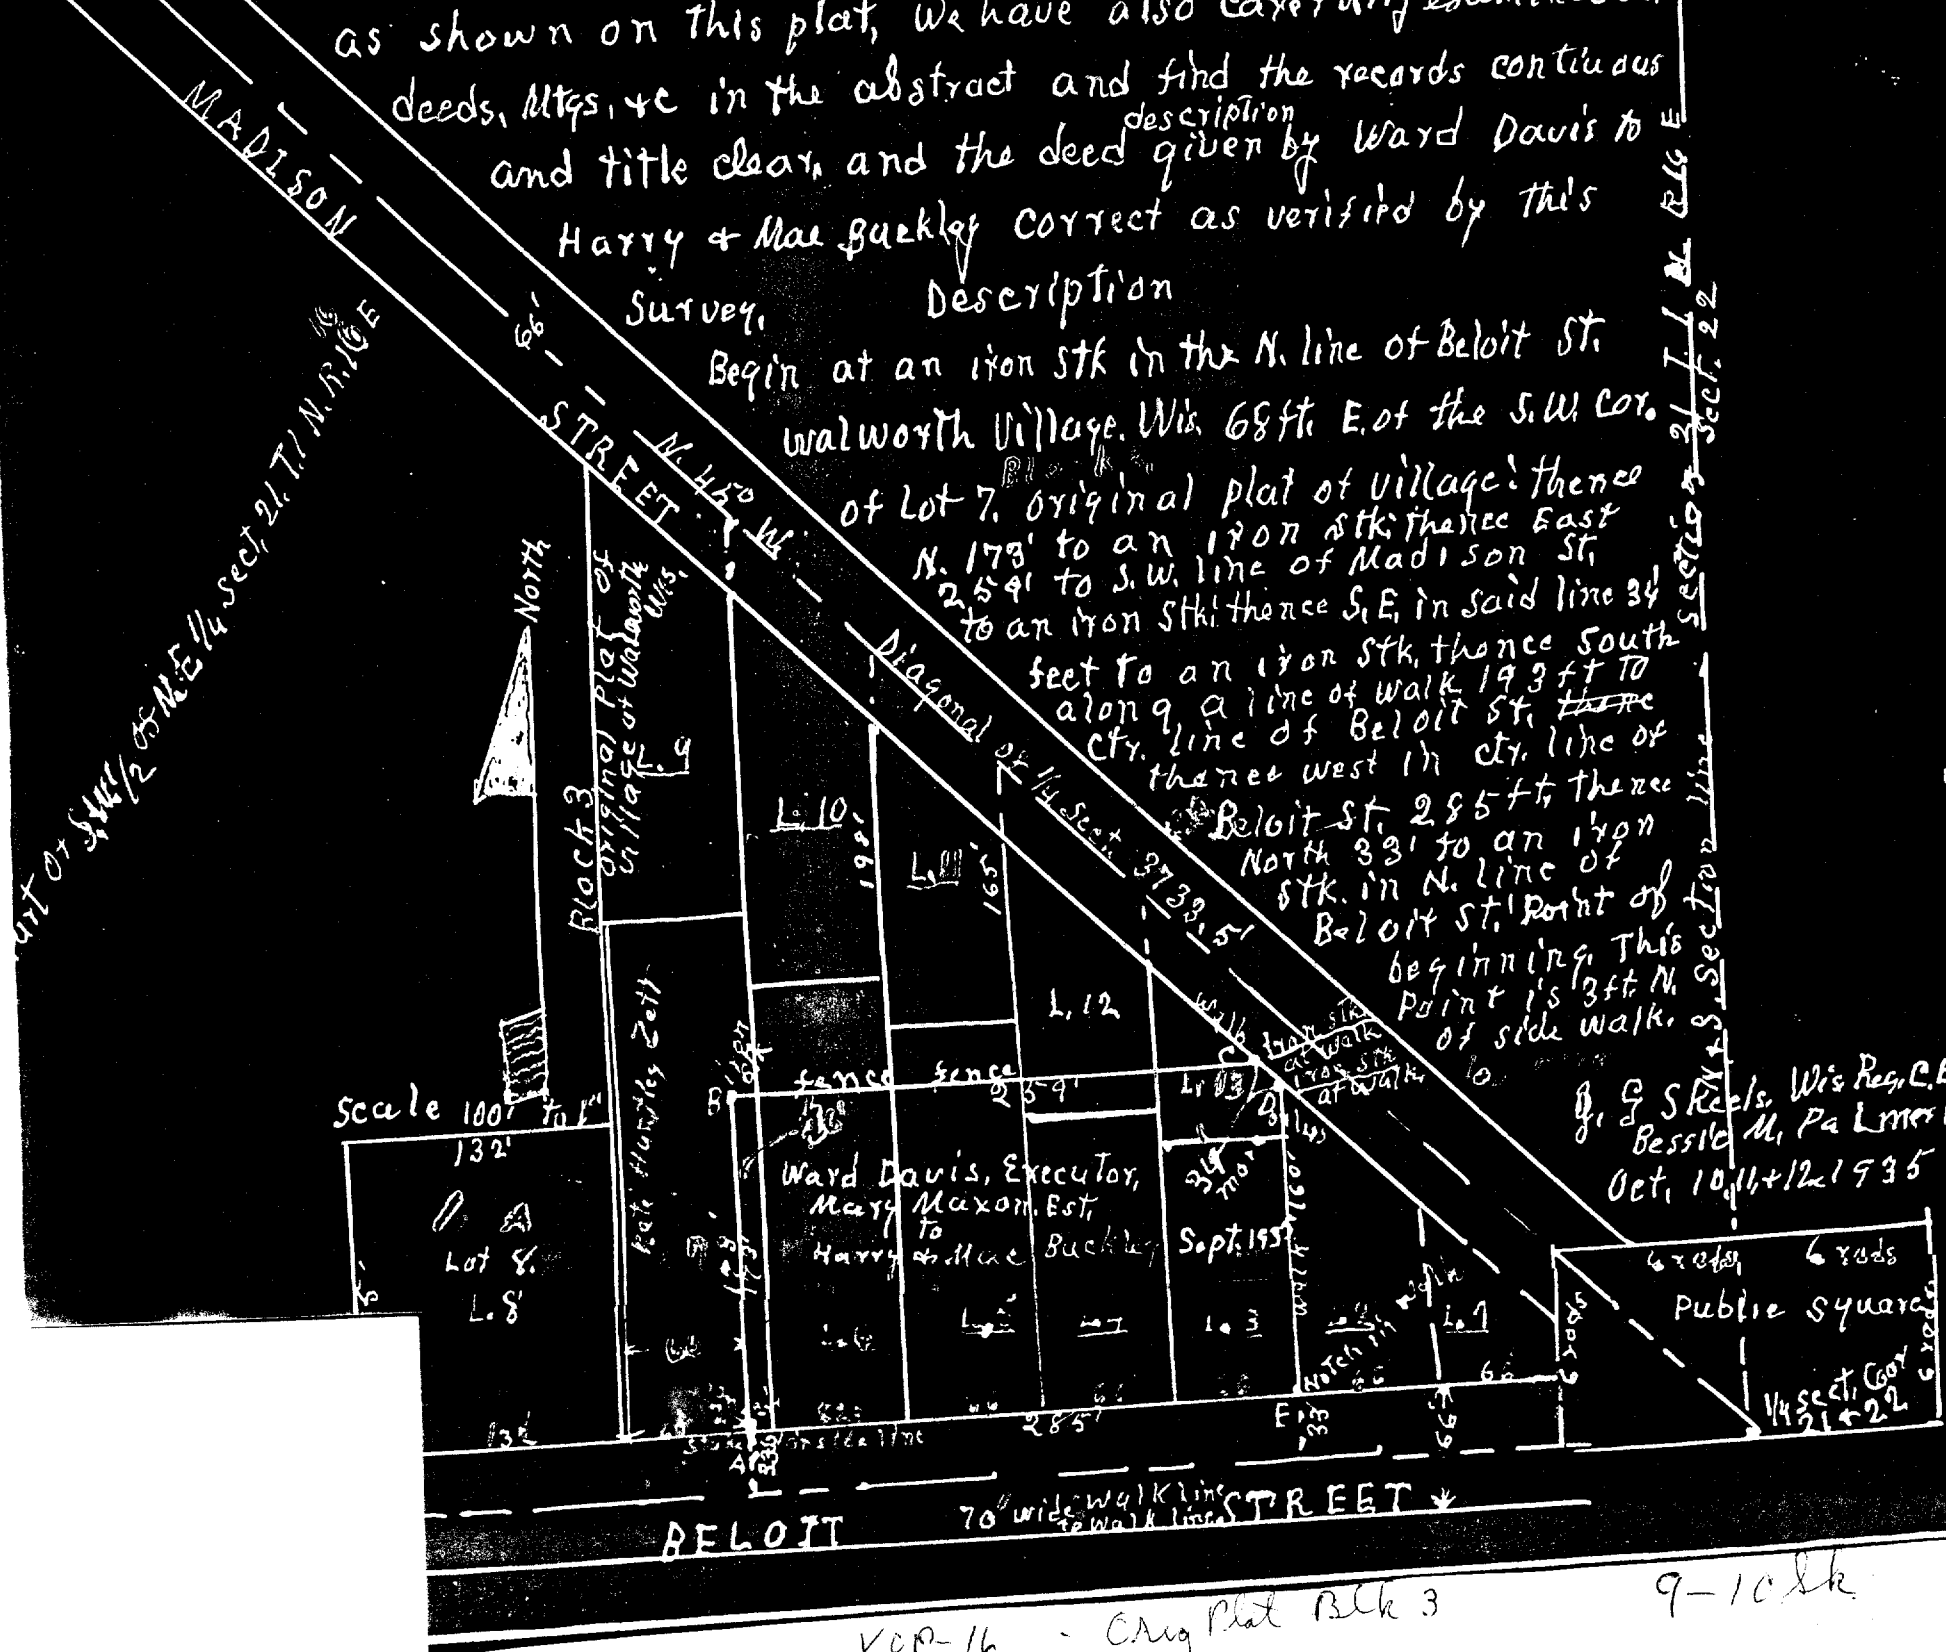

5421

Lots 1 + 2 are now
part of park and
a street not named.

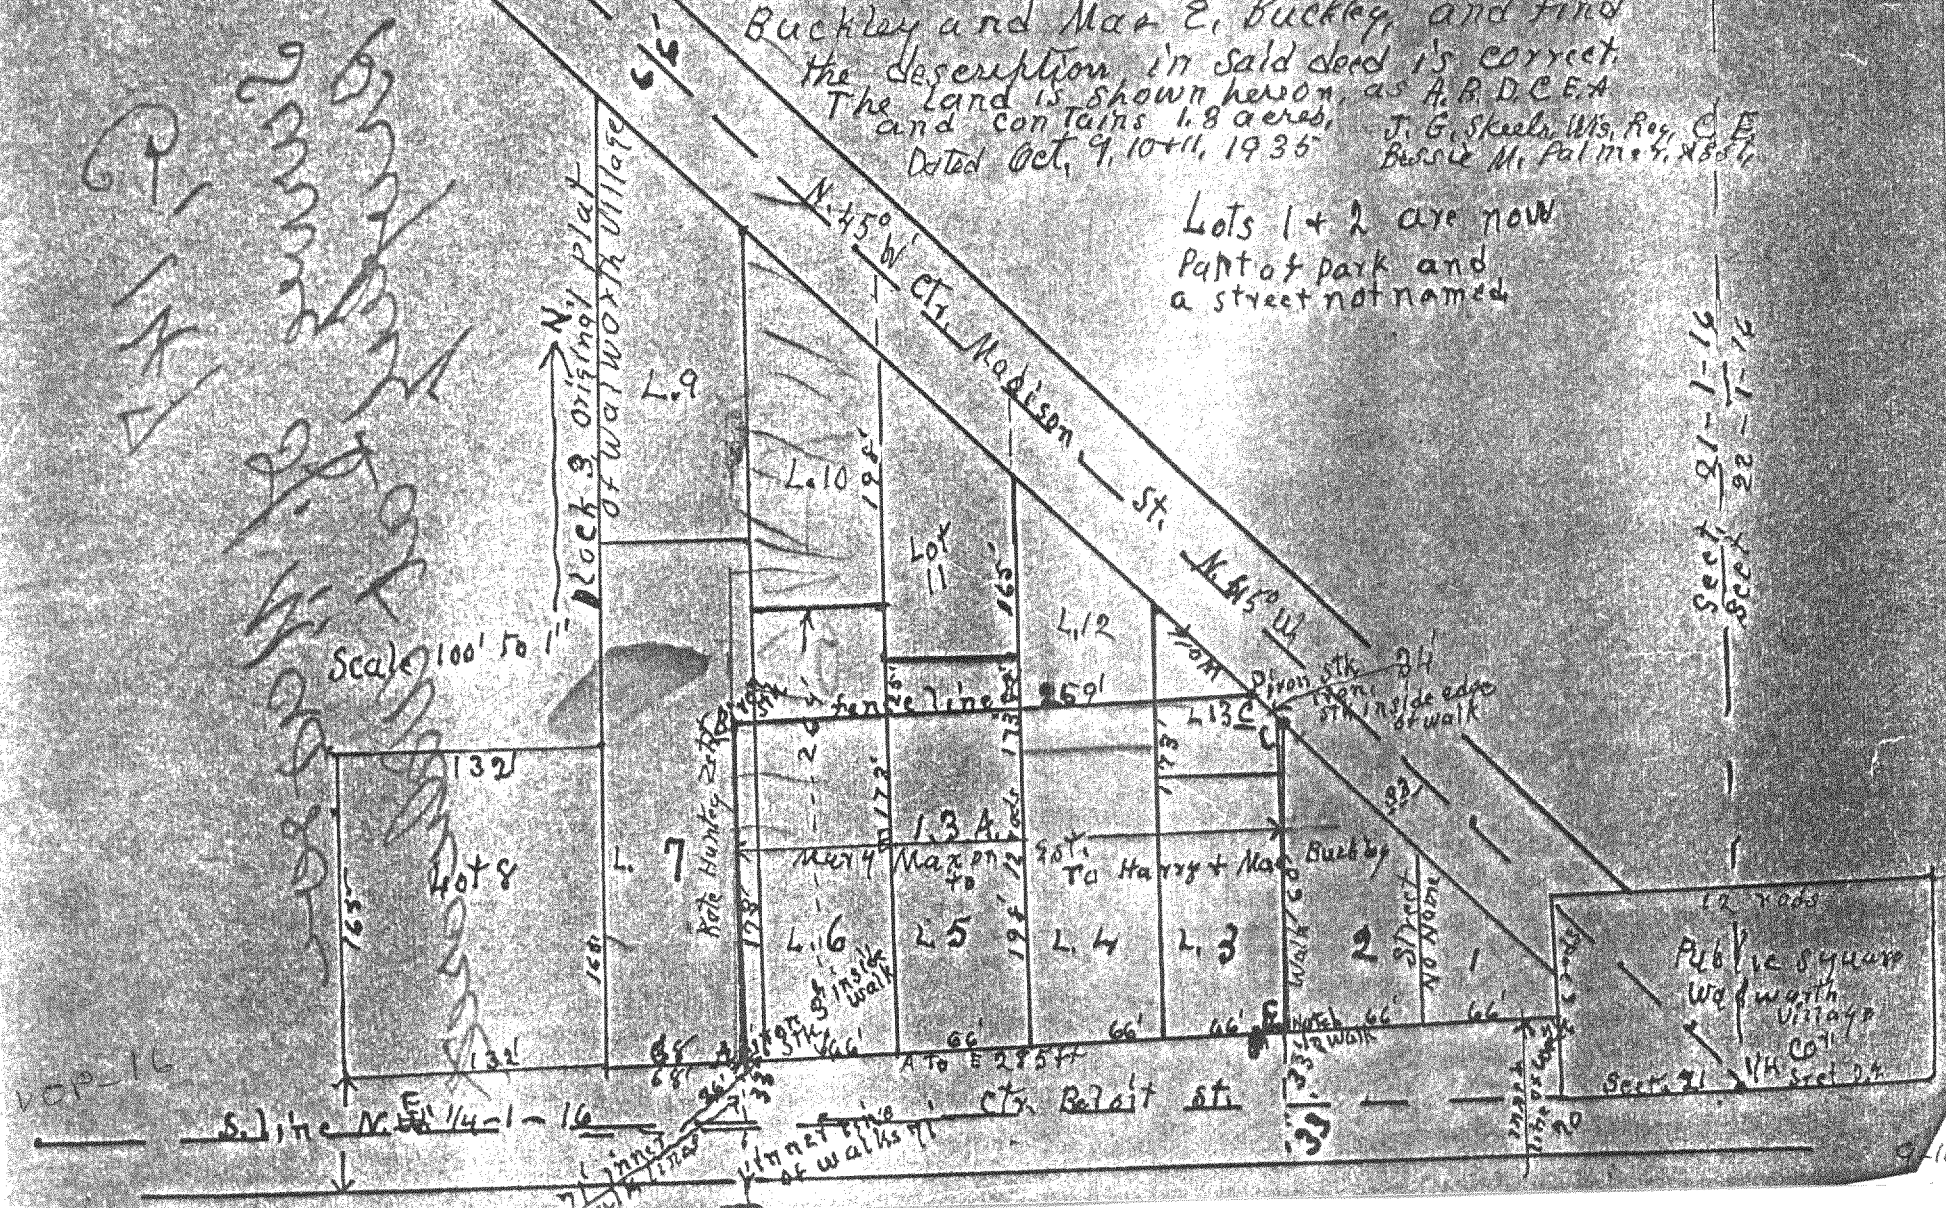

82. Walworth survey Contn
Most of the lines were
given as "more or less."
All conveyances affecting
this property in abstract
were cleared and title
was clear in grant of
Davis to Buckleys.
See plat