


**FARRIS, HANSEN & ASSOCIATES, INC.**  
ENGINEERING - ARCHITECTURE - SURVEYING  
7 RIDGWAY COURT - P.O. BOX 437 - ELKHORN, WISCONSIN 53121  
PHONE: (262) 723-2098 FAX: (262) 723-5886


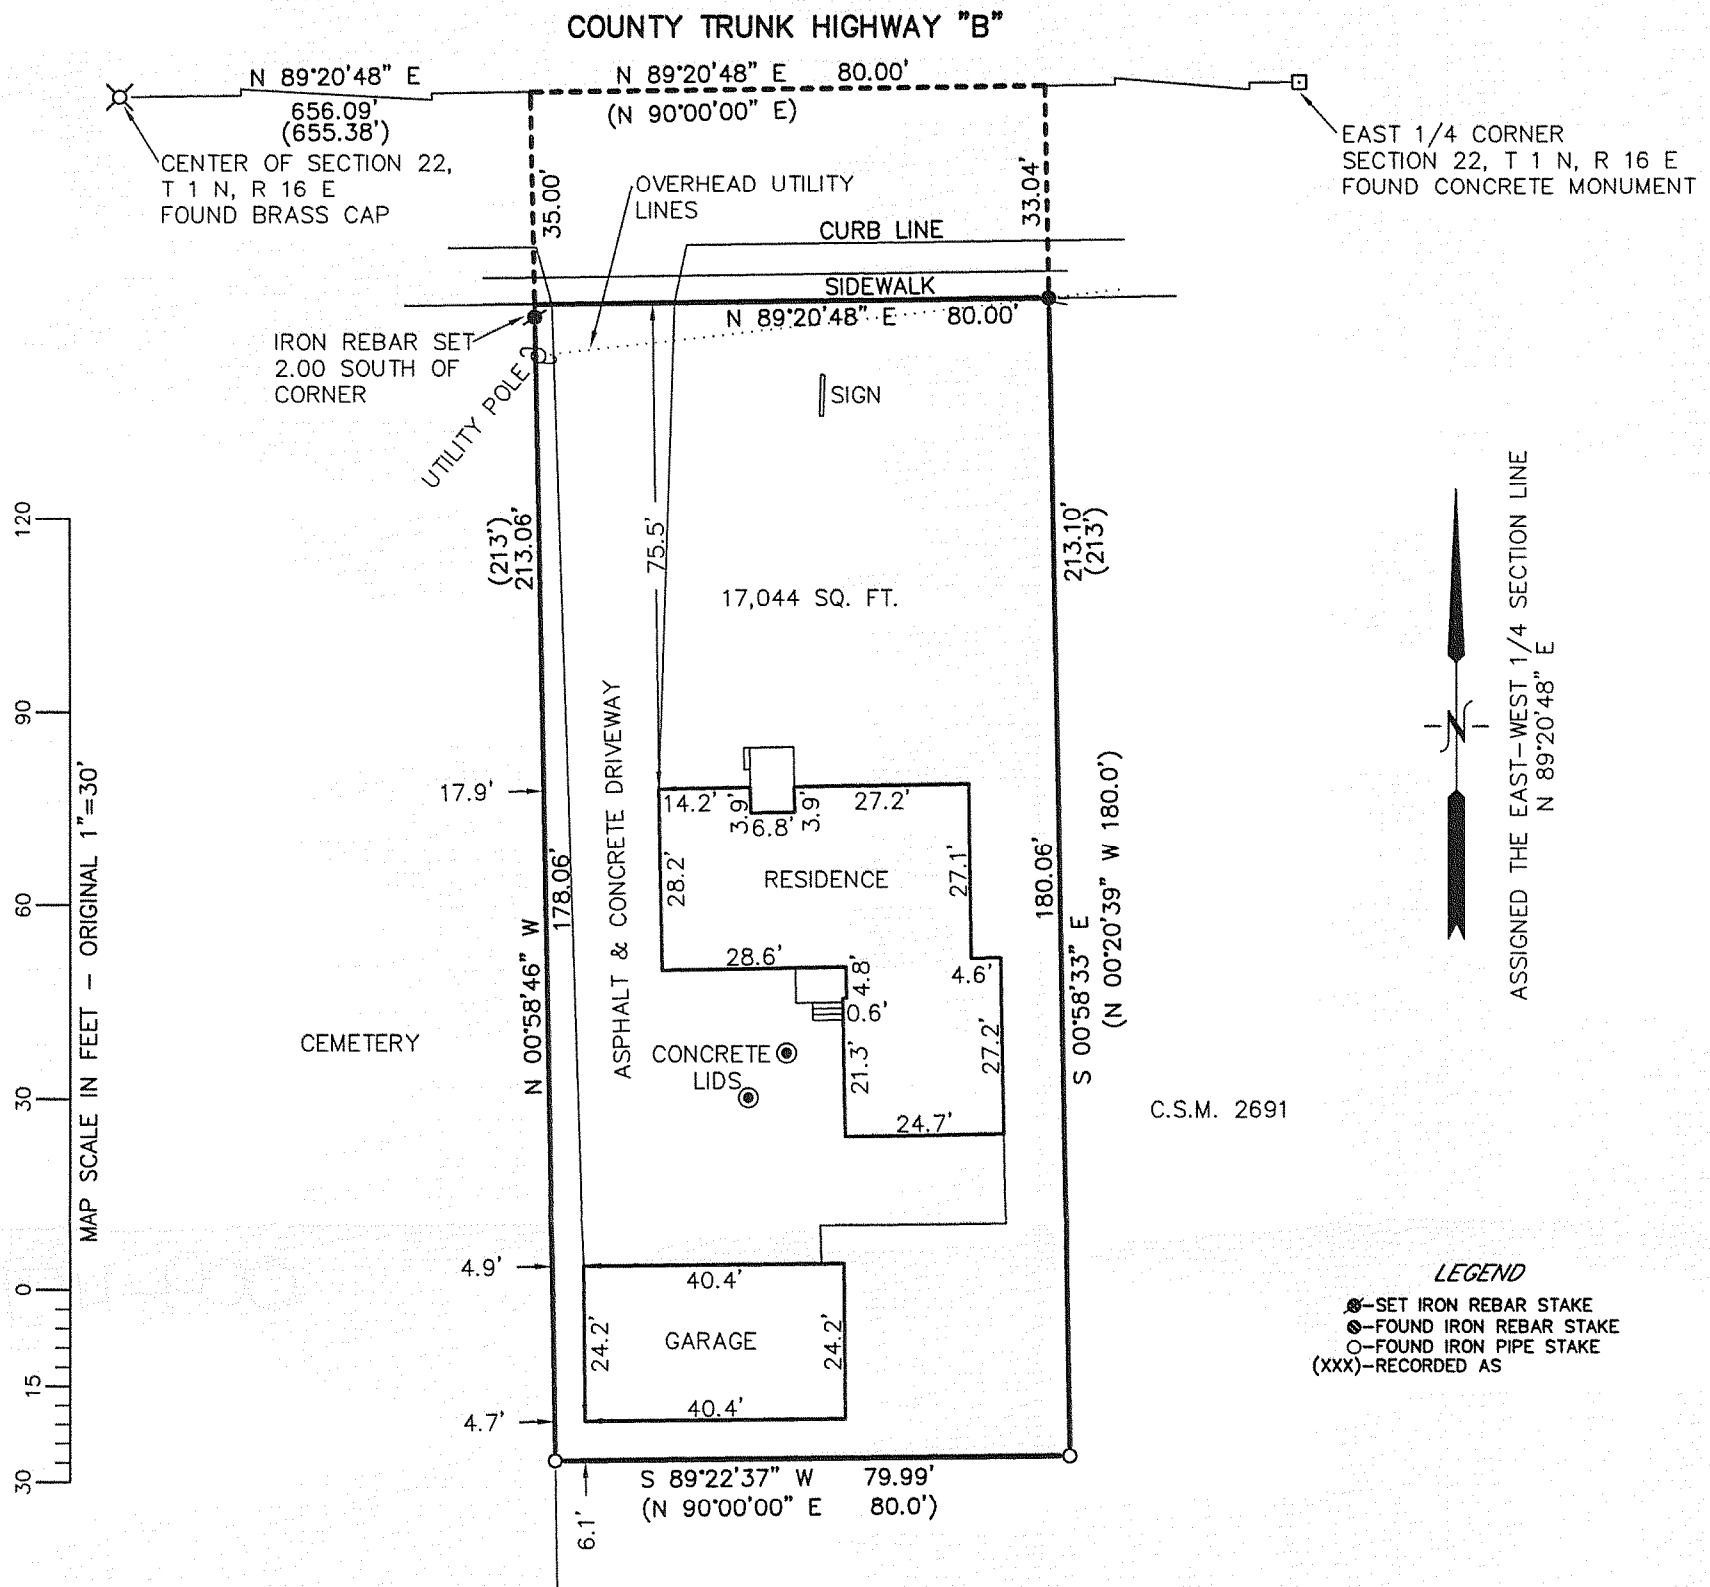


The land referred to in the Commitment is described as follows:

A parcel of land located in the Southeast 1/4 of Section 22, Town 1 North, Range 16 East, described as follows, to-wit: Commencing at the Northwest corner of said Southeast 1/4; thence Easterly along the North line of said Southeast 1/4, 655.38 feet to the place of beginning; thence Southerly along the East line of the cemetery property 213.00 feet; thence Easterly parallel with the North line of said Southeast 1/4, 80.00 feet; thence Northerly parallel with the East line of the cemetery property 213.00 feet; thence Westerly along the North line of said Southeast 1/4, 80.00 feet to the place of beginning. Said land being in the Village of Walworth, County of Walworth and State of Wisconsin.

Tax Key No. VWUP 00018

Property Address: 661 Kenosha Street

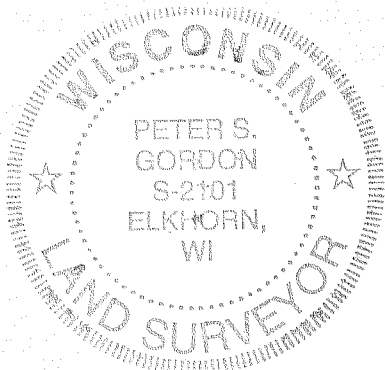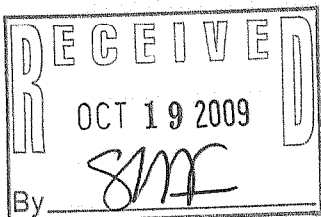

NOTE: COPIES OF THIS MAP TO WHICH THE FOLLOWING CERTIFICATE WILL APPLY SHOW THE SURVEYOR'S ORIGINAL SEAL AND SIGNATURE IN RED INK. COPIES BY ANY OTHER MEANS MAY HAVE ALTERATIONS WHICH DO NOT REPRESENT THE SURVEYOR'S WORK PRODUCT.

I HEREBY CERTIFY THAT THE ABOVE DESCRIBED PROPERTY HAS BEEN SURVEYED UNDER MY DIRECTION AND THAT THE ABOVE MAP IS A TRUE REPRESENTATION THEREOF AND SHOWS THE SIZE AND LOCATION OF THE PROPERTY, ITS EXTERIOR BOUNDARIES, THE LOCATION OF ALL VISIBLE STRUCTURES, AND DIMENSIONS OF ALL PRINCIPLE BUILDINGS THEREON, BOUNDARY FENCES, APPARENT EASEMENTS, ROADWAYS, AND VISIBLE ENCROACHMENTS, IF ANY. THIS SURVEY IS MADE FOR THE USE OF THE PRESENT OWNERS OF THE PROPERTY, AND ALSO THOSE WHO PURCHASE, MORTGAGE, OR GUARANTEE THE TITLE THERETO WITHIN ONE YEAR FROM THE DATE HEREOF.

DATED: 8/10/2009

*Peter S. Gordon*  
PETER S. GORDON

PROJECT: 7958  
DATE: 08/10/2009  
SHEET 1 OF 1

AUG 11 2009 VWUP-18

009-1101