

# FARRIS, HANSEN & ASSOC. INC.

7 RIDGWAY COURT- P.O. BOX 437  
ELKHORN, WISCONSIN 53121  
PHONE (262) 723-2098  
FAX (262) 723-5886  
WORK ORDERED BY:  
HARRY & CAROL VANDYKE  
C/O THE RAULAND AGENCY  
118 KENOSHA STREET/PO BOX 159  
WALWORTH, WISCONSIN 53184



## PLAT OF SURVEY

LOTS 1 & 2 OF CERTIFIED SURVEY MAP NO. 3577

RECORDED AS DOCUMENT NO. 567629  
BEING LOT 7 OF FOX LANE SUBDIVISION  
LOCATED IN PART OF THE SW 1/4 OF THE SW 1/4 OF  
SECTION 15, TOWN 1 NORTH, RANGE 16 EAST,  
VILLAGE OF WALWORTH, WALWORTH COUNTY, WISCONSIN

### LEGEND

- = FOUND IRON REBAR STAKE, 3/4" DIA.
- (XXX) = RECORDED AS

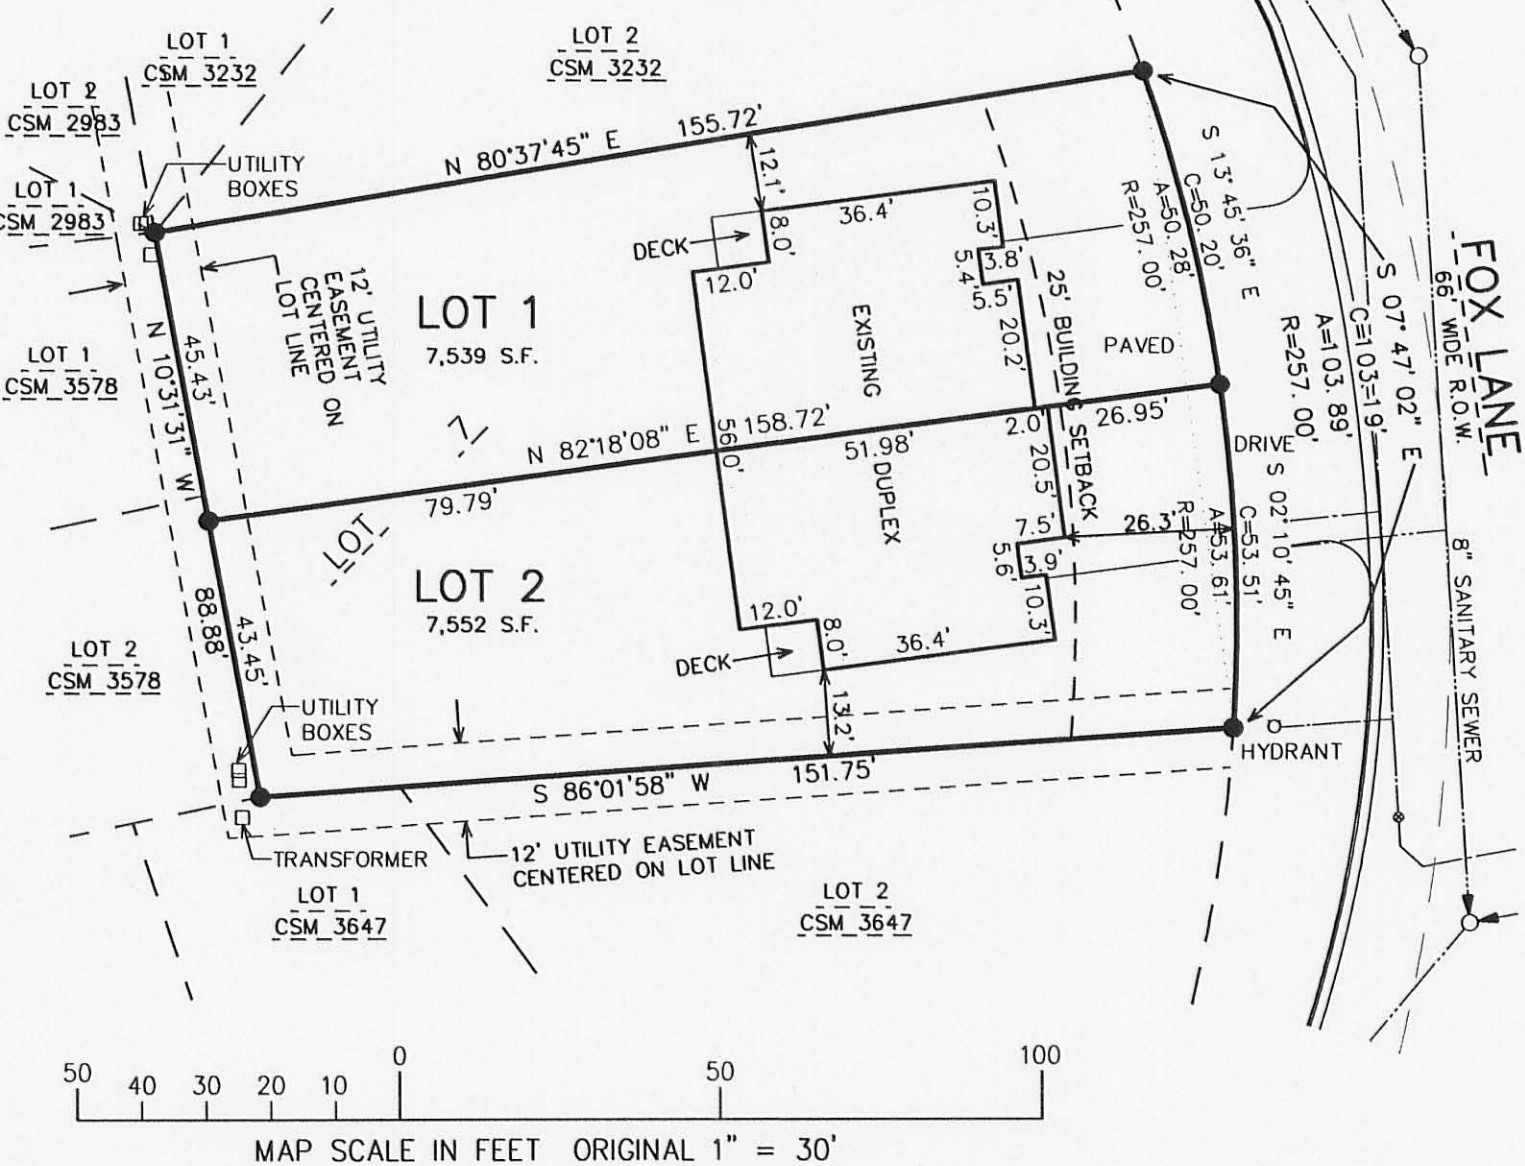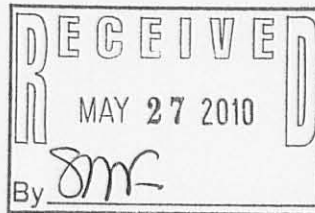

NOTE: COPIES OF THIS MAP TO WHICH THE FOLLOWING CERTIFICATE WILL APPLY SHOW THE SURVEYOR'S ORIGINAL SEAL AND SIGNATURE IN RED INK. COPIES BY ANY OTHER MEANS MAY HAVE ALTERATIONS WHICH DO NOT REPRESENT THE SURVEYOR'S WORK PRODUCT.

I HEREBY CERTIFY THAT THE ABOVE DESCRIBED PROPERTY HAS BEEN SURVEYED UNDER MY DIRECTION AND THAT THE ABOVE MAP IS A TRUE REPRESENTATION THEREOF AND SHOWS THE SIZE AND LOCATION OF THE PROPERTY, ITS EXTERIOR BOUNDARIES, THE LOCATION OF ALL VISIBLE STRUCTURES, AND DIMENSIONS OF ALL PRINCIPLE BUILDINGS THEREON, BOUNDARY FENCES, APPARENT EASEMENTS, ROADWAYS, AND VISIBLE ENCROACHMENTS, IF ANY. THIS SURVEY IS MADE FOR THE USE OF THE PRESENT OWNERS OF THE PROPERTY, AND ALSO THOSE WHO PURCHASE, MORTGAGE, OR GUARANTEE THE TITLE THERETO WITHIN ONE YEAR FROM THE DATE HEREOF.

DATED: APRIL 22, 2010

*Peter S. Gordon*  
PETER S. GORDON



THIS INSTRUMENT DRAFTED  
BY PETER S. GORDON  
PROJECT NO. 4039.07.10  
DATED: 4/22/2010  
SHEET 1 OF 1 SHEETS

VA3577-1  
APR 27 2010 VA3577-2

009-1110