

LAND-MARK SURVEYING

Mark L. Miritz

Wisconsin Registered Land Surveyor S-2582


N9330 Knutecon Drive
Whitewater, WI 53190
Phone: (262) 495-3284
MARKMIRITZ@
LAND-MARKSURVEYING.COM

PLAT OF SURVEY

THE EAST 66 FEET OF LOT 14 OF CLARKE'S SECOND ADDITION TO THE VILLAGE OF WALWORTH, EXCEPT THE NORTH 66 FEET THEREOF, LOCATED IN THE SOUTHWEST 1/4 OF SECTION 22, TOWN 1 NORTH, RANGE 16 EAST, VILLAGE OF WALWORTH, WALWORTH COUNTY, WISCONSIN

ORDERED BY: BECKY MERWIN
THE RAULAND AGENCY
118 KENOSHA STREET
WALWORTH, WI 53184

THE SOUTH LINE OF LOT 14
WAS ASSUMED TO BEAR
S 88°47'25" E AS PER C.S.M.

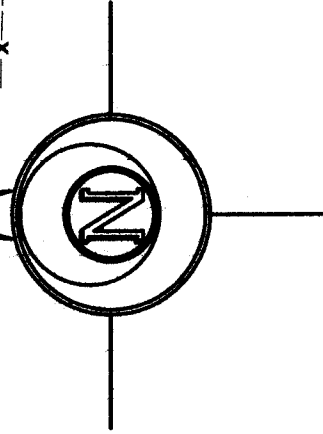

TAX PARCEL NO. VCA2 00017

TAX PARCEL NO. VCA2 00018
10,995 SQ. FT.

TAX PARCEL NO. VCA2 00016A


TAX PARCEL NO. VCA2 00019

TAX PARCEL NO. VCA2 00021

C.S.M. NO. 1948


N 00°00'33" W 166.50'

FENCE CORNER
0.11' WEST OF LINE

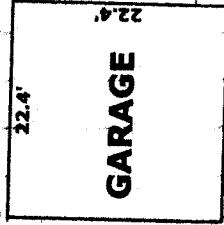

GARAGE

CONCRETE

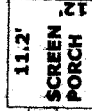

SCREEN PORCH

RESIDENCE

212 DEVILS LANE

DRIVE



DECK

SOUTHWEST CORNER
LOT 14

FOUND IRON ROD BENT
N 75°06'23" W 0.24'
FROM CORNER

177.15'

S 88°47'25" E 486.00'

SOUTHEAST CORNER
LOT 14

FOUND IRON PIPE ON LINE
& 0.15' NORTH OF CORNER

(242.83')

SOUTHEAST CORNER
LOT 15

DEVILS LANE


(30' WIDE)

LEGEND

- FOUND IRON PIPE
- FOUND IRON ROD
- FOUND CONCRETE MONUMENT
- (x x) RECORDED AS DIMENSION
- x-x- EXISTING FENCE

SCALE: 1 INCH = 20 FEET

"I hereby certify that the above described property has been surveyed by me or under my direction and that the above map is a true representation thereof and shows the size and location of the property, its exterior boundaries, the location of all visible structures and dimensions of all principal buildings thereon, boundary fences, apparent easements, roadways and visible encroachments, if any." "This survey is made for the use of the present owners of the property, and also those who purchase, mortgage, or guarantee the title thereto within one year from date hereof."

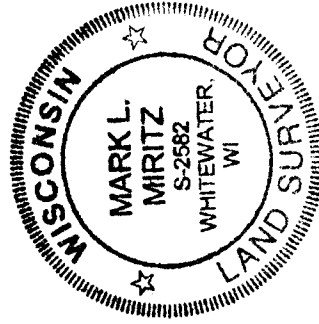

DEC 1 2 2013

Mark L. Miritz
MARK L. MIRITZ
WISCONSIN REGISTERED
LAND SURVEYOR S-2582

VCA2 -18

009-1172

DATE: DEC. 6, 2013

JOB NO. 13.1202