


LAND-MARK SURVEYING
Mark L. Miritz
Wisconsin Registered Land Surveyor S-2582

N9330 Knuteson Drive
Whitewater, WI 53190
Phone: (262) 495-3284
MARKMIRITZ@
LAND-MARKSURVEYING.COM



ORDERED BY: HARRY MOHR
RAULAND AGENCY INC.
118 KENOSHA STREET
WALWORTH, WI 53184

PLAT OF SURVEY

LOT 37 OF OAK KNOLLS OF WALWORTH ADDITION NO. 1, BEING A RESUBDIVISION OF OUTLOT NO. 1 OF OAK KNOLLS OF WALWORTH, LOCATED IN PART OF THE SOUTHEAST 1/4 OF THE SOUTHEAST 1/4 OF SECTION 22, TOWN 1 NORTH, RANGE 16 EAST, VILLAGE OF WALWORTH, WALWORTH COUNTY, WISCONSIN.

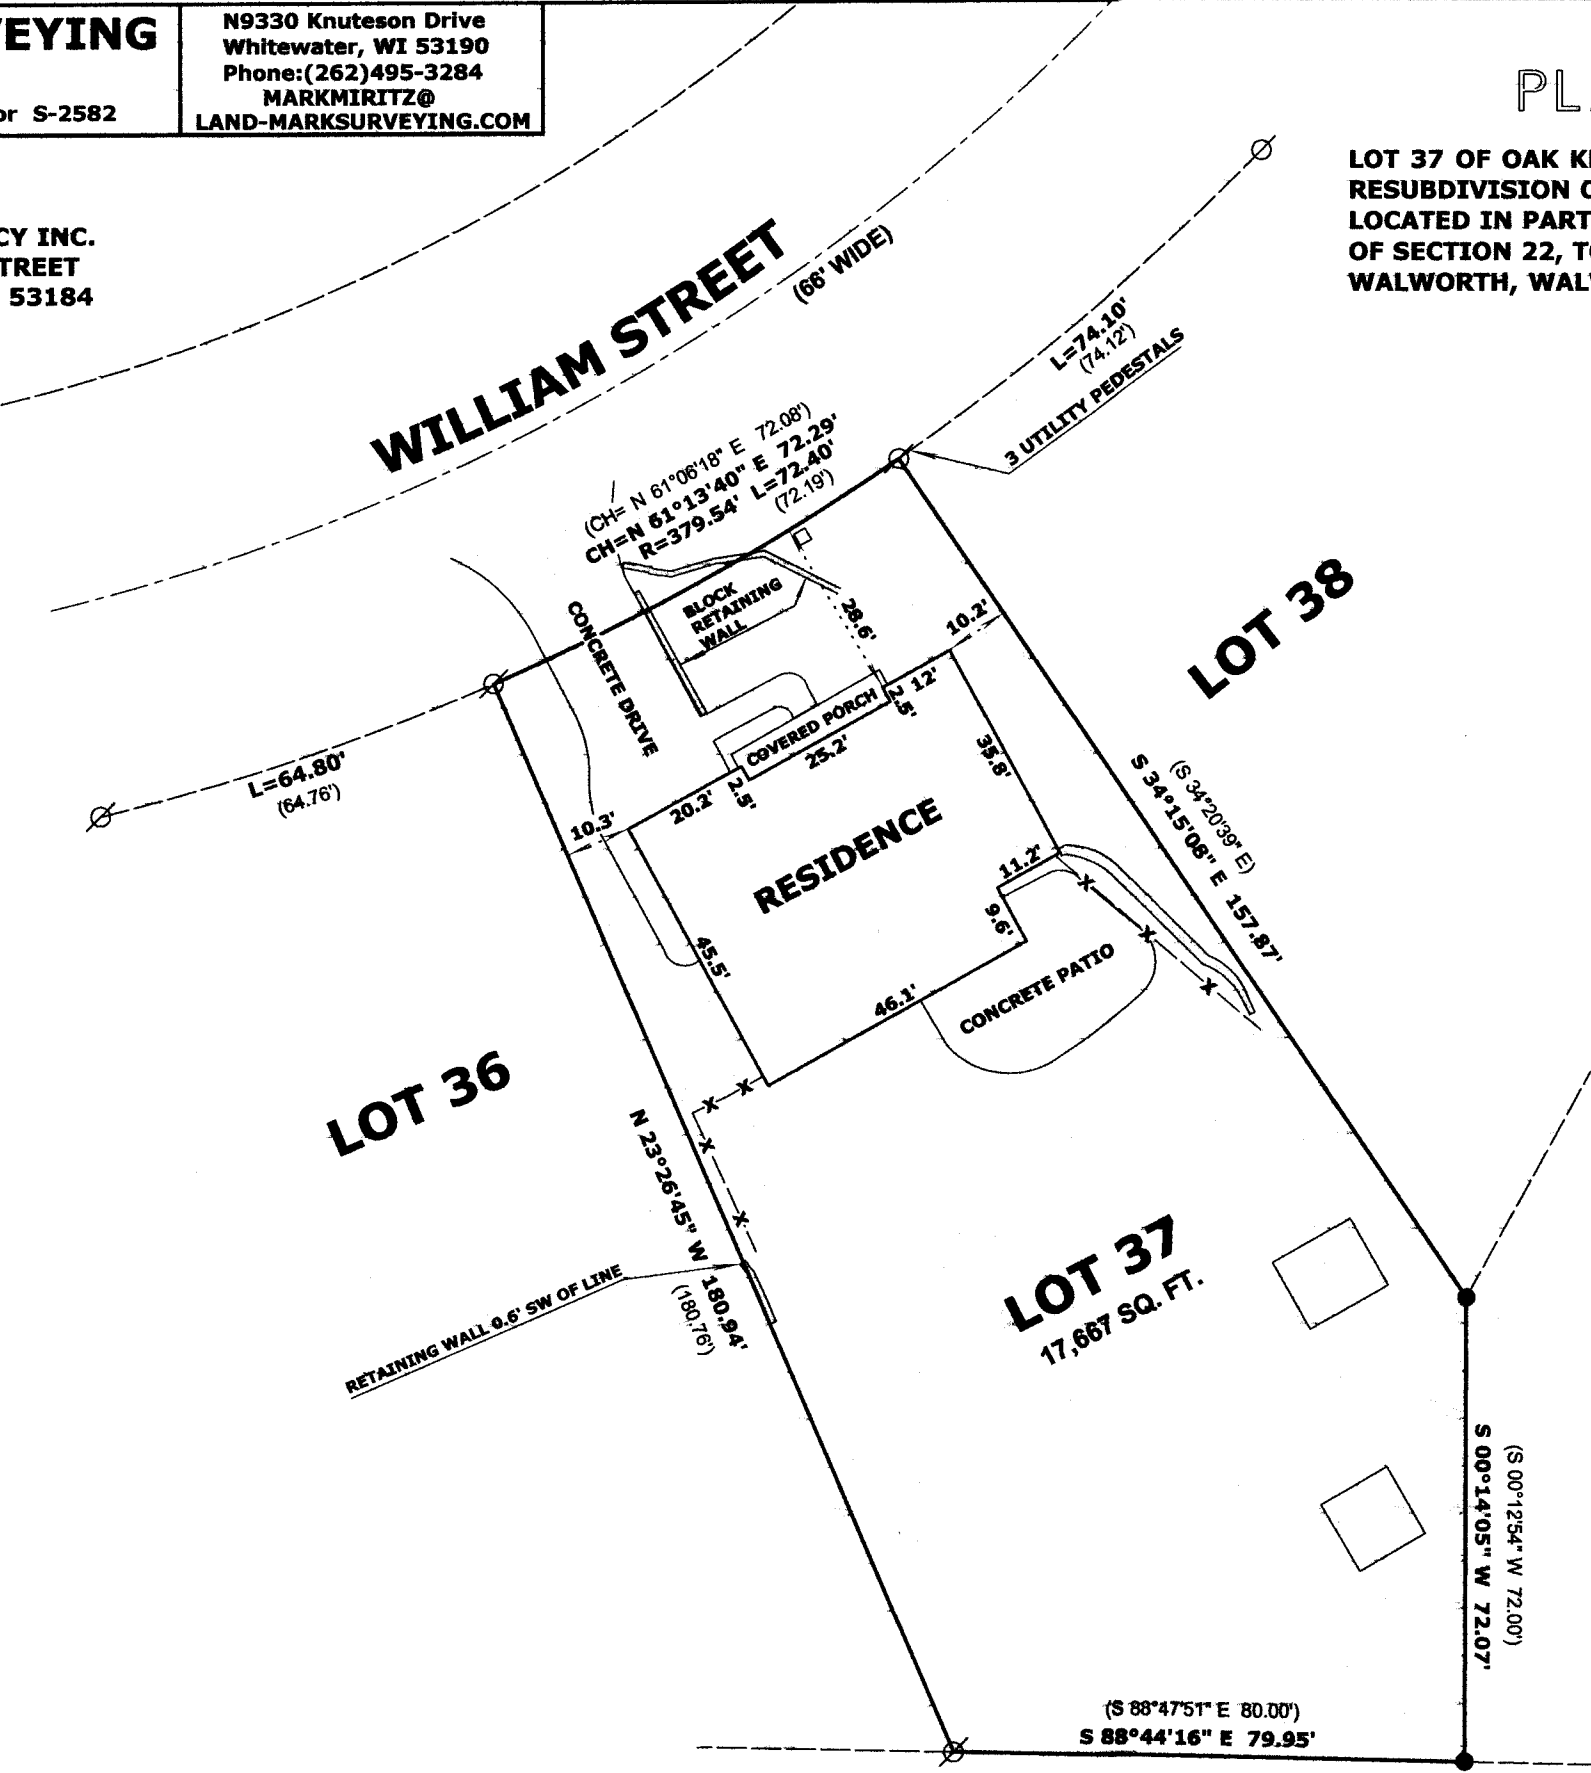

RECEIVED
APR 16 2014
By *gjc*

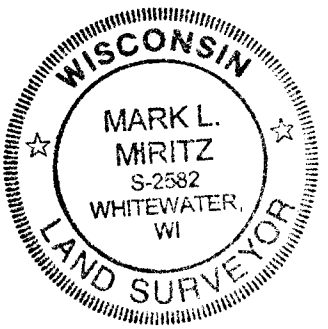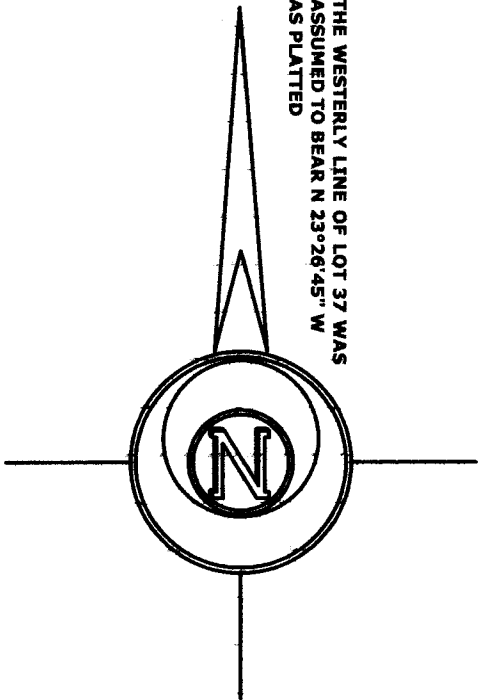

LOT 40

VOK1 -10

009-1175